


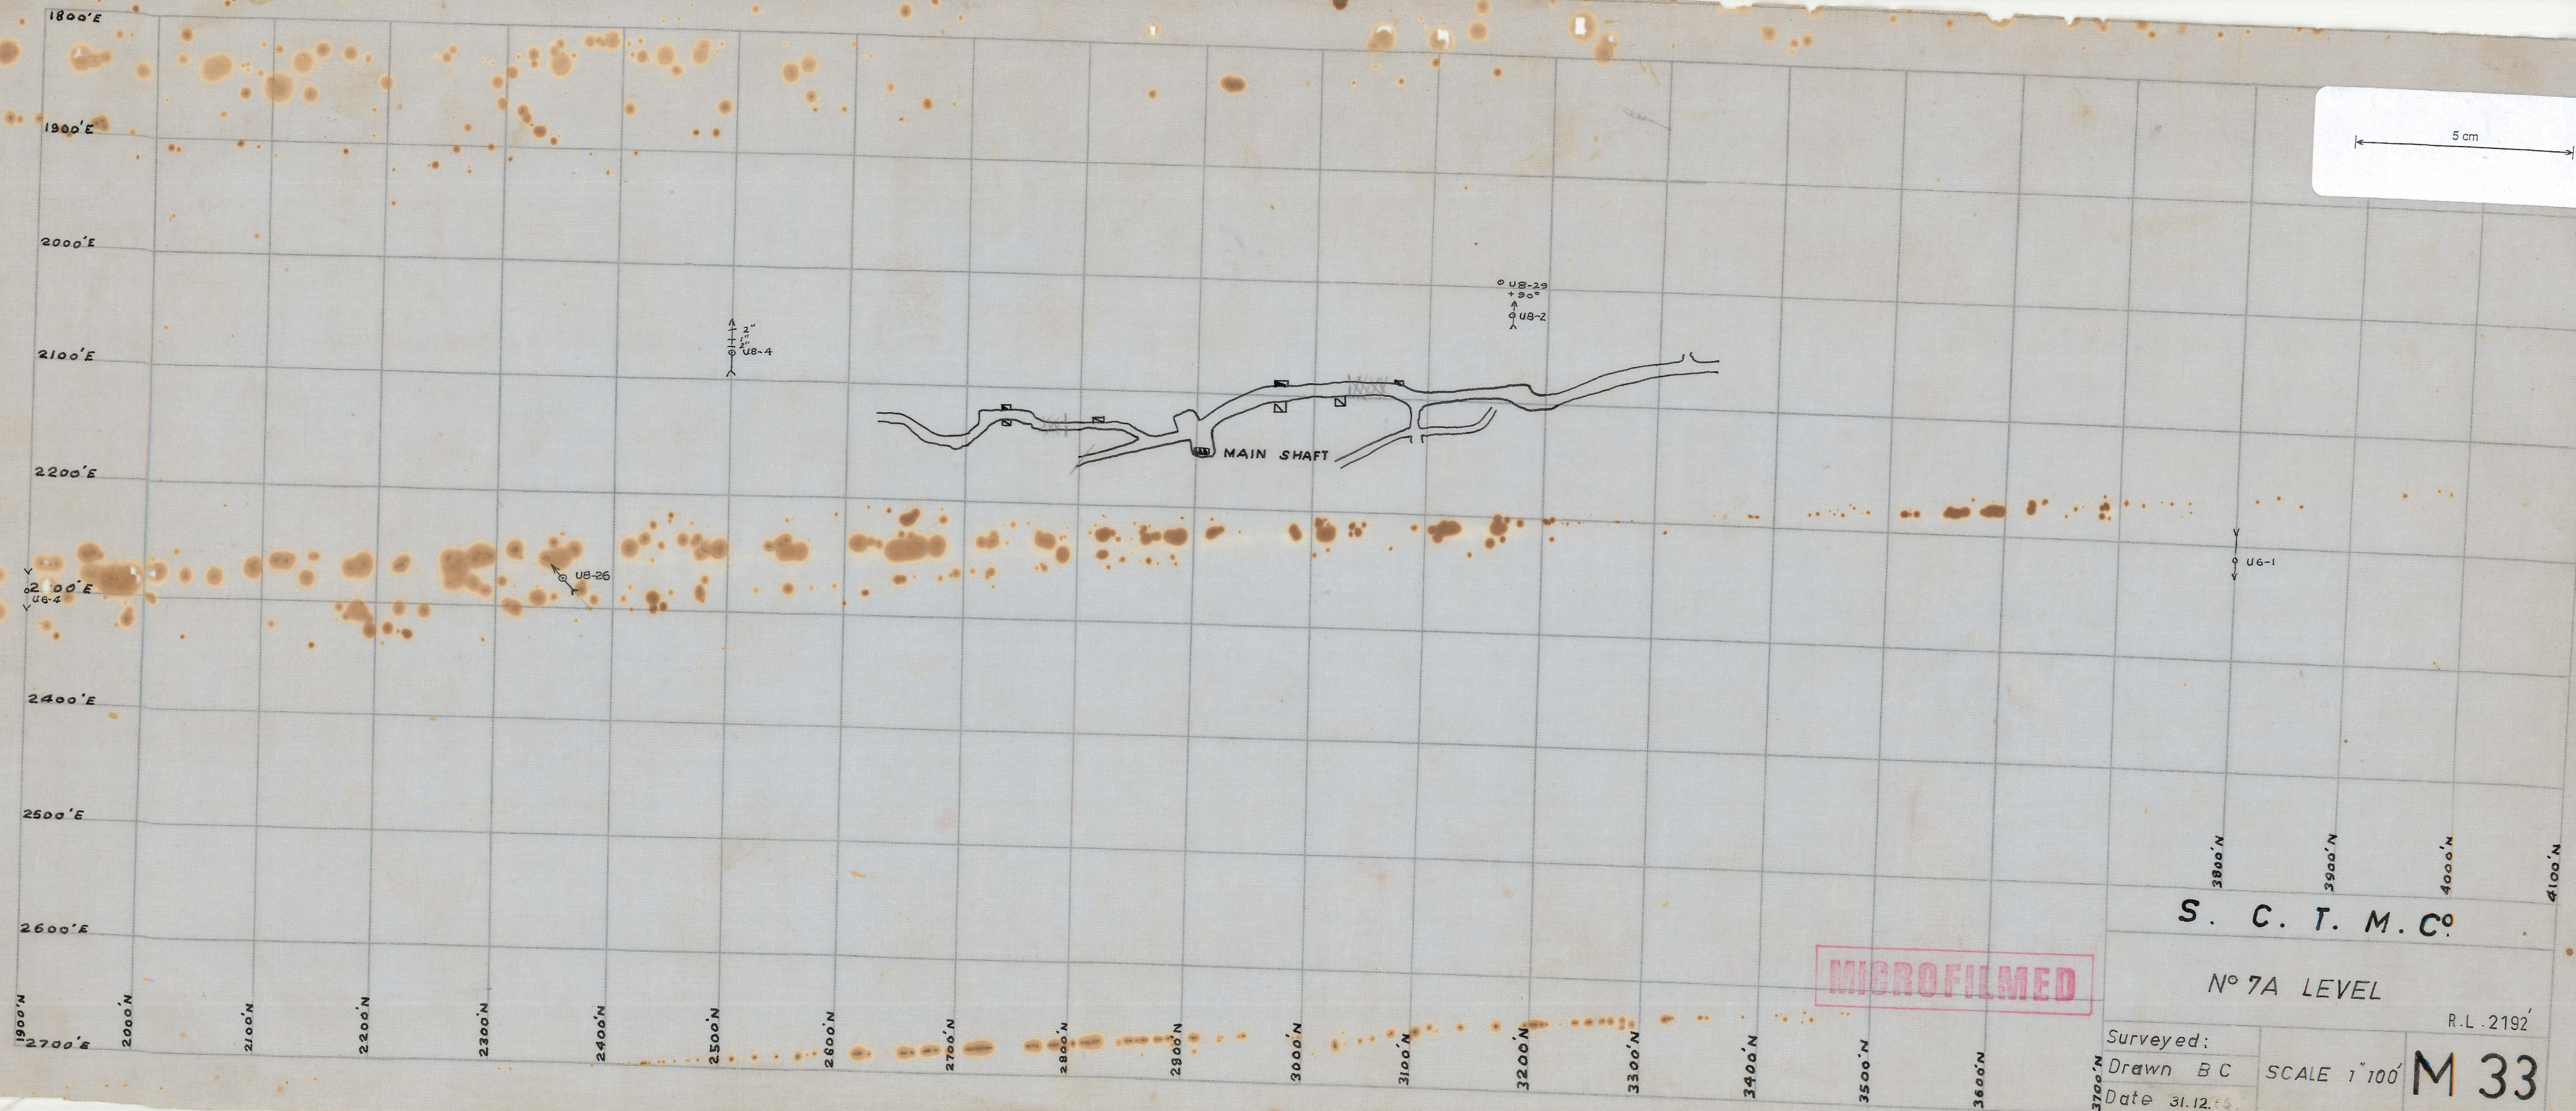

S. C. T. M. C.

Nº 7A LEVEL

R.L. 2192'

Surveyed:
Drawn B.C.
Date 31.12.64

SCALE 1"=100'

M 33

82264

ABERF - 636