


ABEF - 644

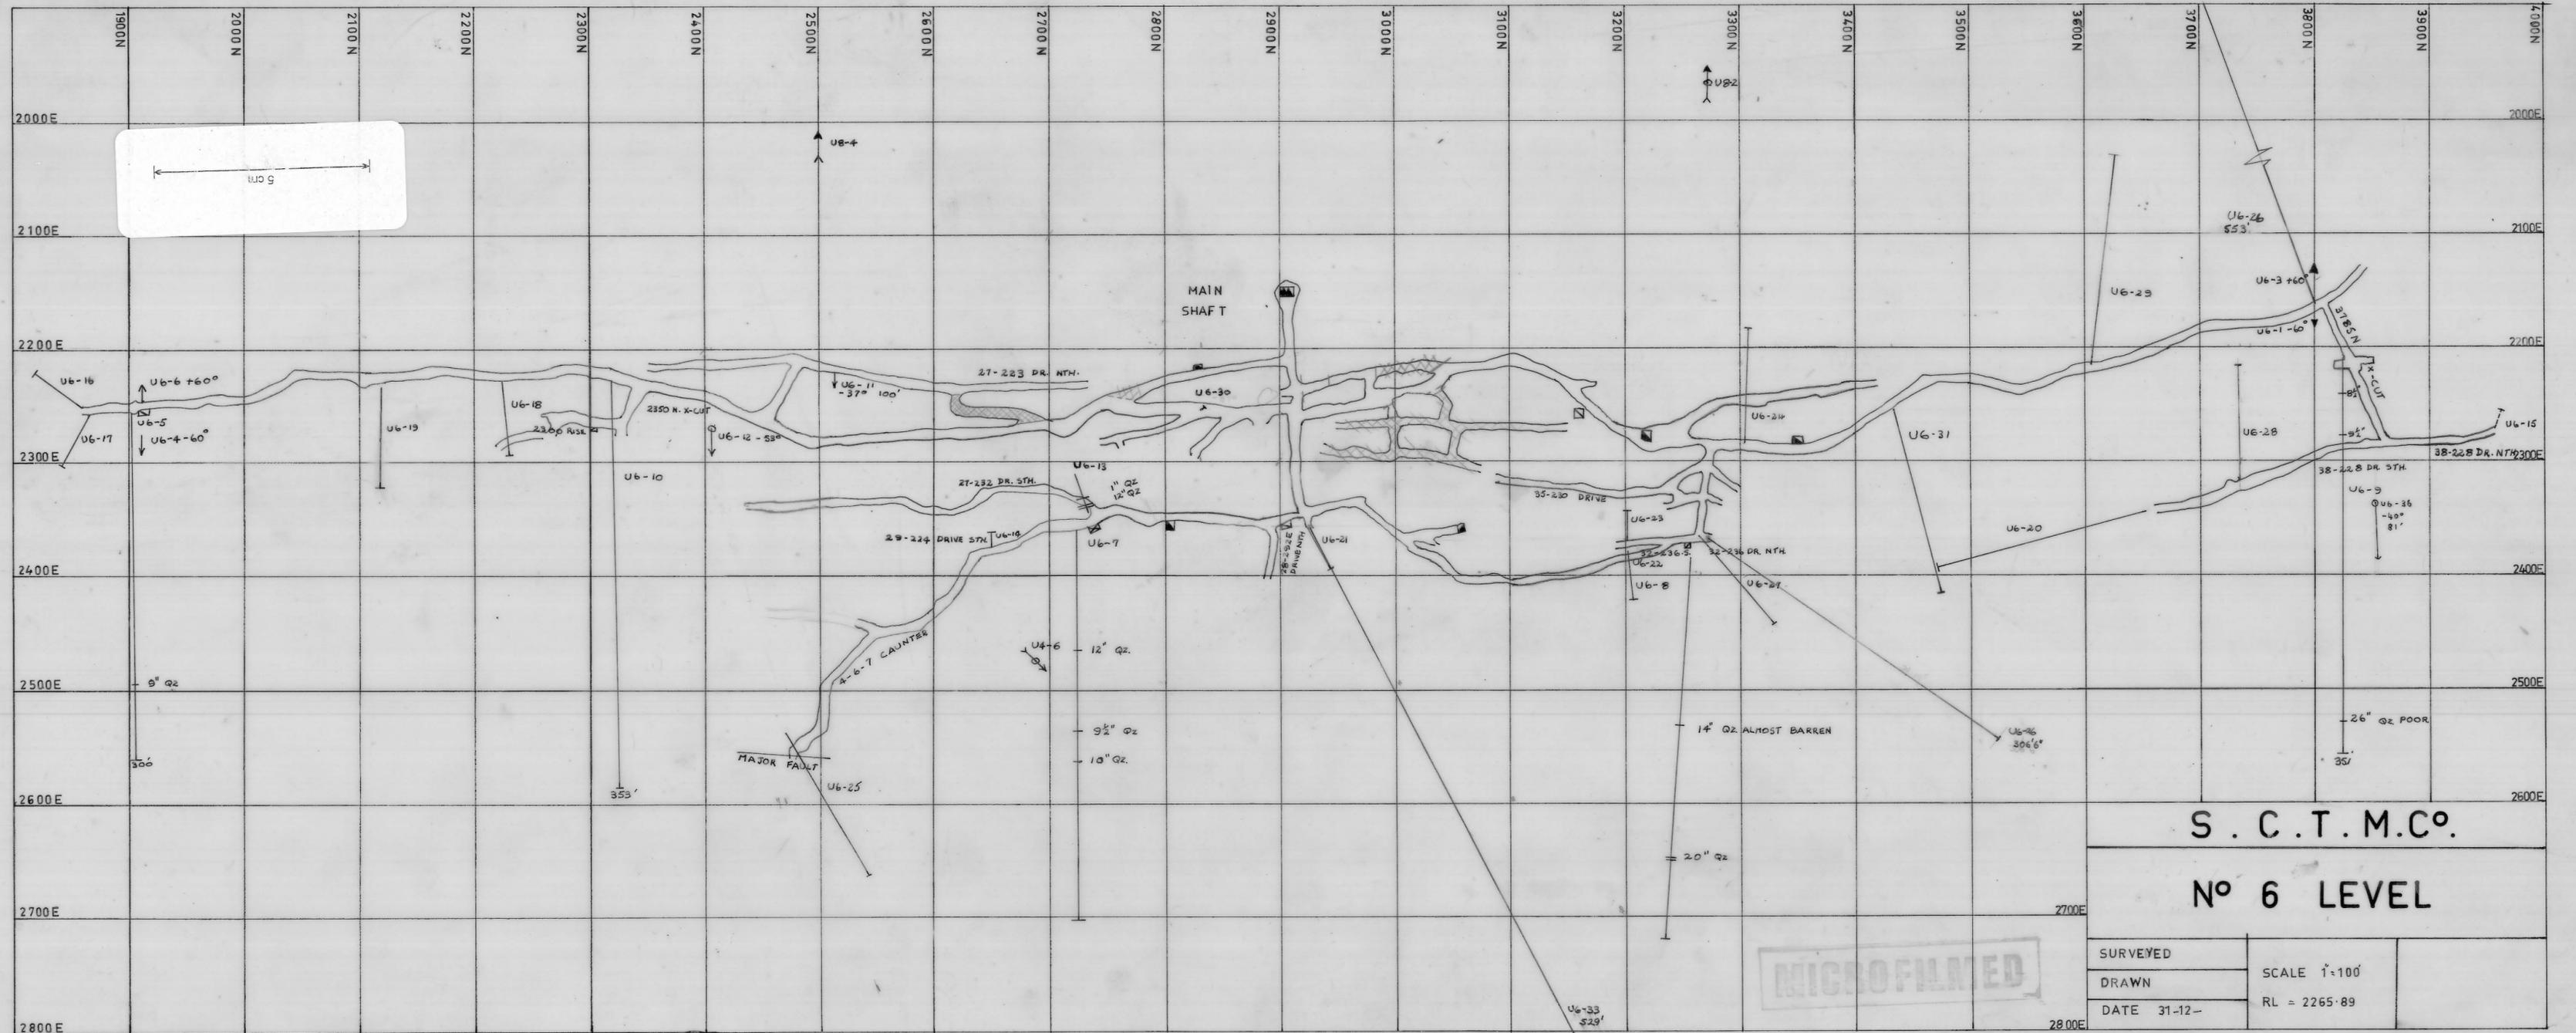

S. C. T. M. C. O.
 No. 6 LEVEL

SURVEYED	SCALE 1"=100'
DRAWN	RL = 2265.89
DATE 31-12-	

MICROFILMED

82261