
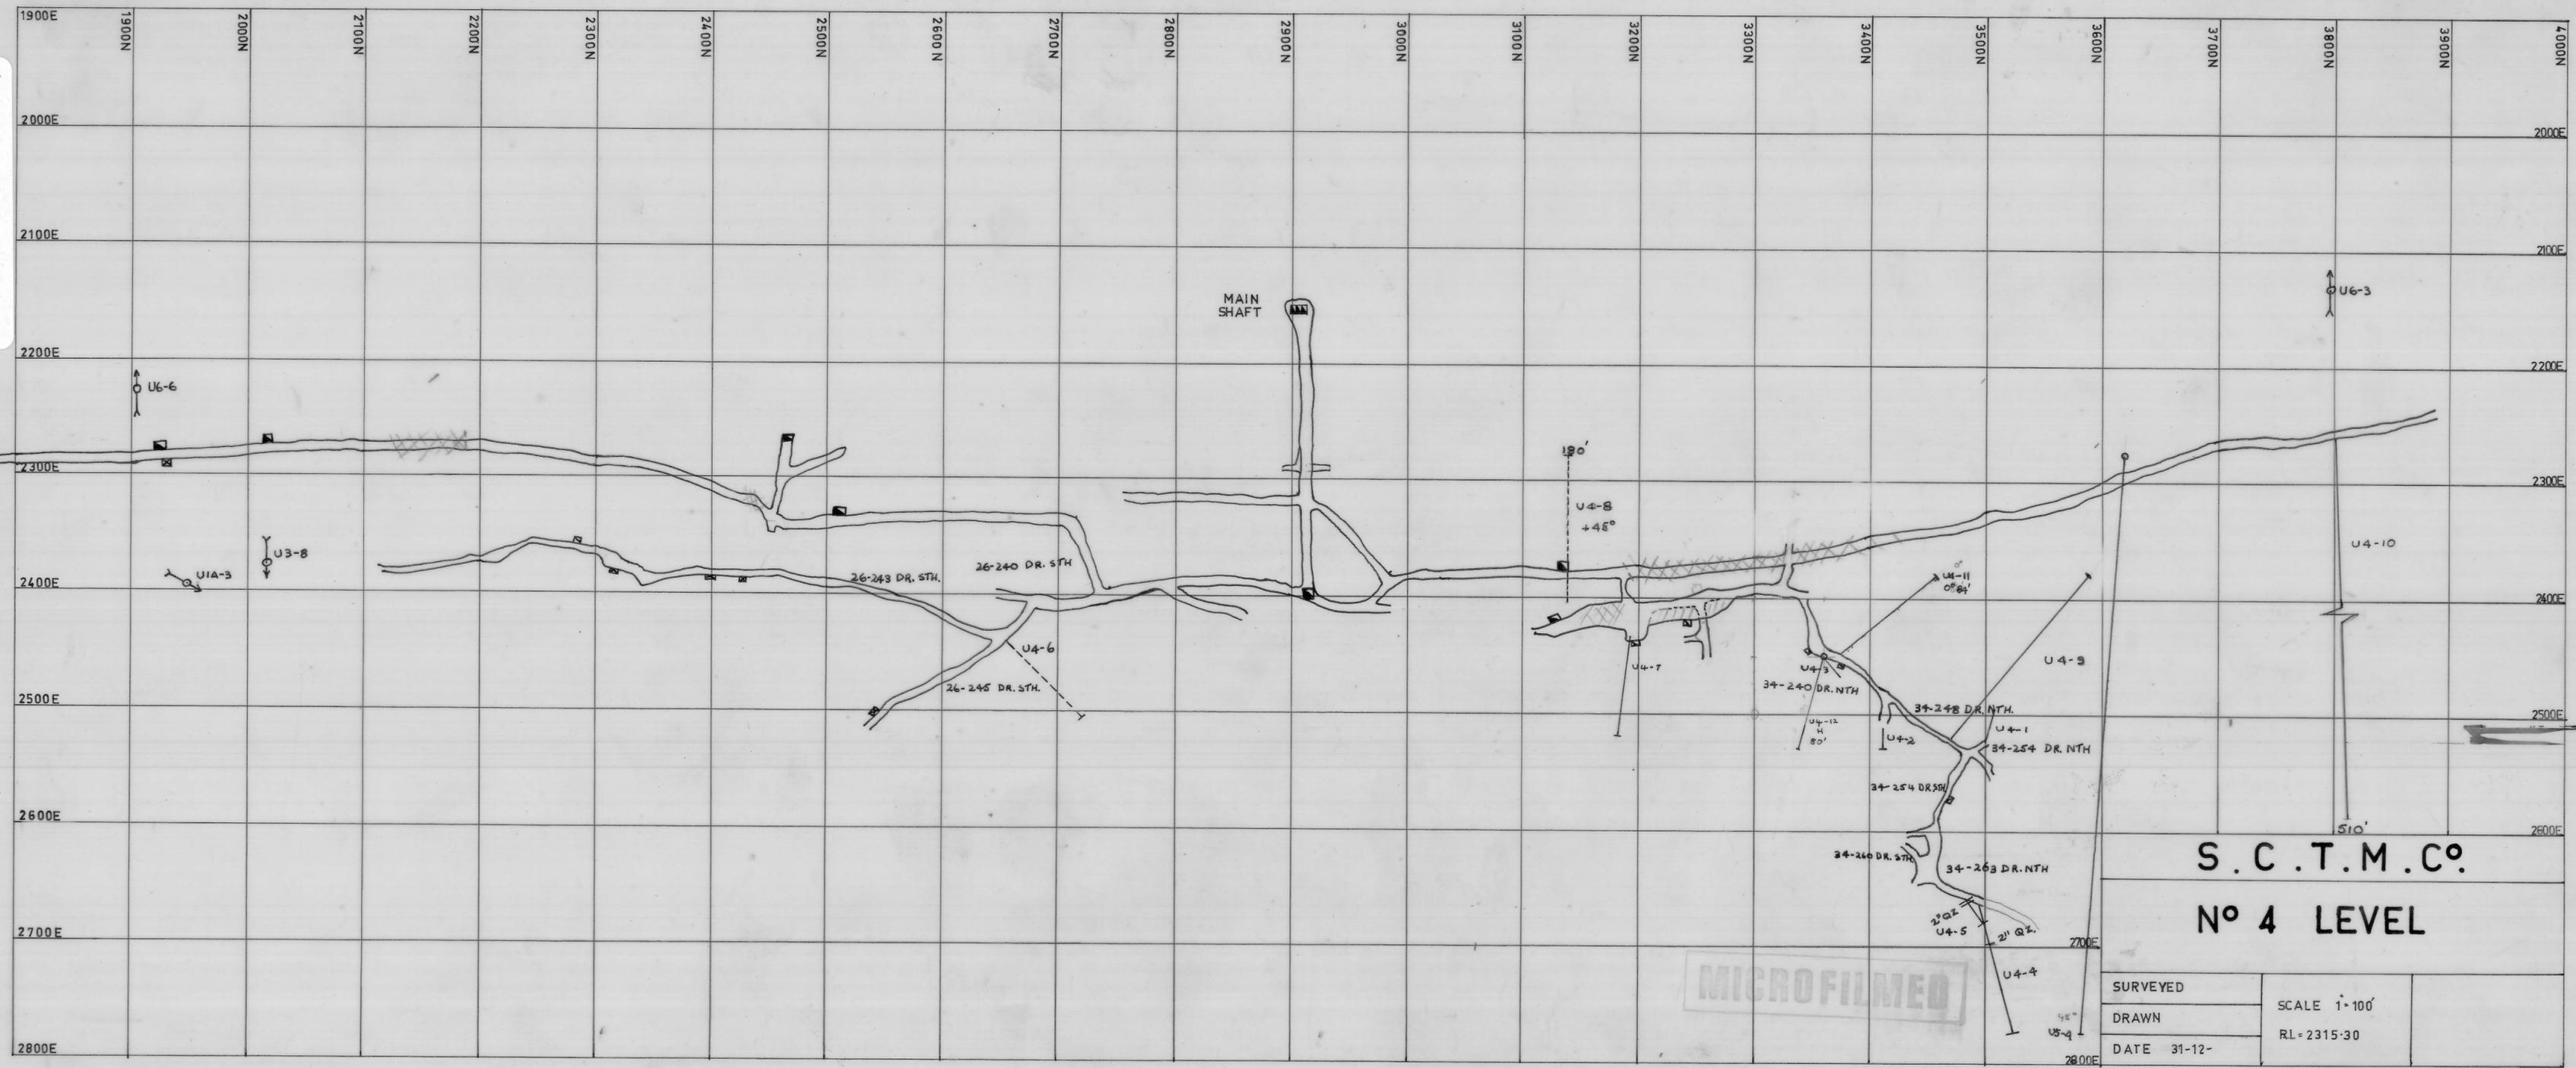


APERF-646

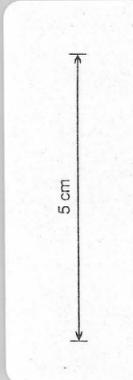

S. C. T. M. C.
 N° 4 LEVEL

SURVEYED	SCALE 1"=100'
DRAWN	RL=2315.30
DATE 31-12-	

82259