


ABERF-647

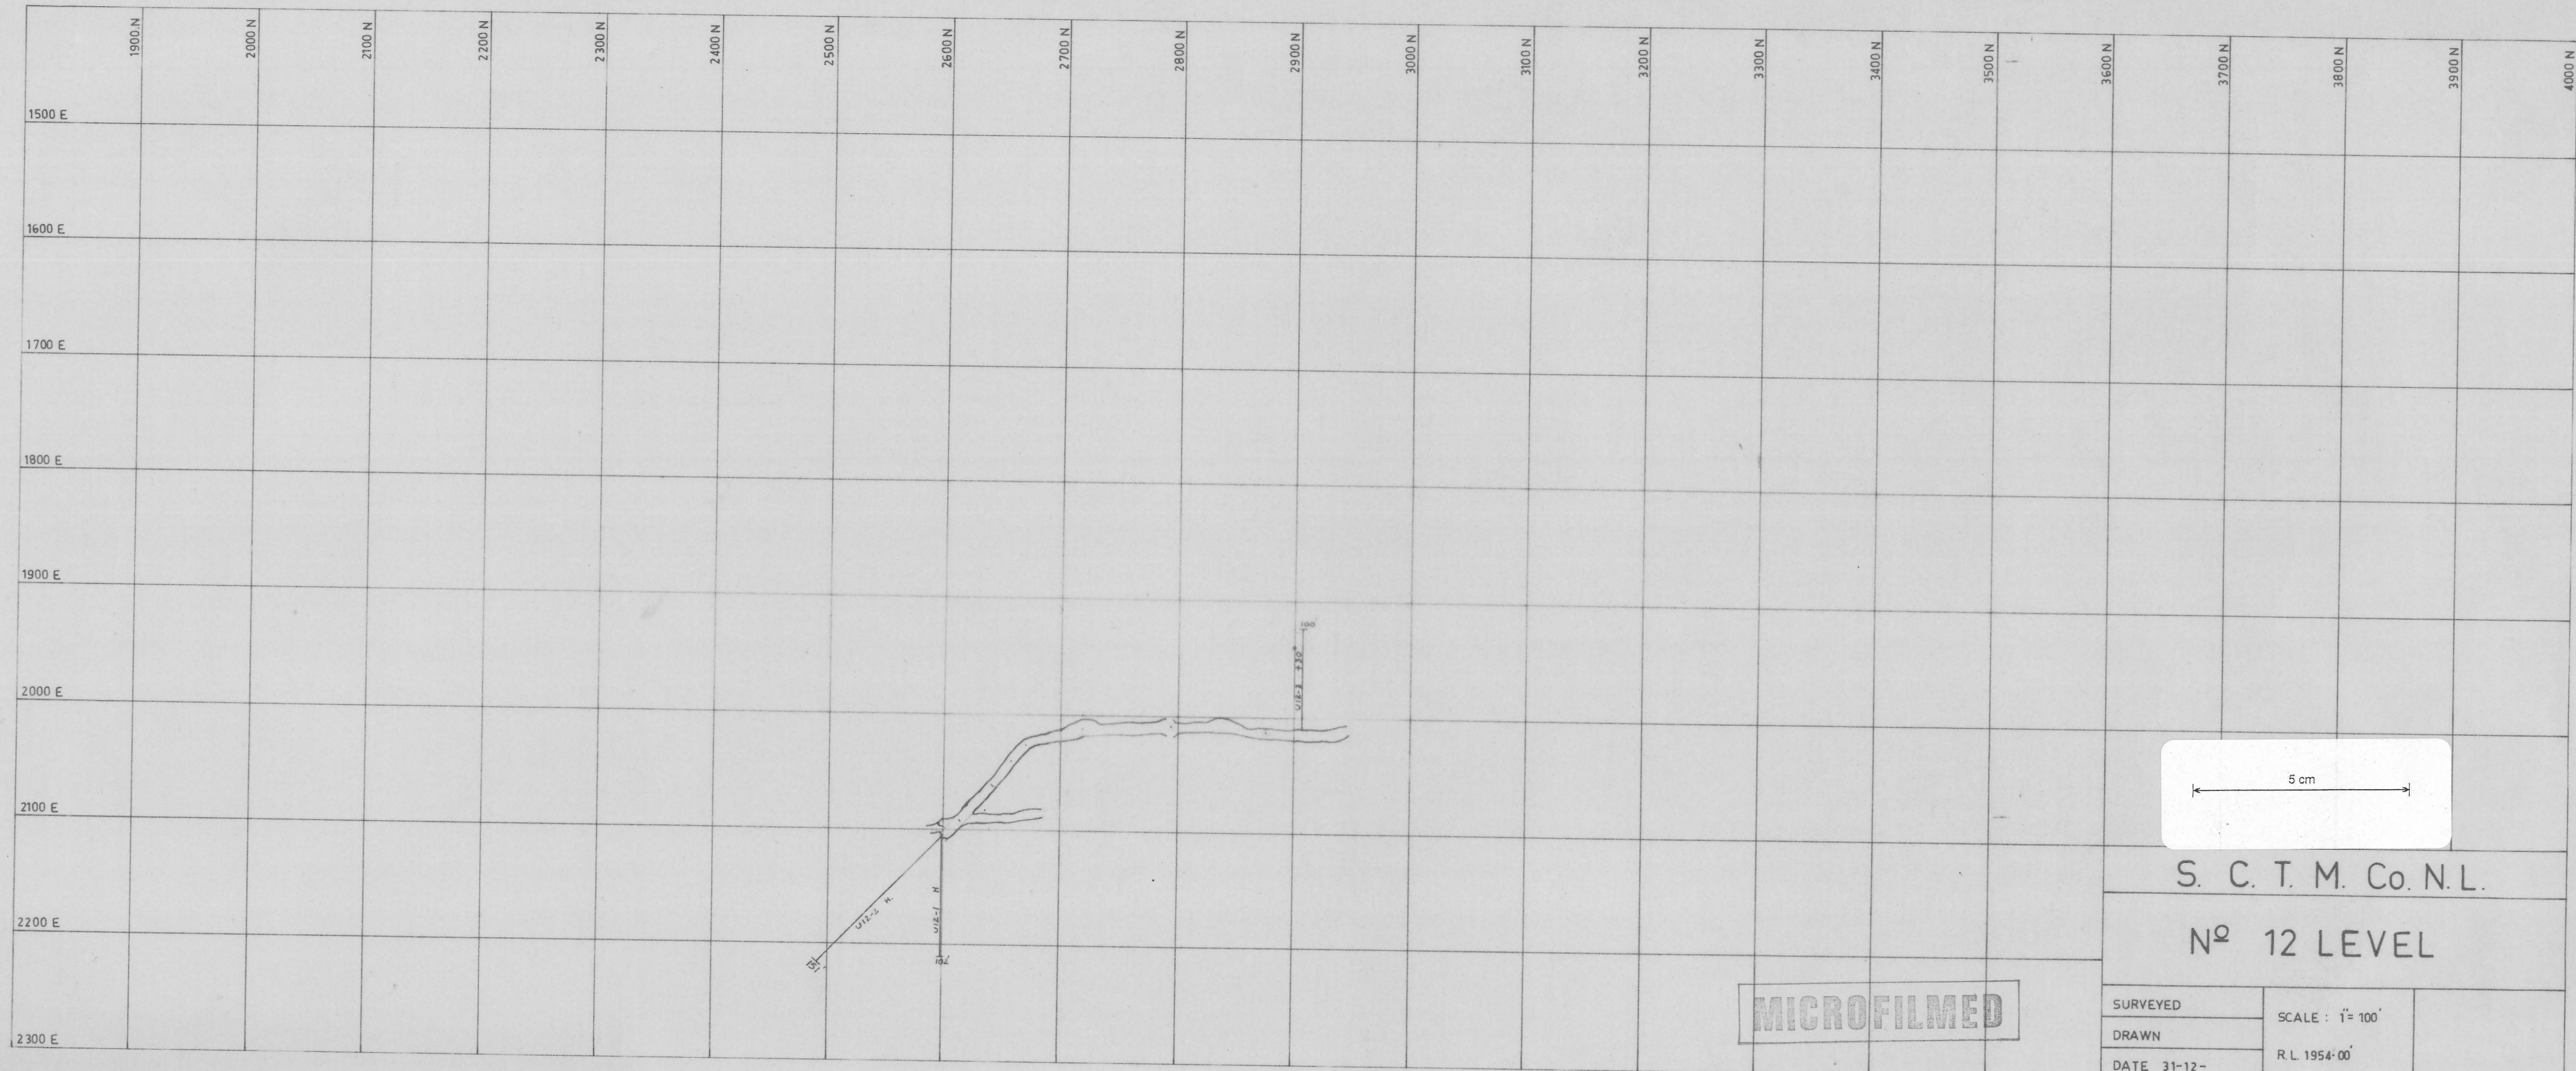

S. C. T. M. Co. N. L.

N<sup>o</sup> 12 LEVEL

|             |                   |               |
|-------------|-------------------|---------------|
| SURVEYED    | SCALE : 1" = 100' | R. L. 1954-00 |
| DRAWN       |                   |               |
| DATE 31-12- |                   |               |

82252