


ABERF-648

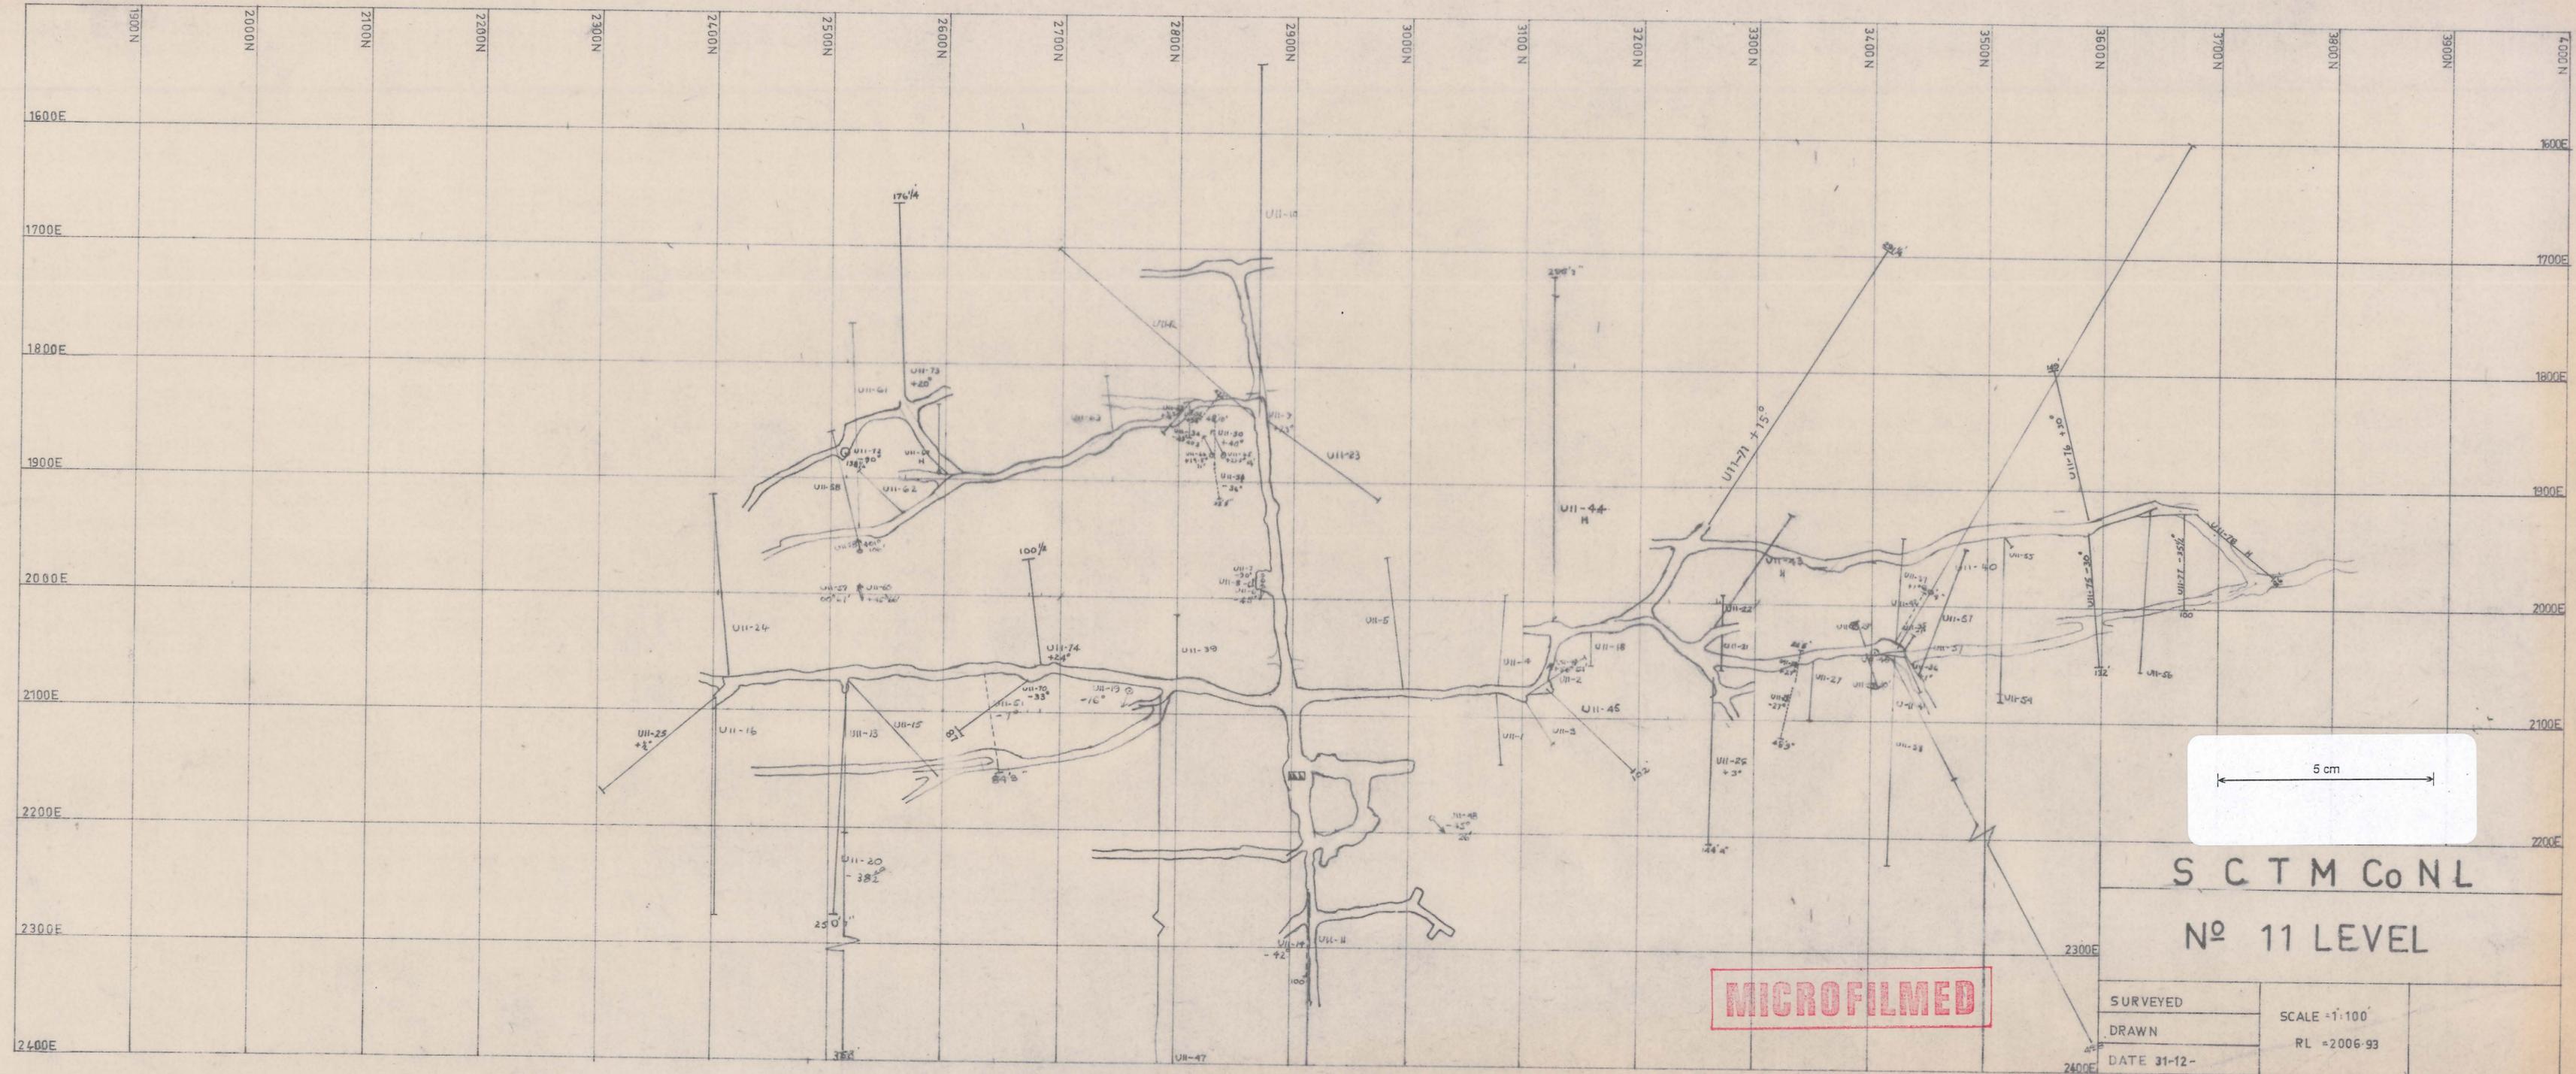

S C T M Co NL  
 No 11 LEVEL

SURVEYED	SCALE = 1:100
DRAWN	RL = 2006-93
DATE 31-12-	

**MICROFILMED**

82251