


ABERF-650

5 cm

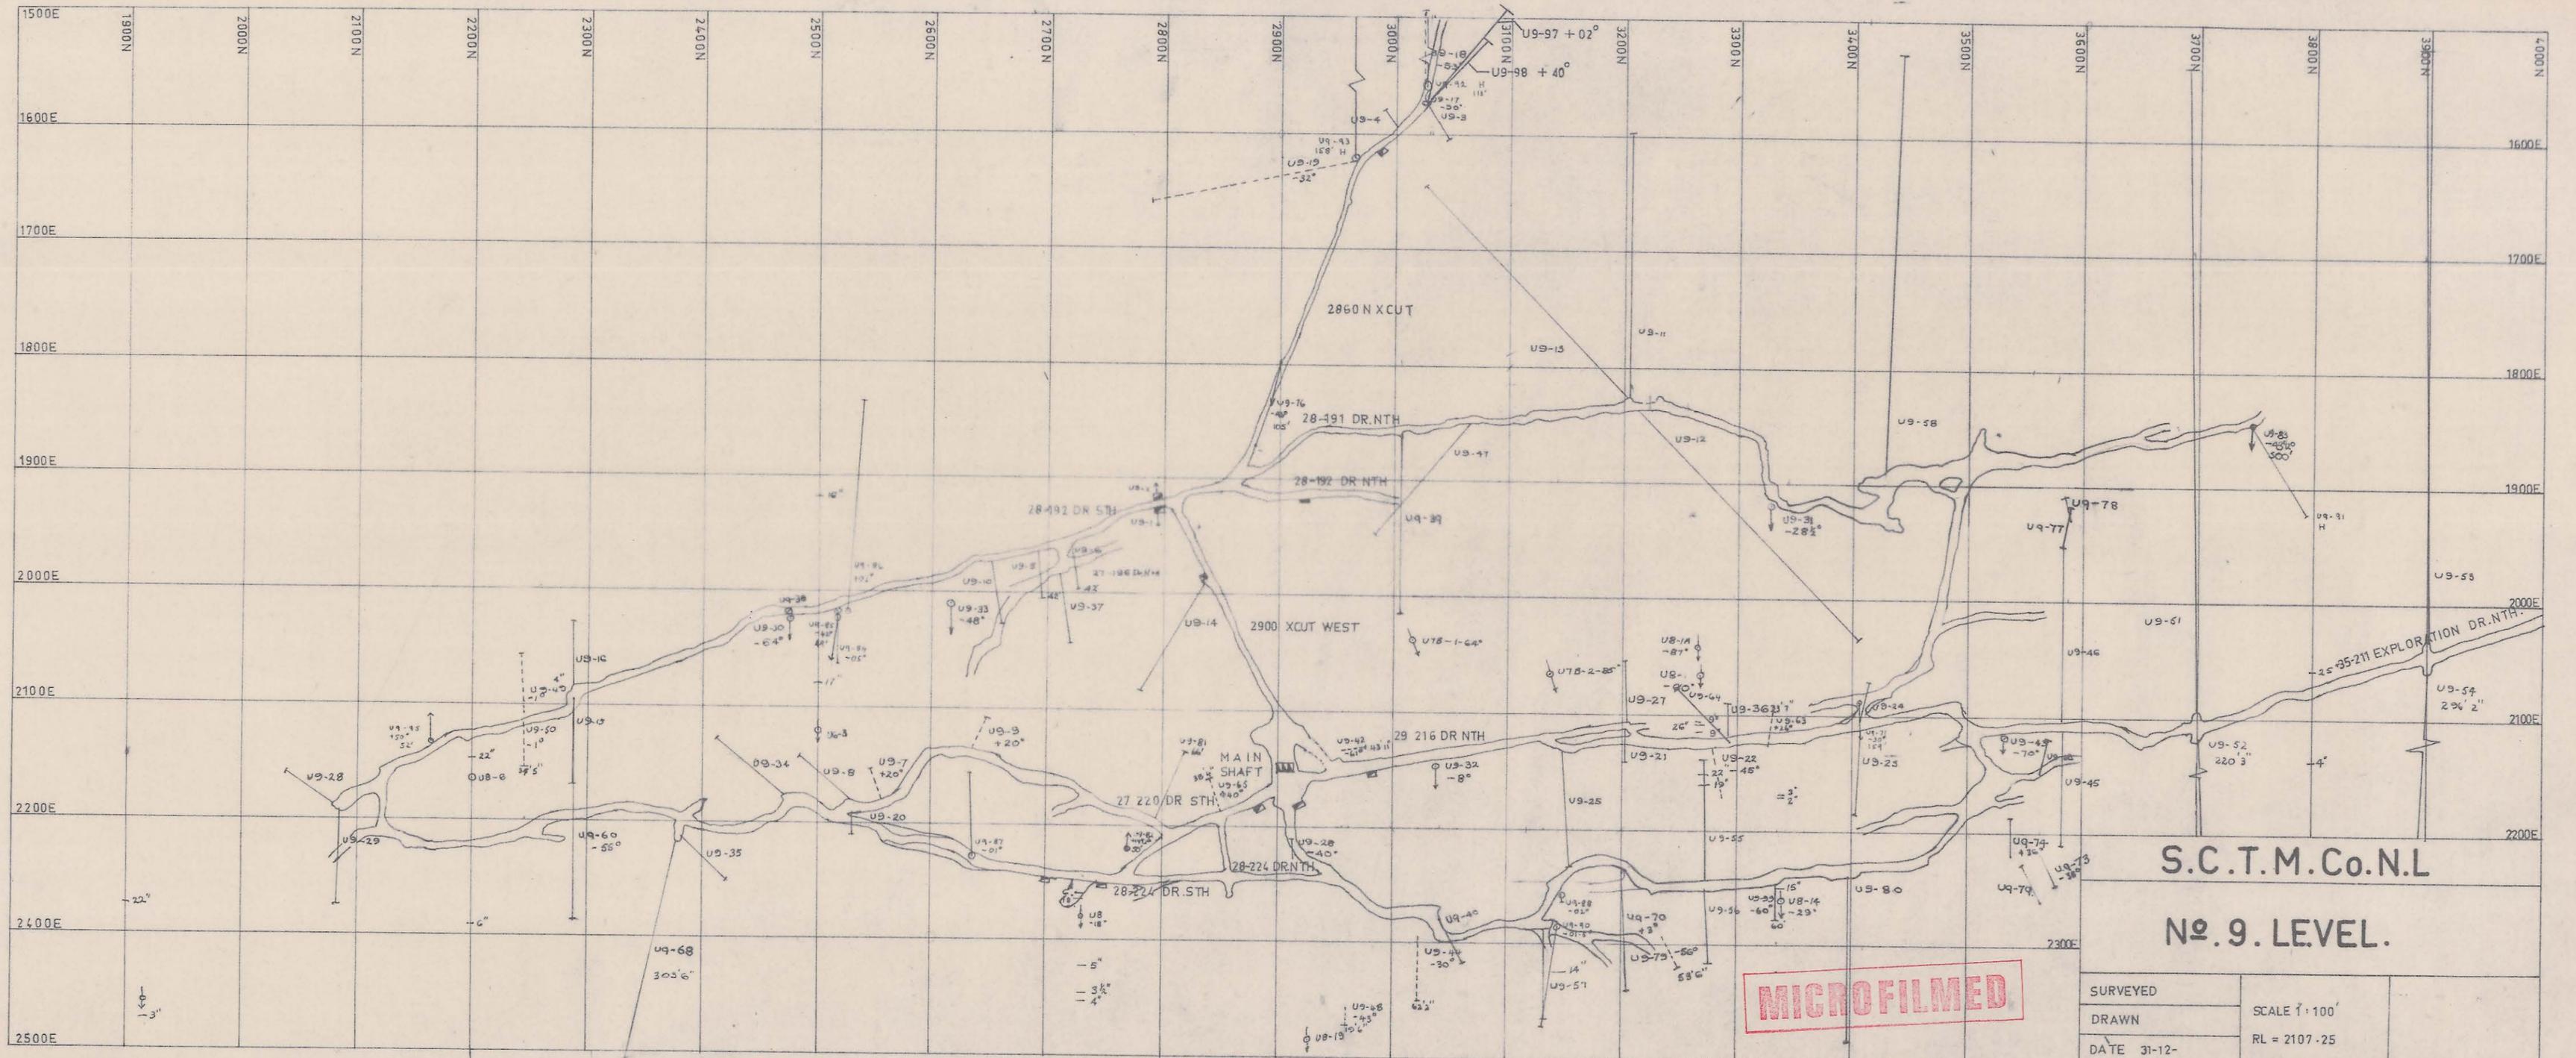

S.C.T.M.Co.N.L

No. 9. LEVEL.

SURVEYED	SCALE 1" = 100'
DRAWN	RL = 2107.25
DATE 31-12-	

MICROFILMED

82249