


APERF-651

5 cm

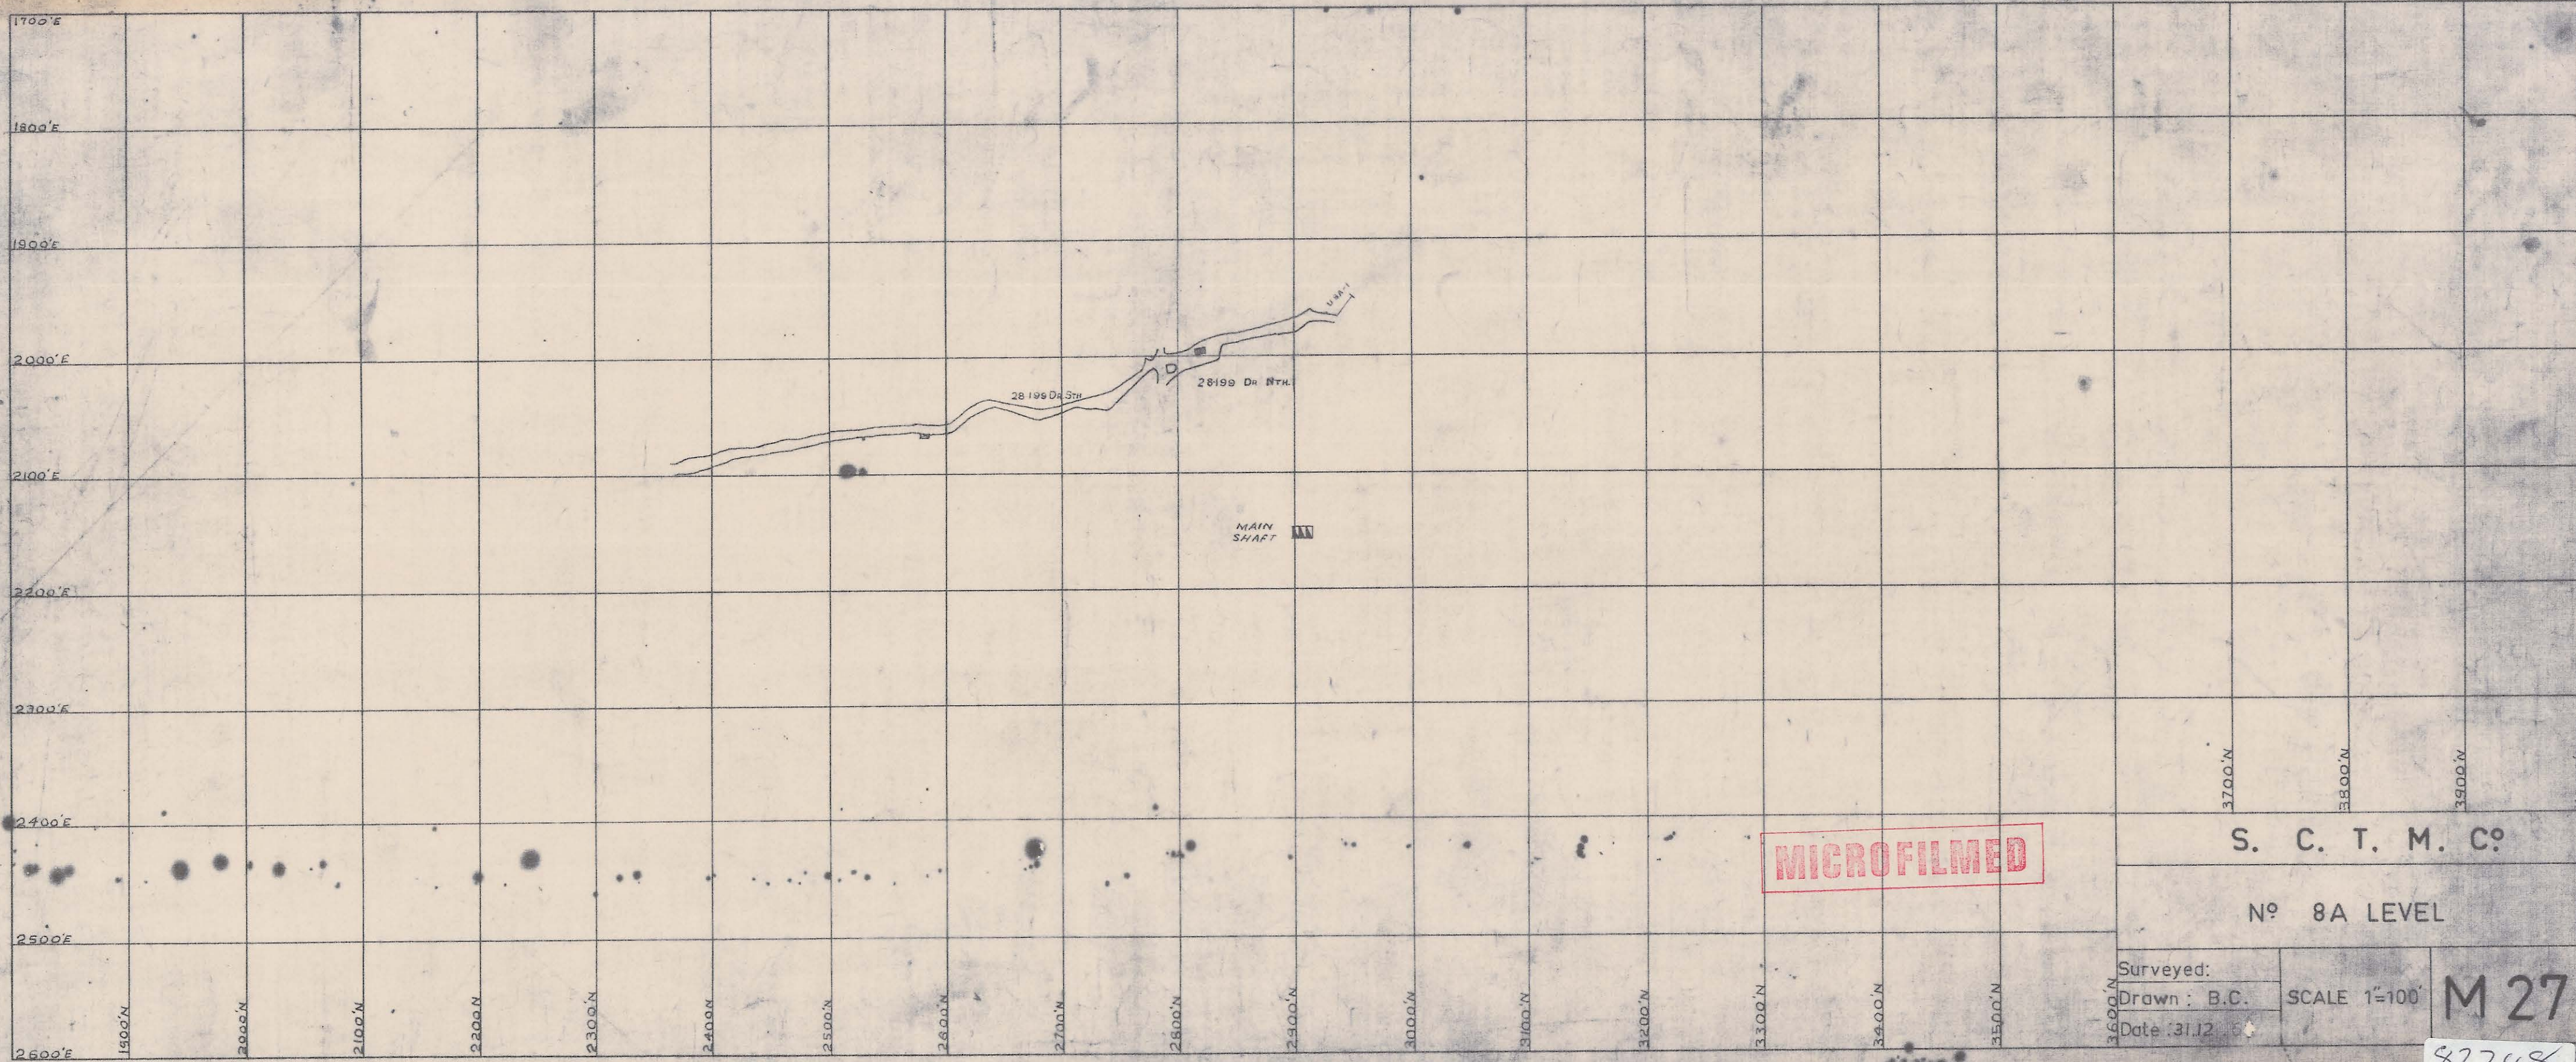

MICROFILMED

S. C. T. M. Co

Nº 8A LEVEL

Surveyed:

Drawn: B.C.

Date: 31.12.60

SCALE 1"=100'

M 27

82248