



ABERF-653

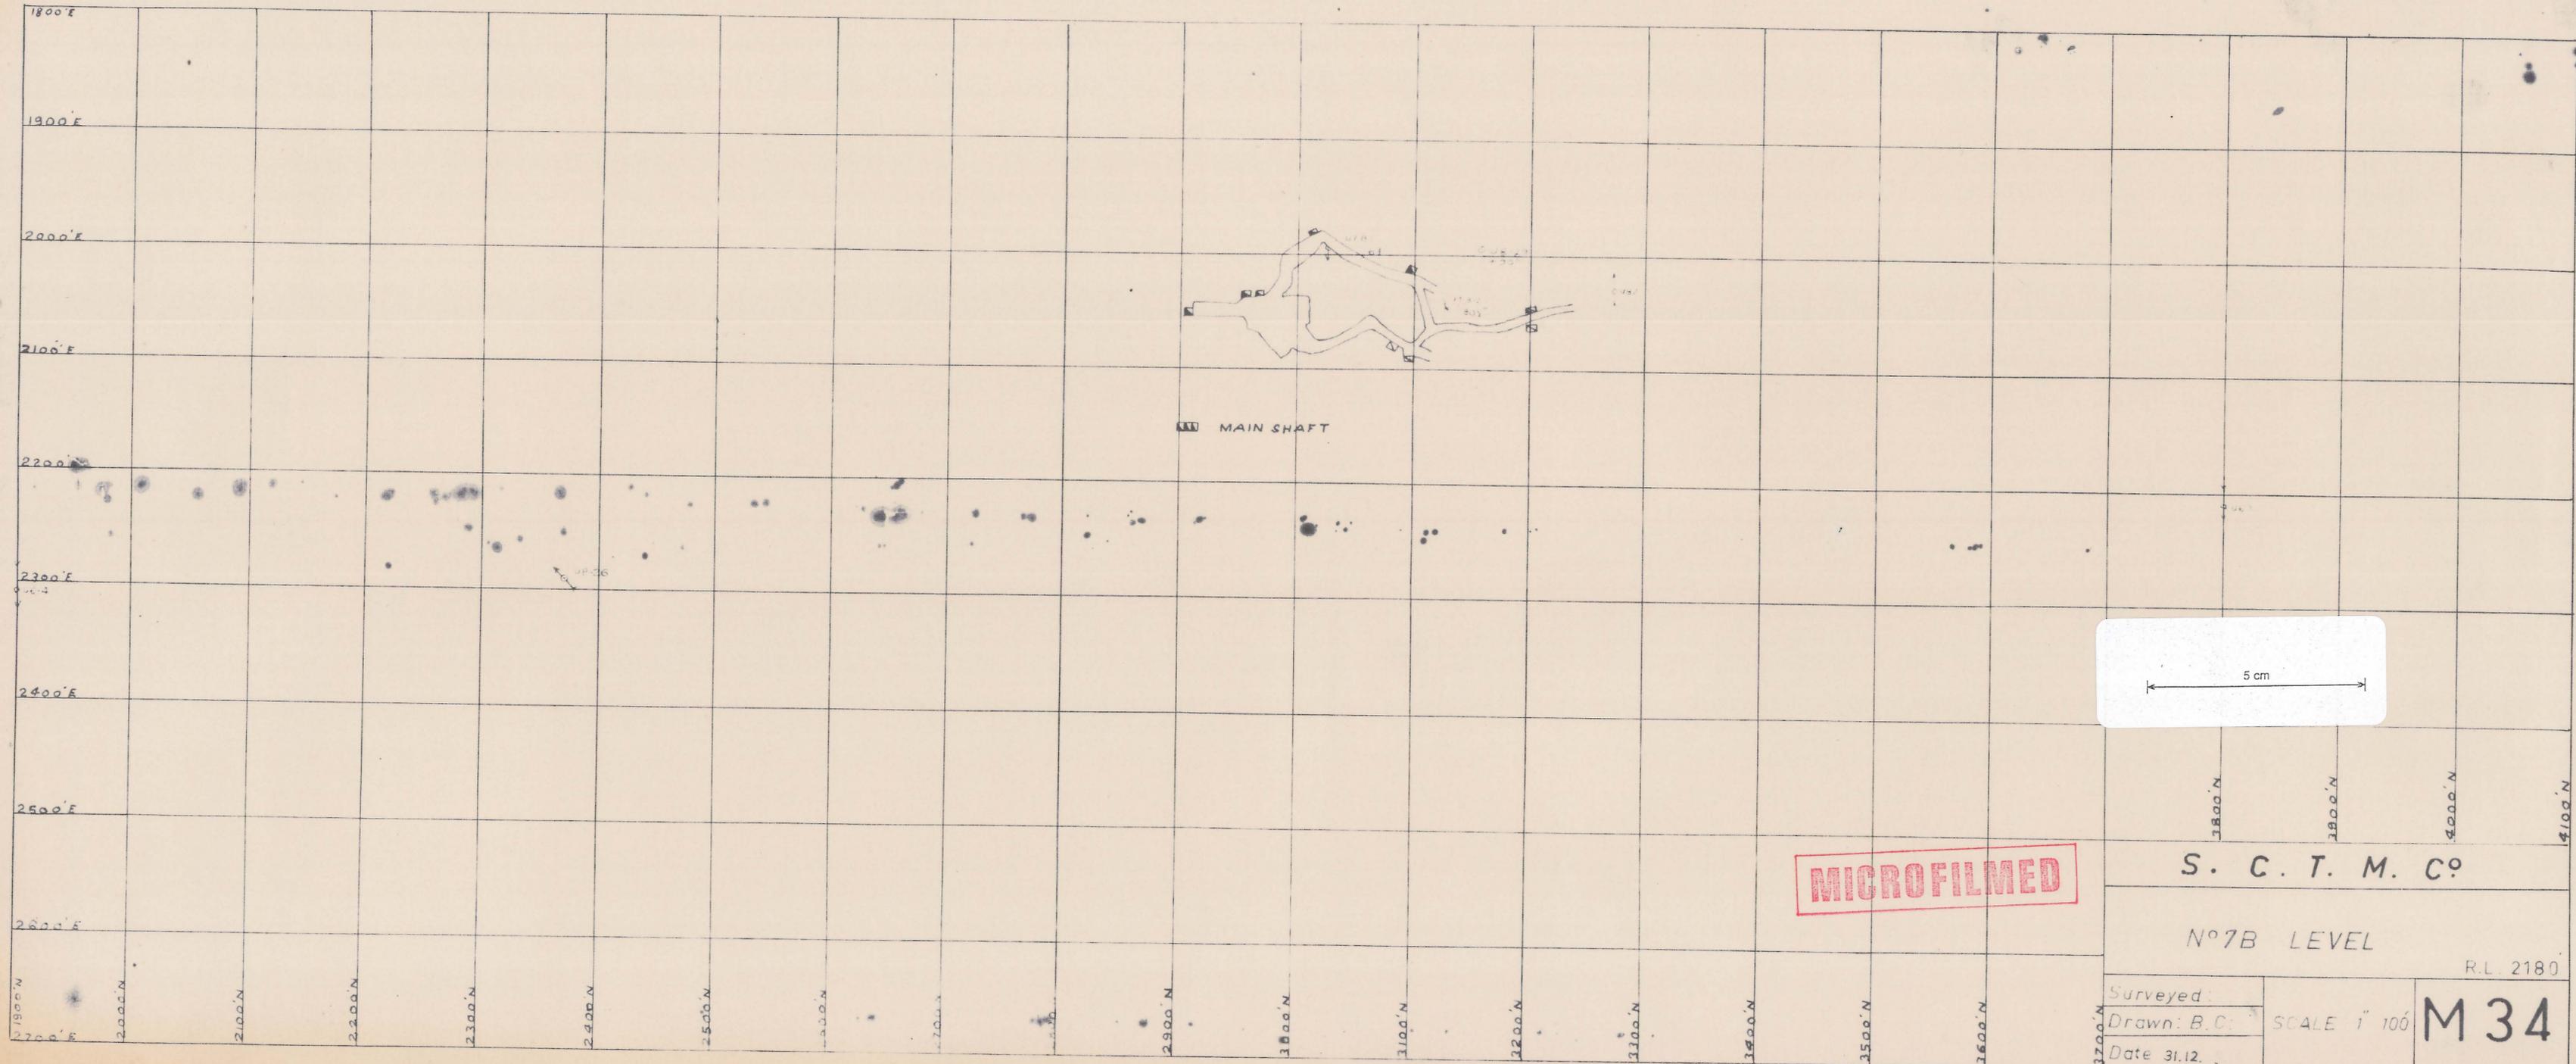

MICROFILMED

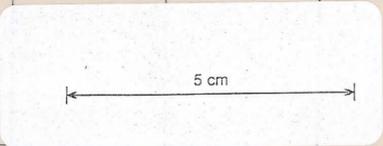

S. C. T. M. CO

N°7B LEVEL

R.L. 2180

Surveyed:  
 Drawn: B.C.  
 Date 31.12.

SCALE 1" 100'

M 34

82246