



ABERF-6SS

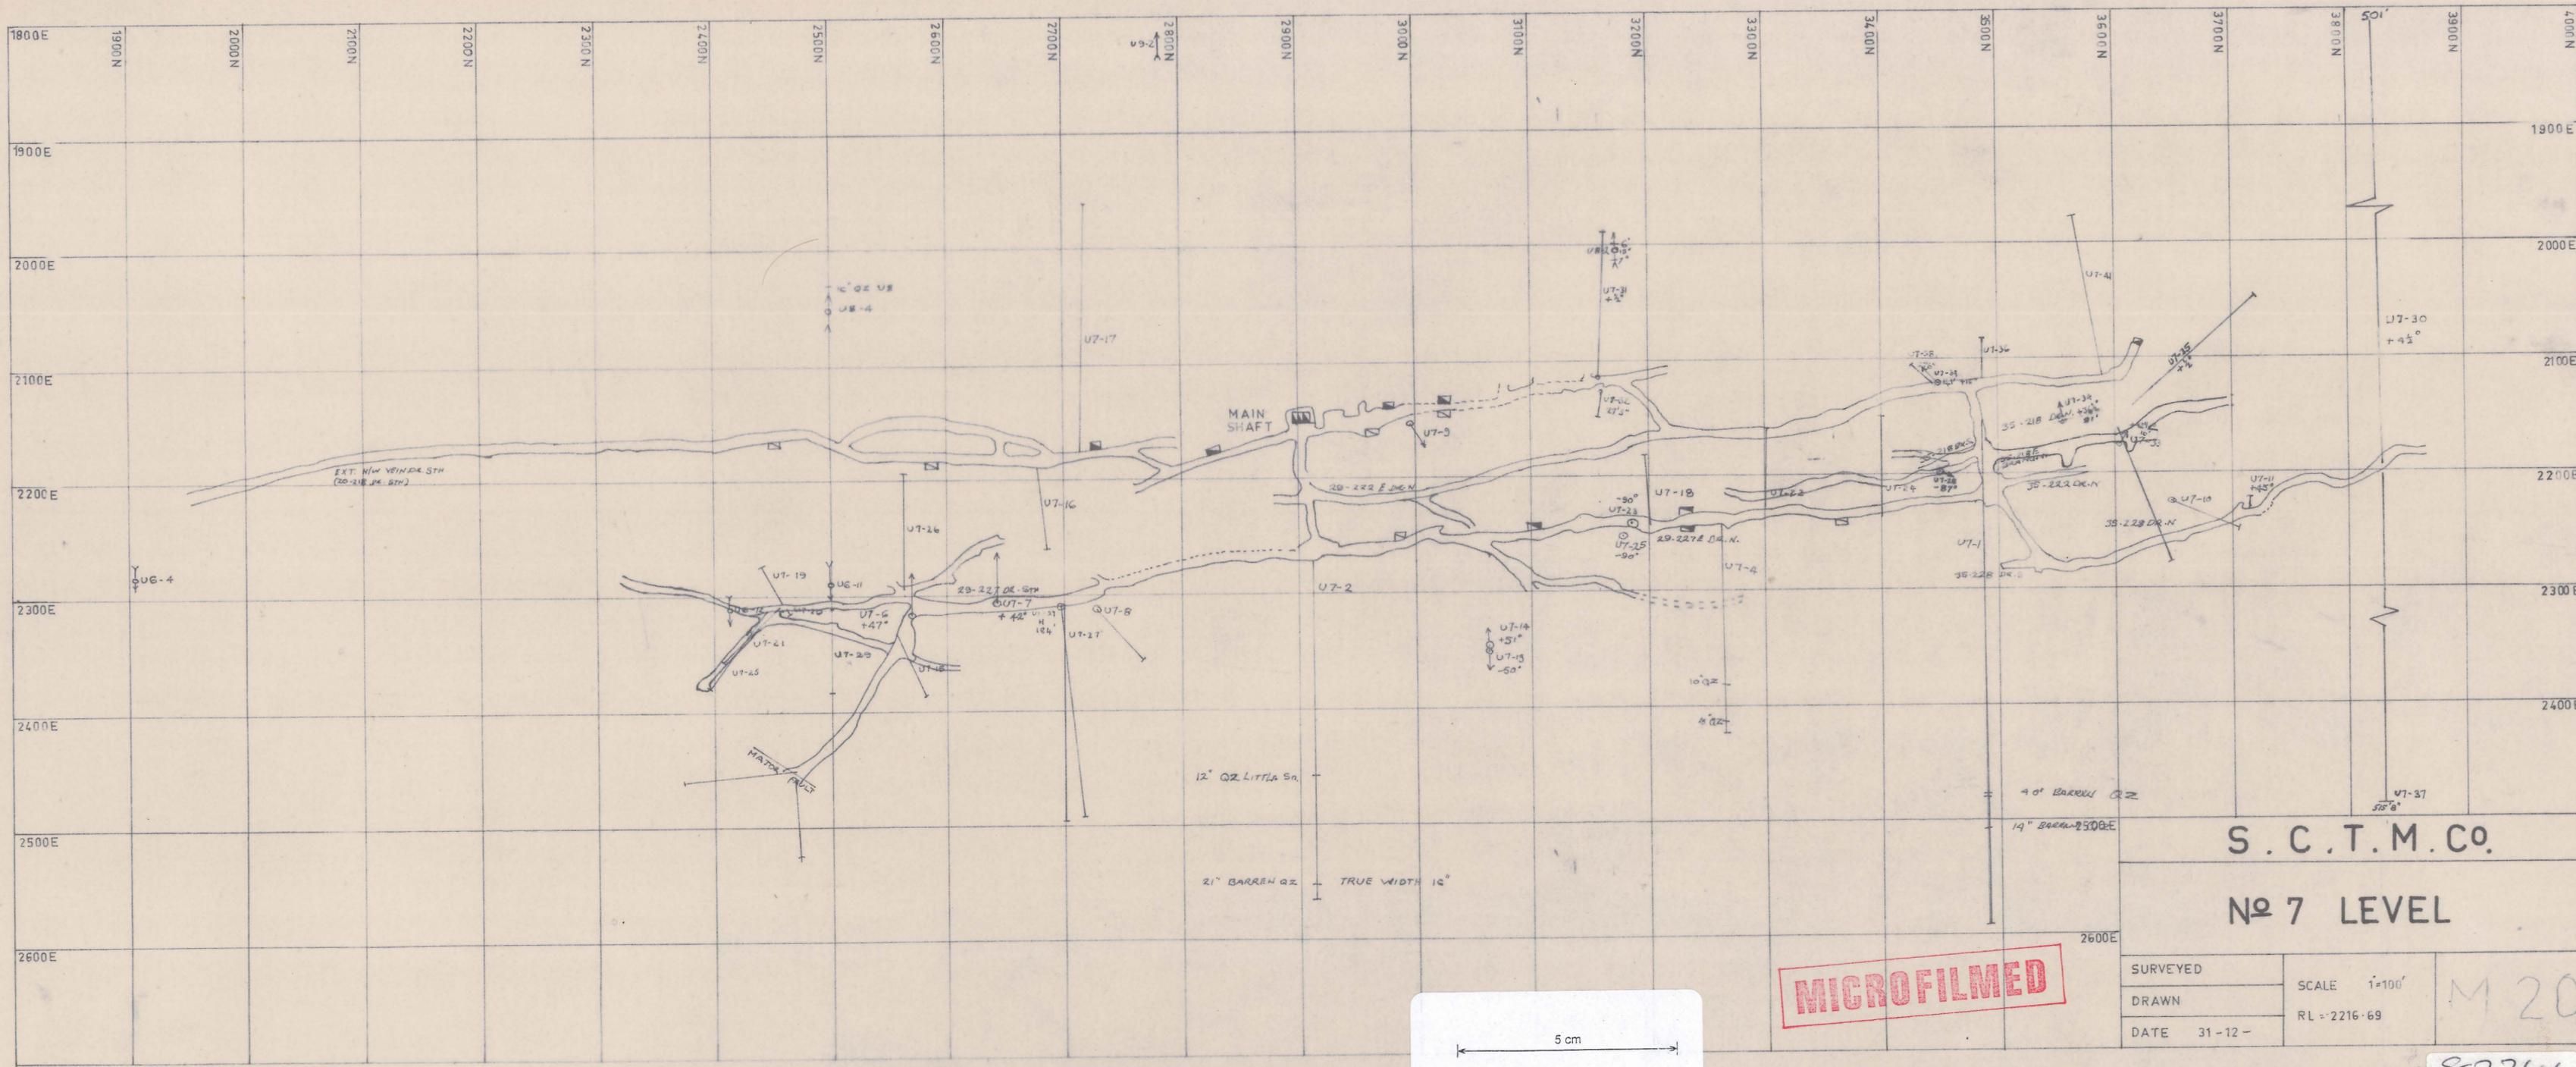

S. C. T. M. CO.  
 No 7 LEVEL

SURVEYED	SCALE 1"=100'	M 20
DRAWN	RL = 2216.69	
DATE 31-12-		

**MICROFILMED**

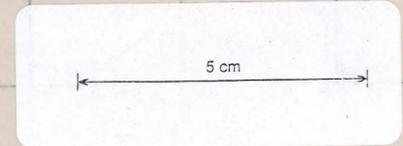

82244