


ABERF-656

5 cm

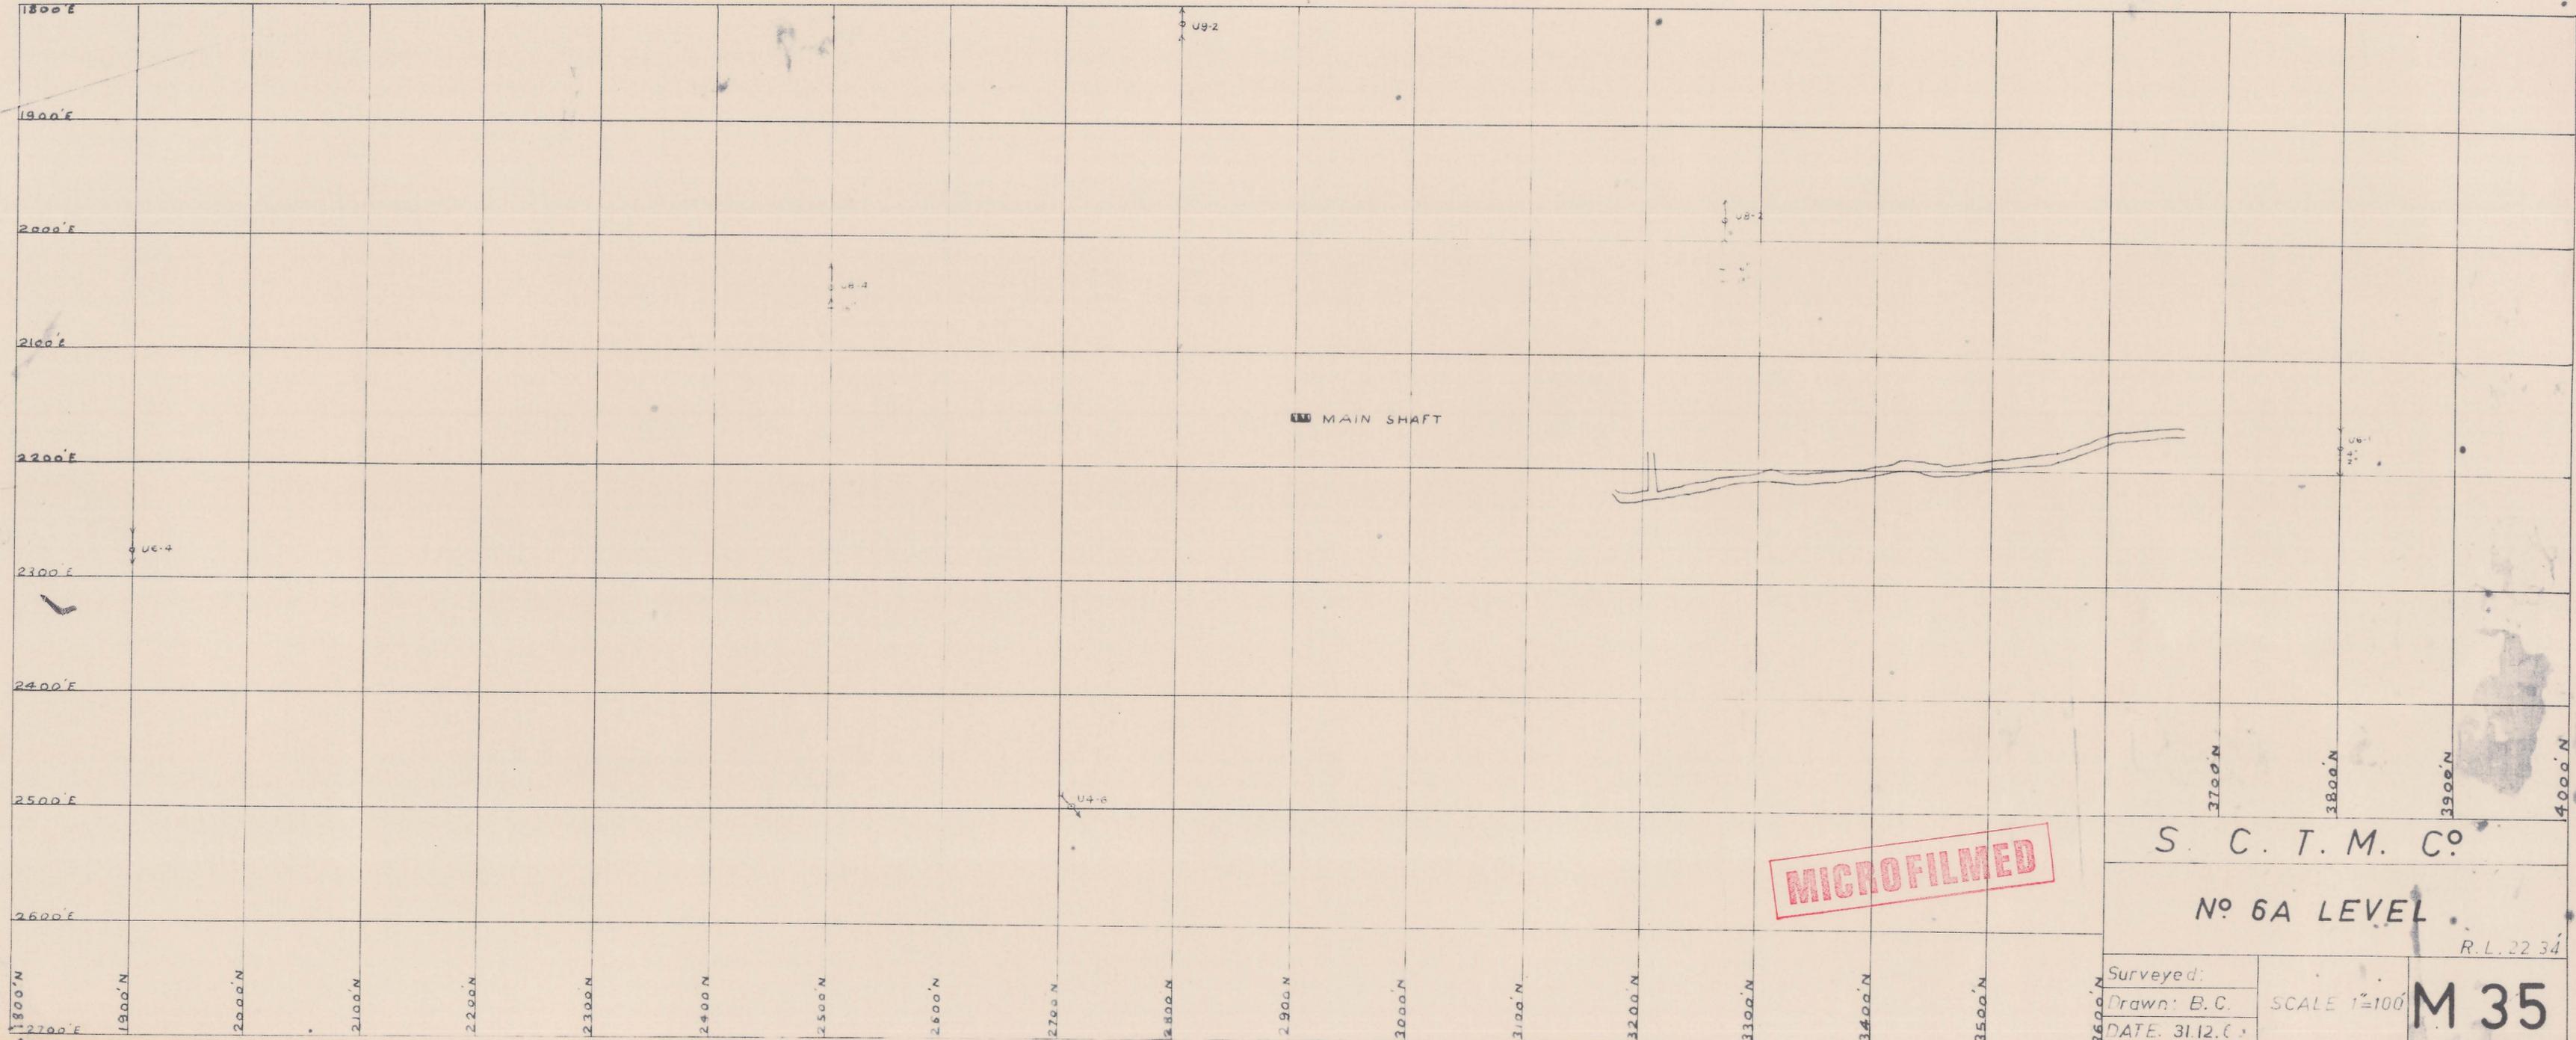

MICROFILMED

S. C. T. M. CO.

No 6A LEVEL

R.L. 22 34

Surveyed:

Drawn: B.C.

DATE: 31.12.0

SCALE 1"=100'

M 35

82243