
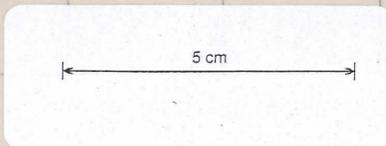


ABERF-657

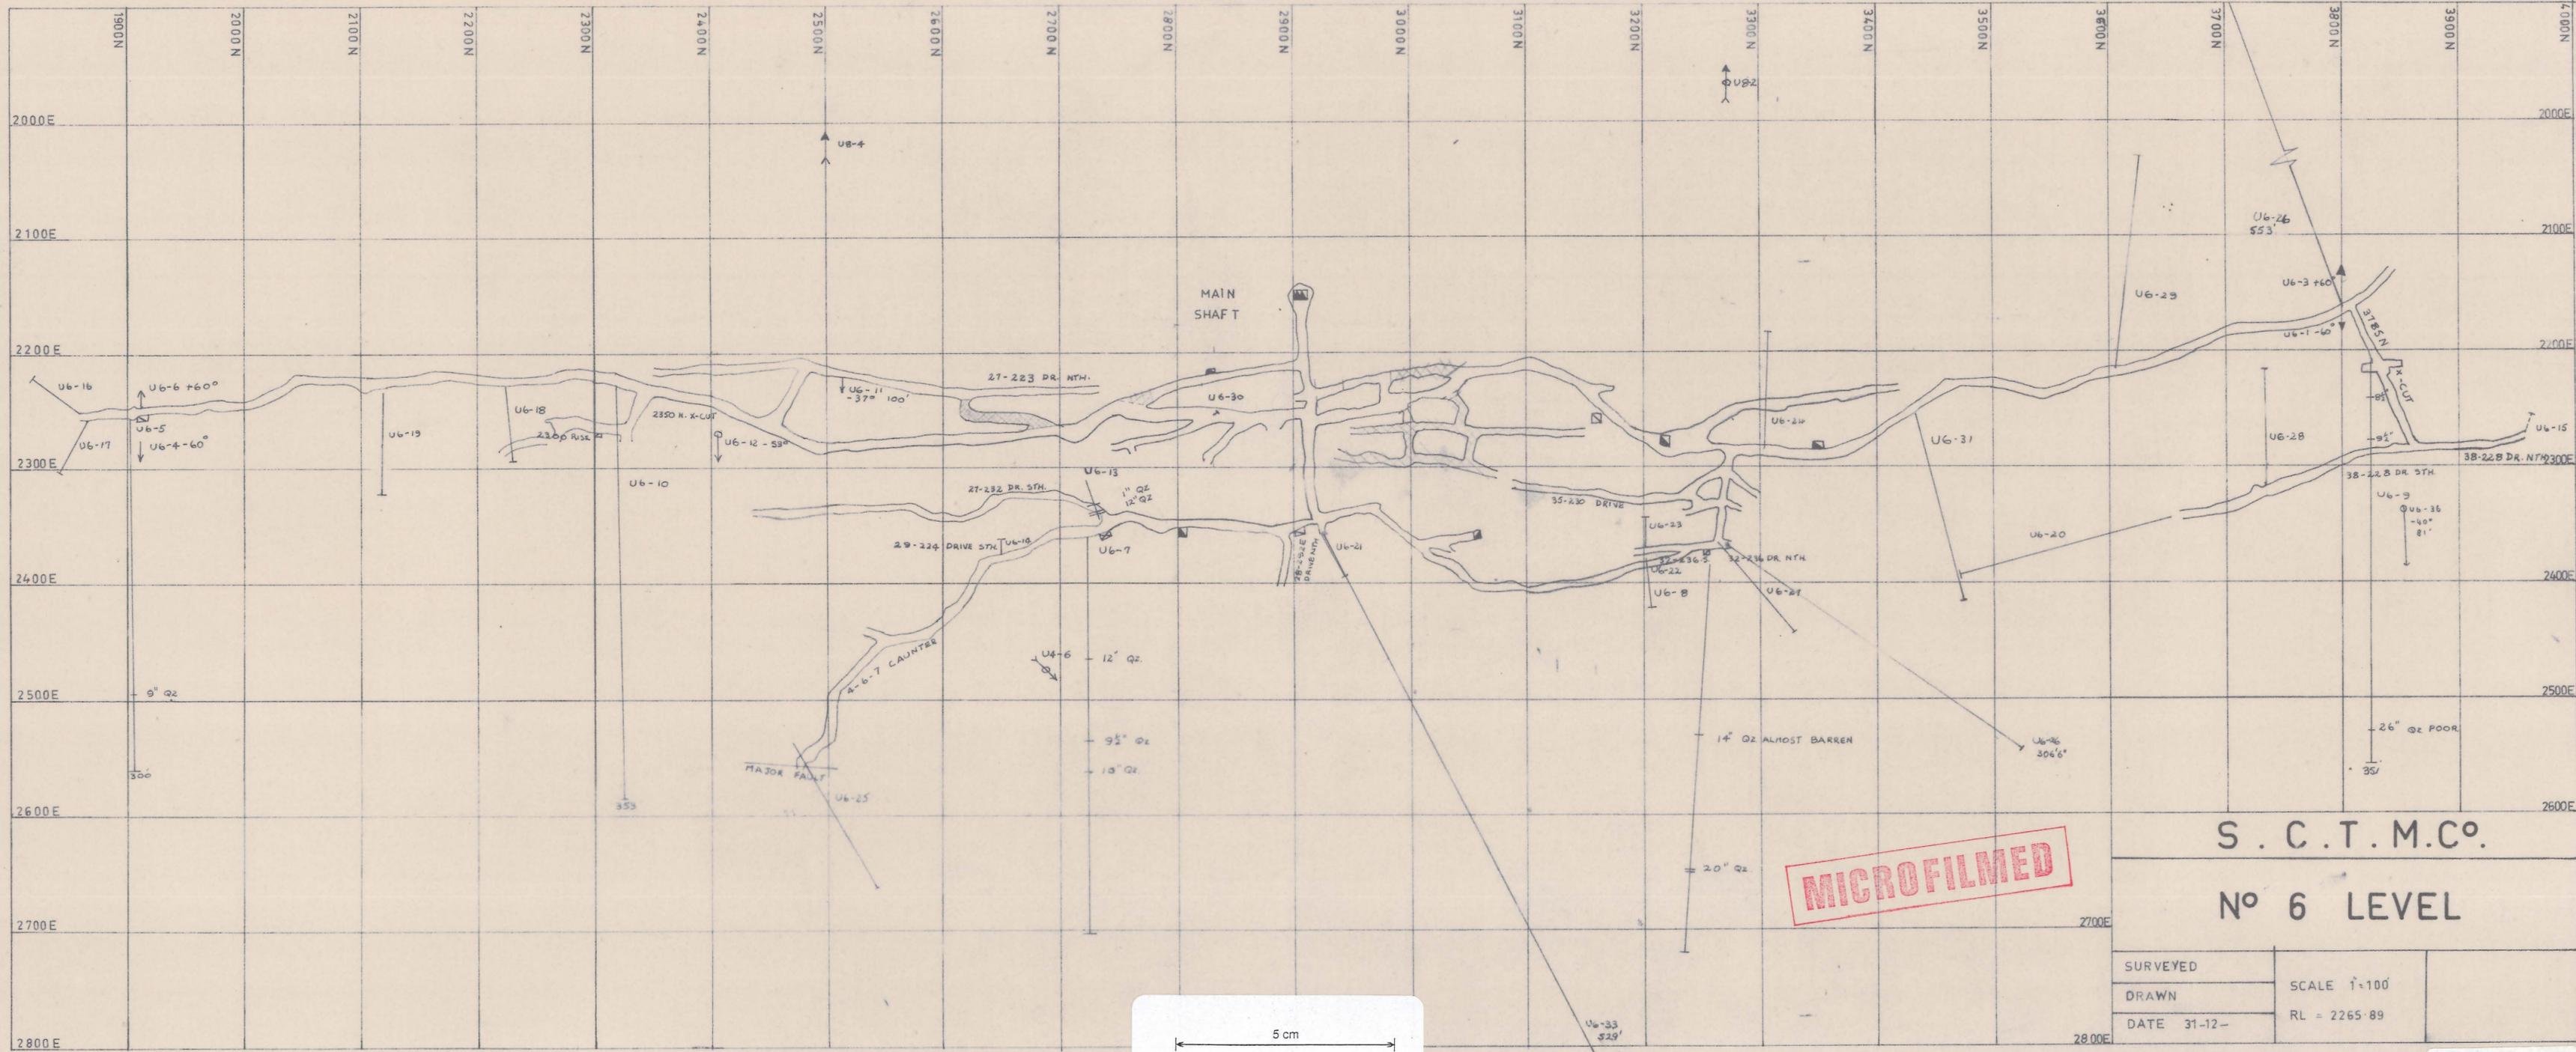

MICROFILMED

S. C. T. M. C. °.

N° 6 LEVEL

SURVEYED	SCALE 1"=100' RL = 2265-89
DRAWN	
DATE 31-12-	

82242