
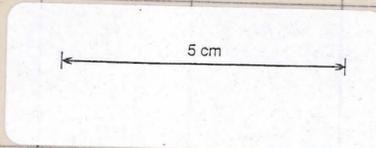


ABERF-658

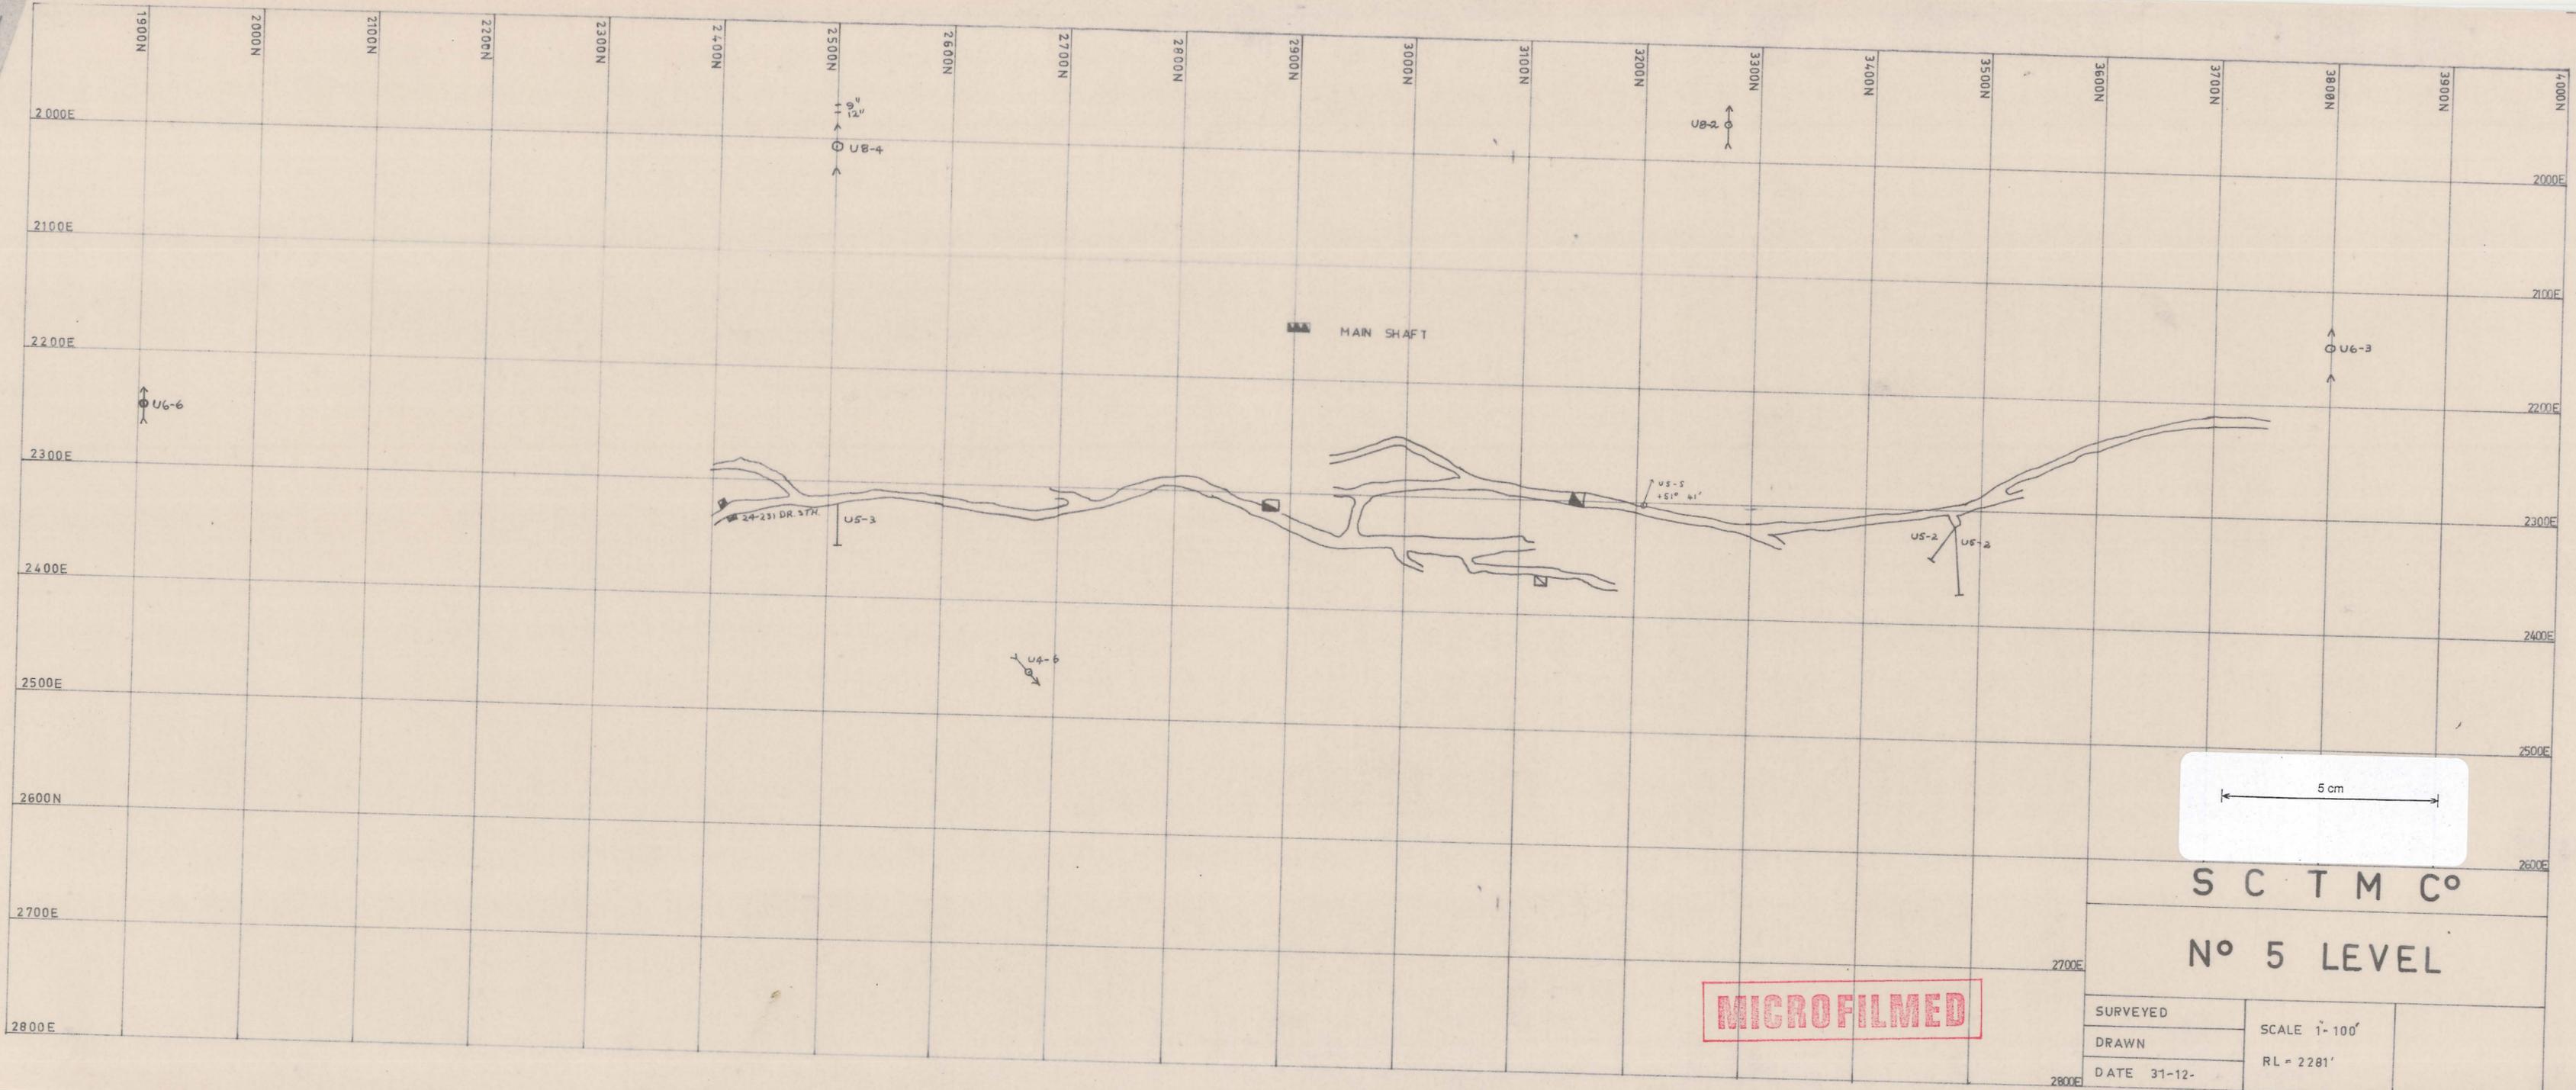

S C T M C^o
 N^o 5 LEVEL

MICROFILMED

| | |
|-------------|-------------------------------|
| SURVEYED | SCALE 1" = 100' RL = 2281' |
| DRAWN | |
| DATE 31-12- | |

82241