


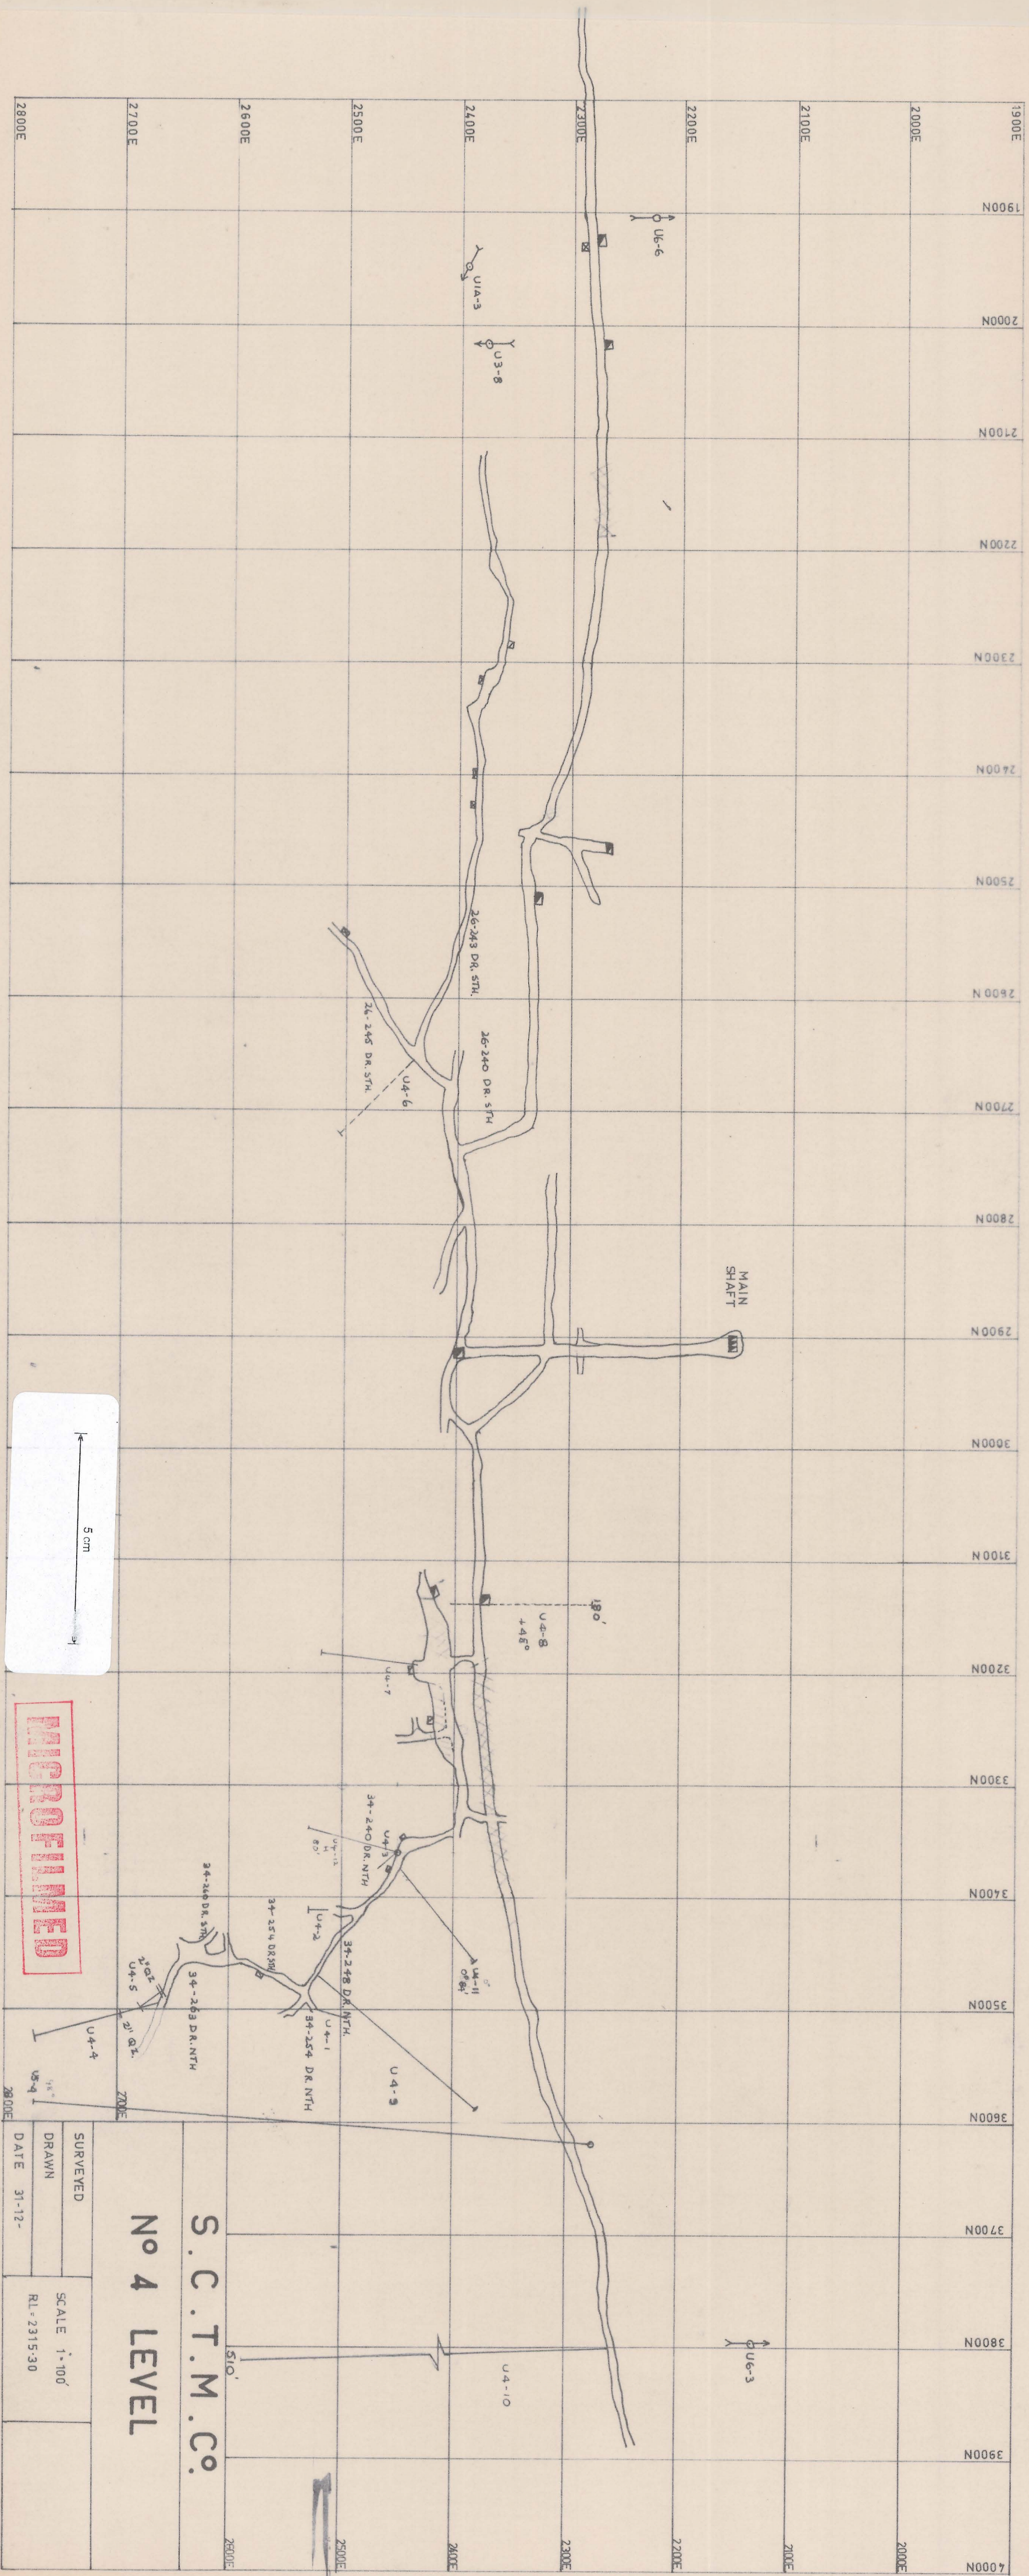

S.C.T.M.C.
No 4 LEVEL

SURVEYED
DRAWN
DATE 31-12-
SCALE 1:100
RL 2315.30

82240