


ABER-662

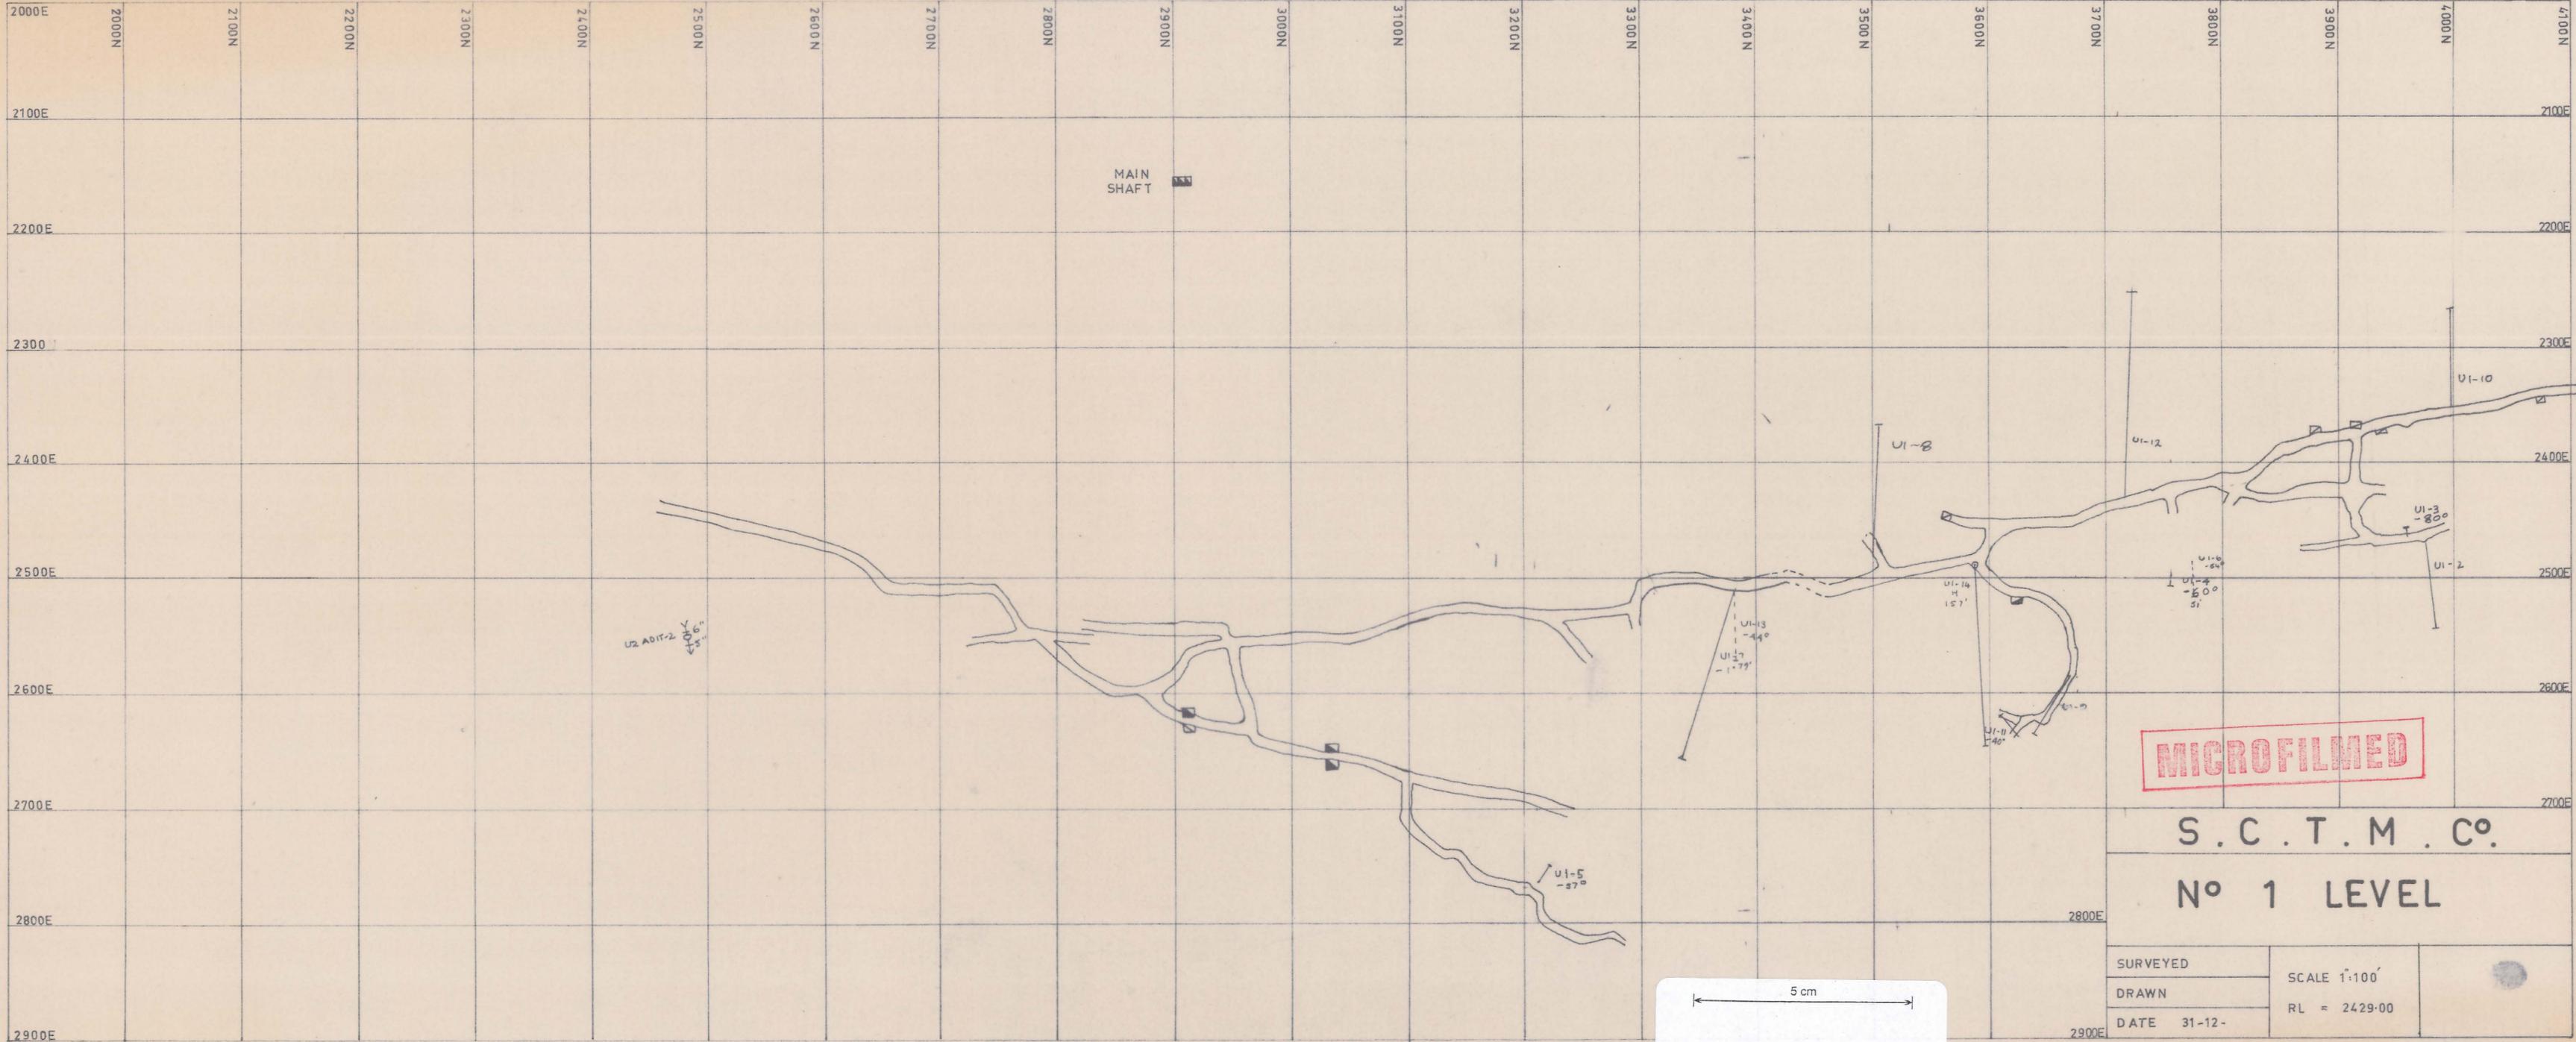

MICROFILMED

S.C.T.M. CO.
No 1 LEVEL

SURVEYED	SCALE 1:100 RL = 2429.00
DRAWN	
DATE 31-12-	

5 cm

82237