
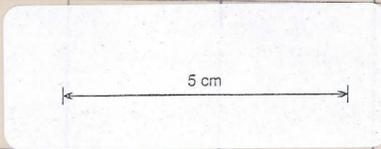


ABERF-663

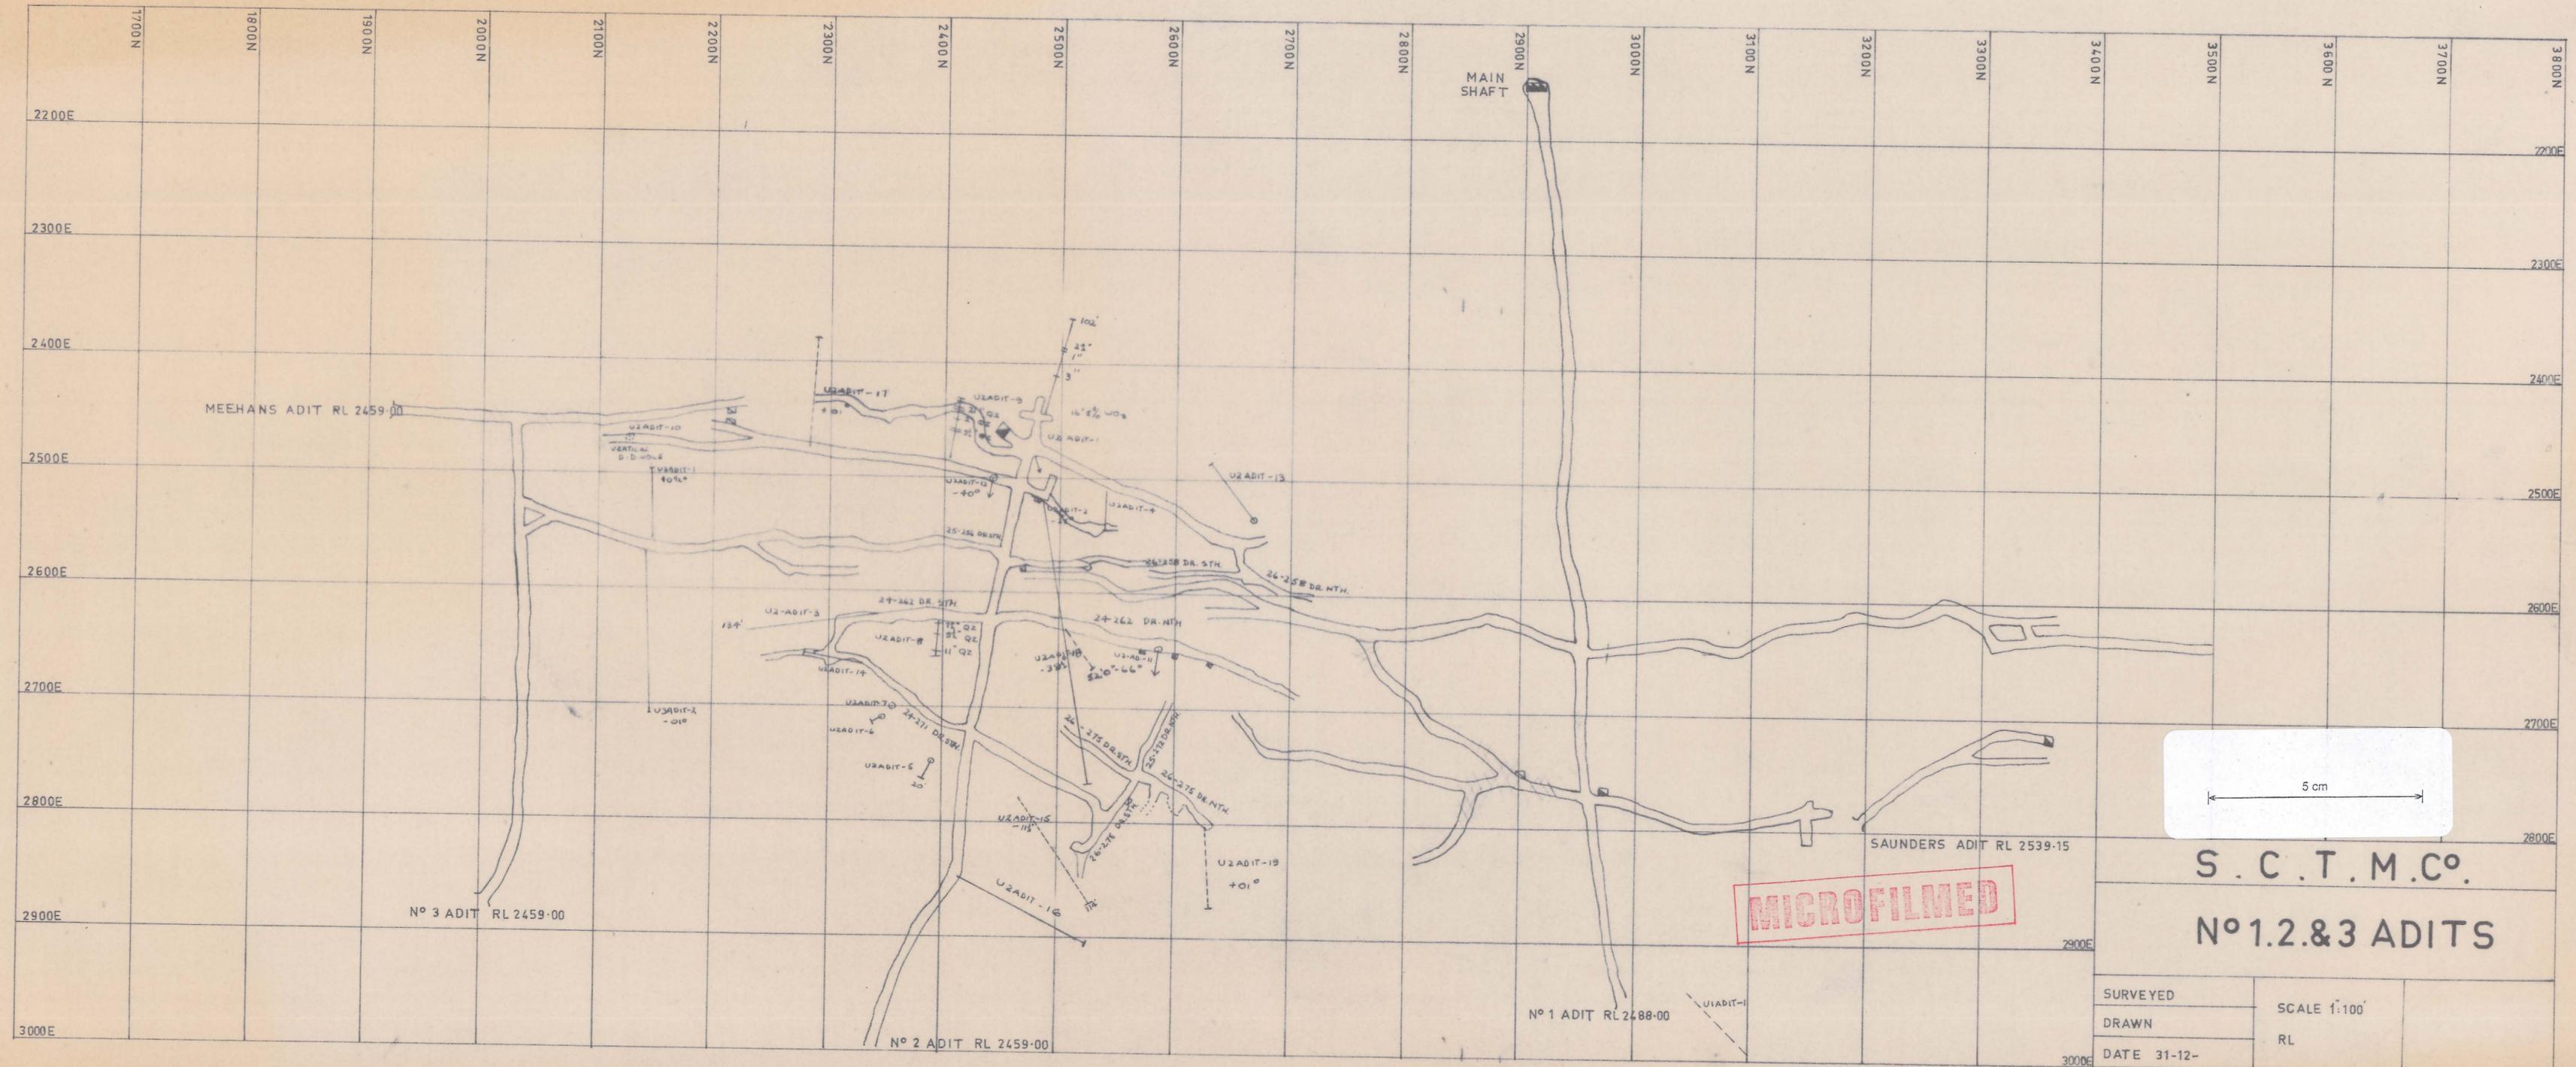

S. C. T. M. C.°
 N° 1.2.&3 ADITS

MICROFILMED

SURVEYED	SCALE 1:100
DRAWN	
DATE 31-12-	RL

82236