


ABERF-664

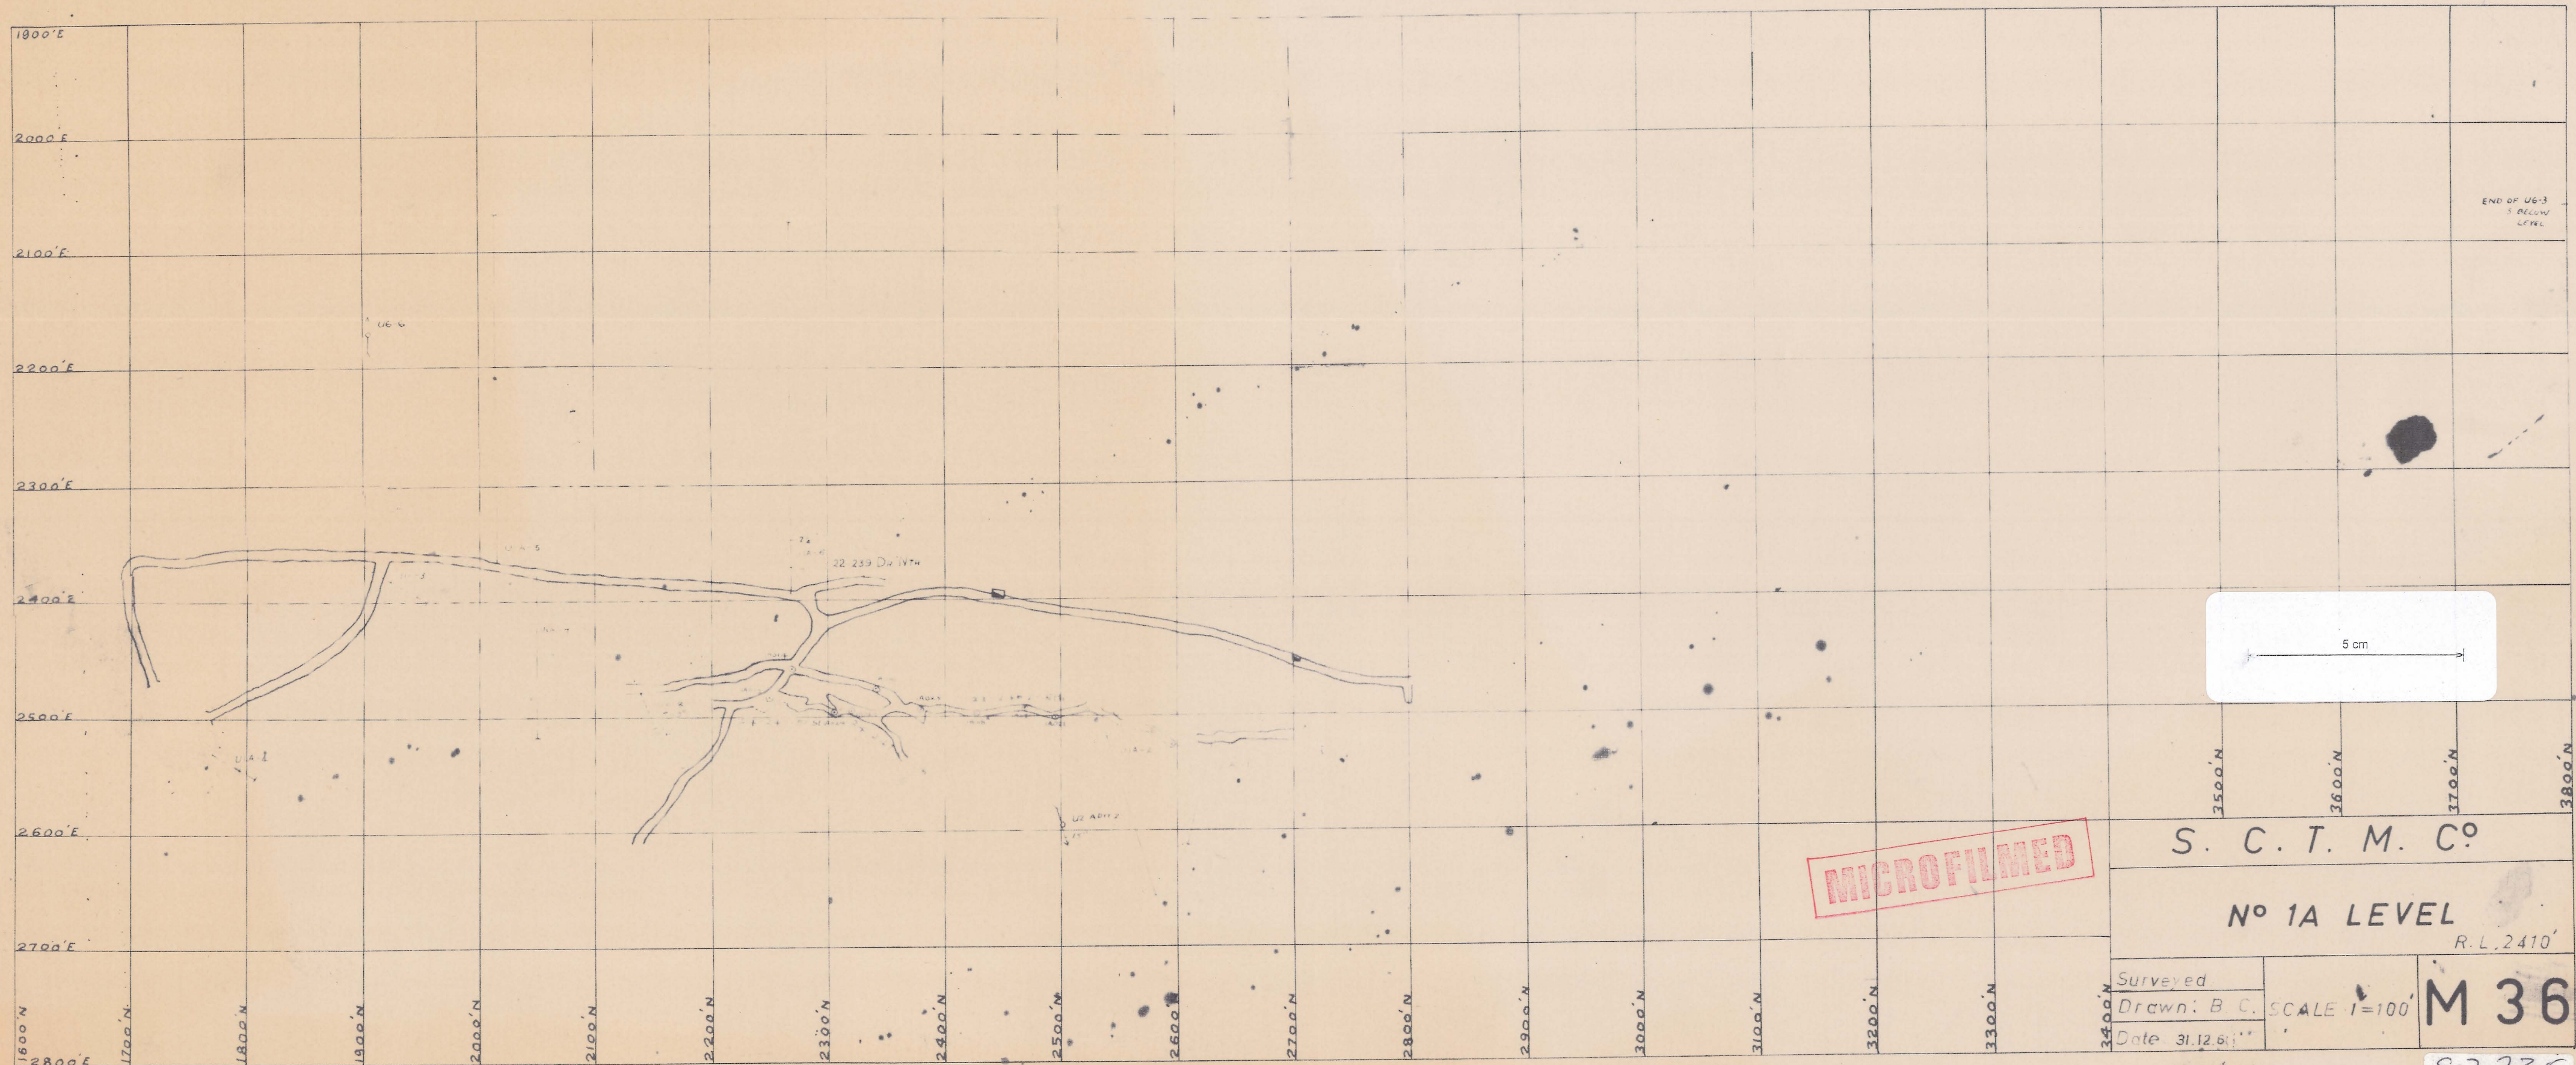

82235