


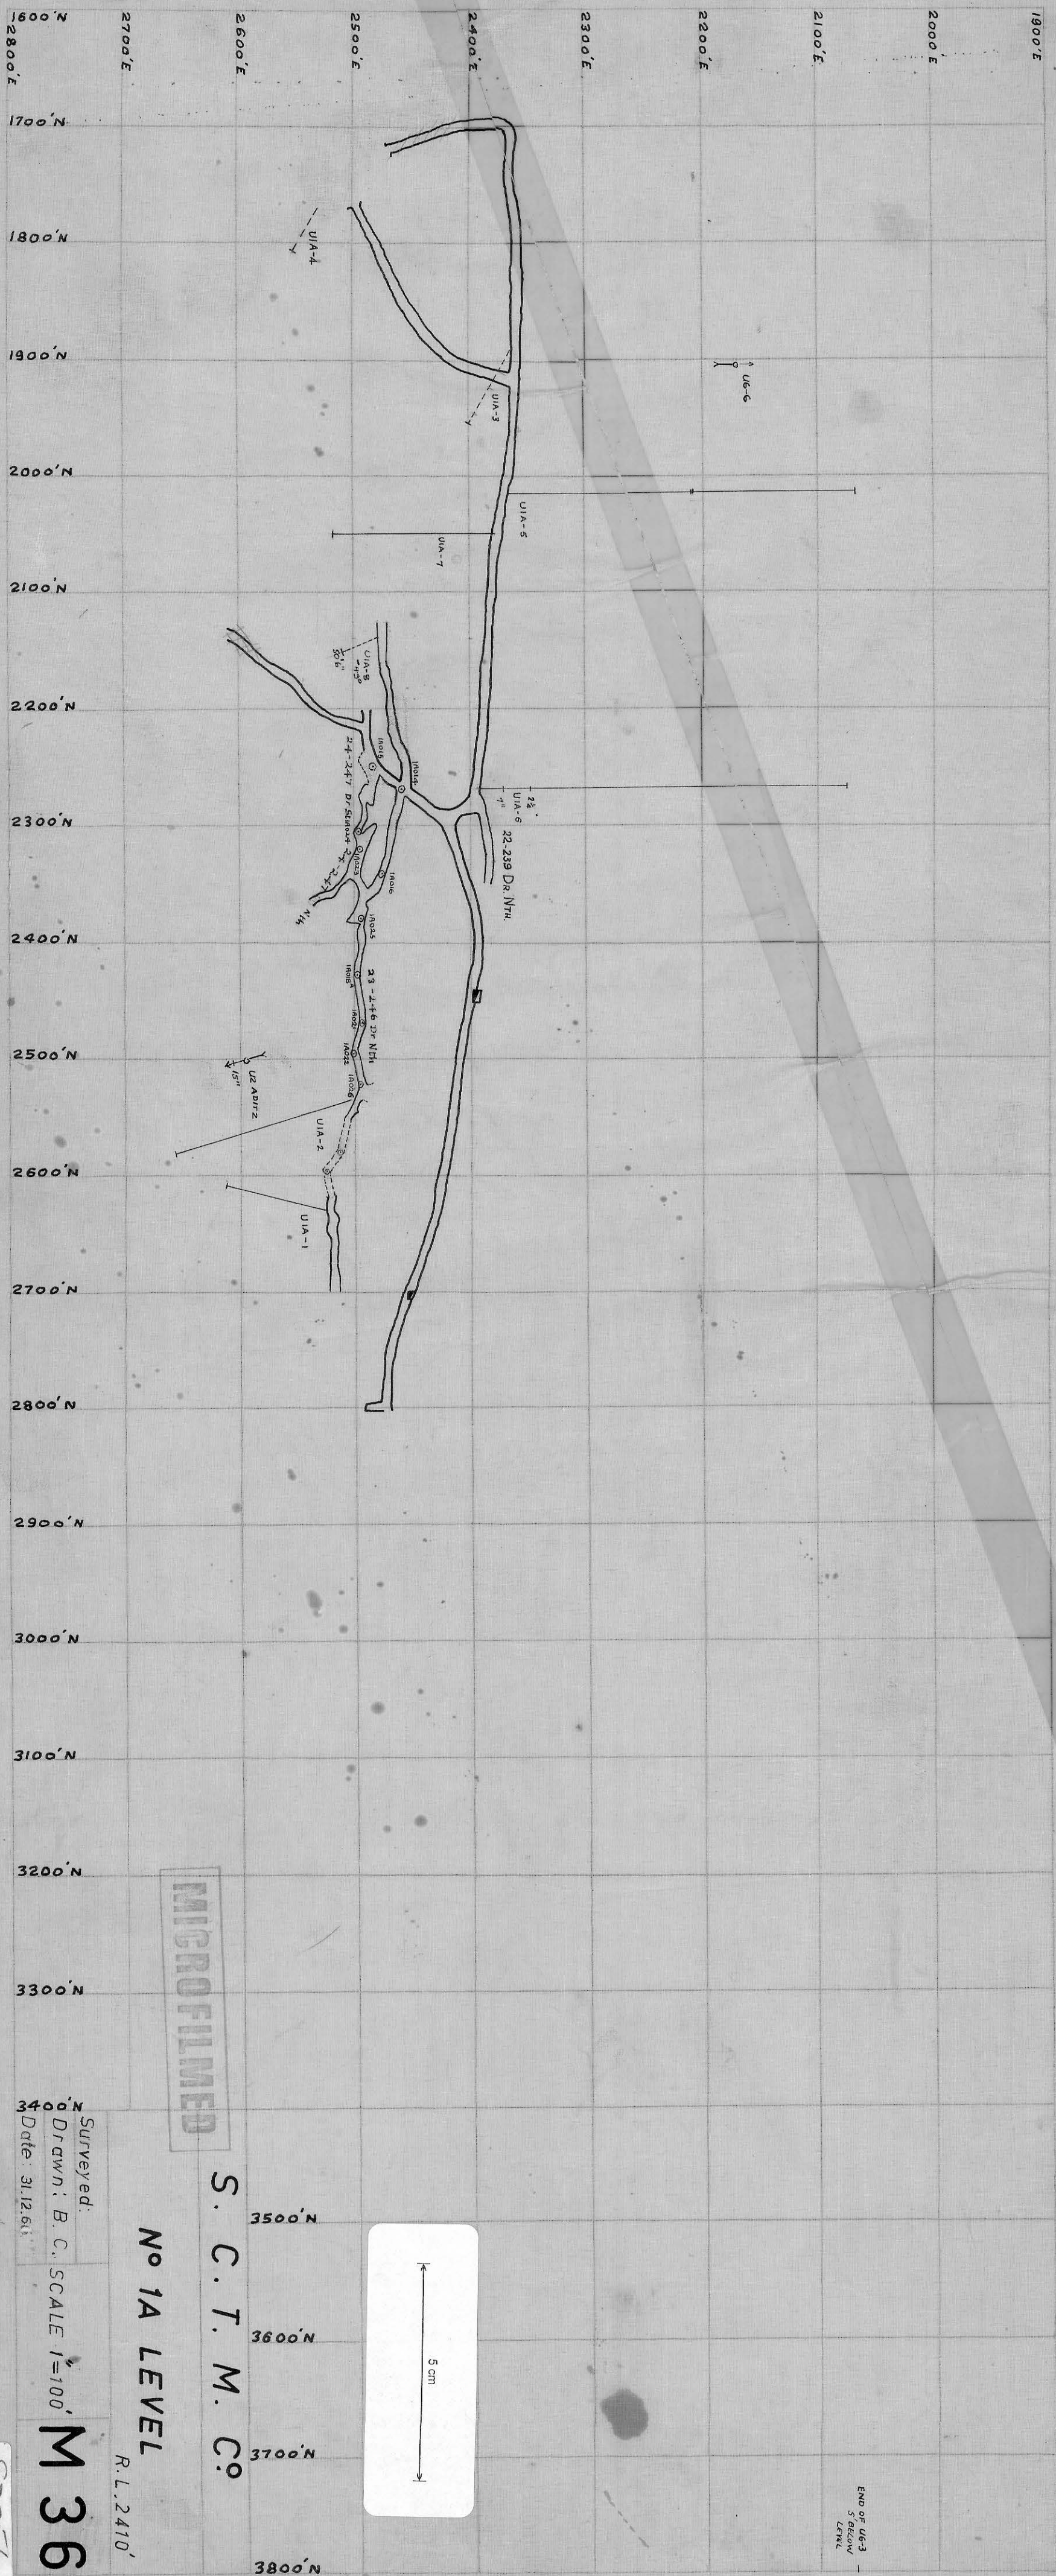

END OF U6-3
S' BELOW
LEVEL

MICROFILMED

S. C. T. M. Co.

NO 1A LEVEL

R.L. 2410'

Surveyed:

Drawn: B. C. SCALE 1"=100'

ॐ
ॐ
ॐ

82256