


10018

MICROFILMED

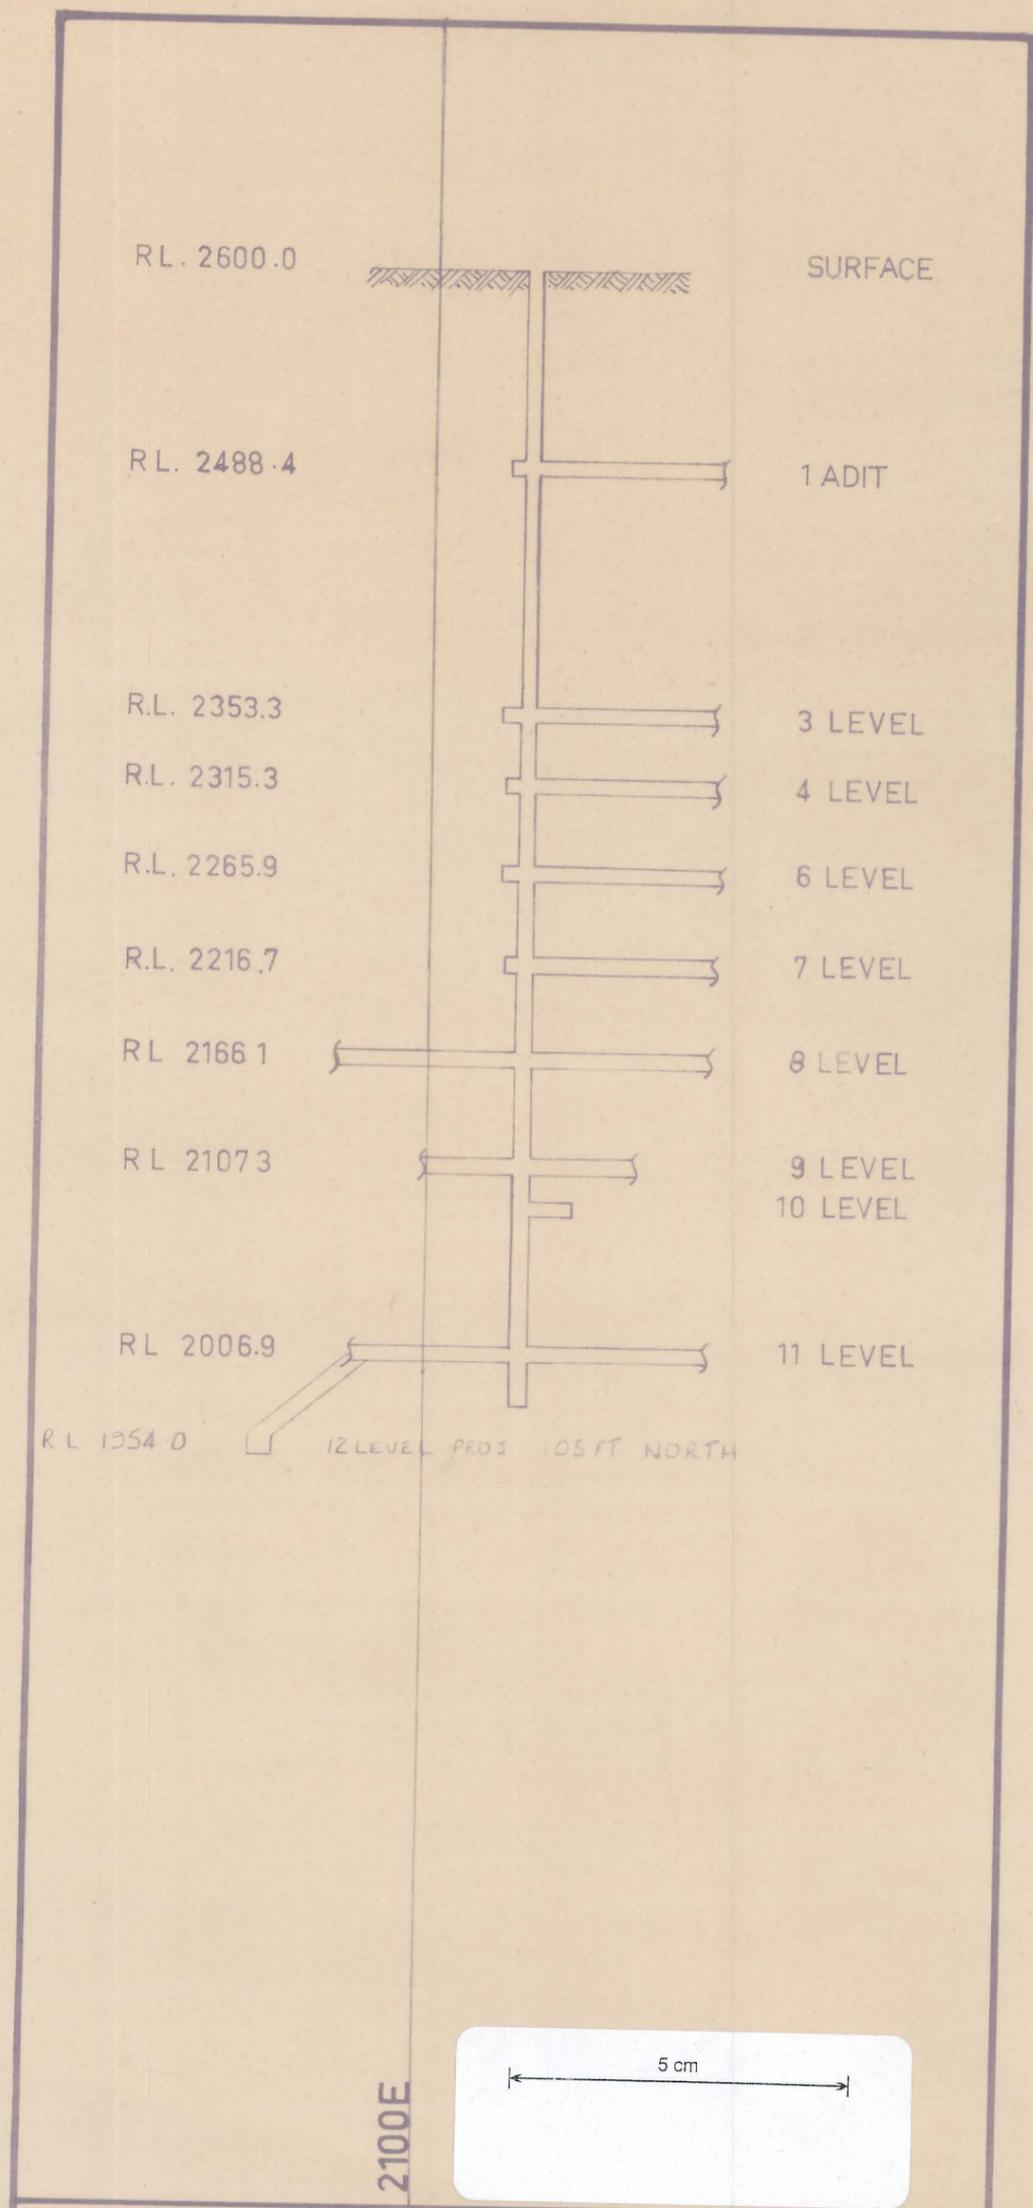

SHAFT SECTION 2905 N
LOOKING NORTH

SCALE 1 in. = 100 ft.
DATE 5-5-81.
S. C. T. M. C. N. L.

ABERF-670