


ABERF-672

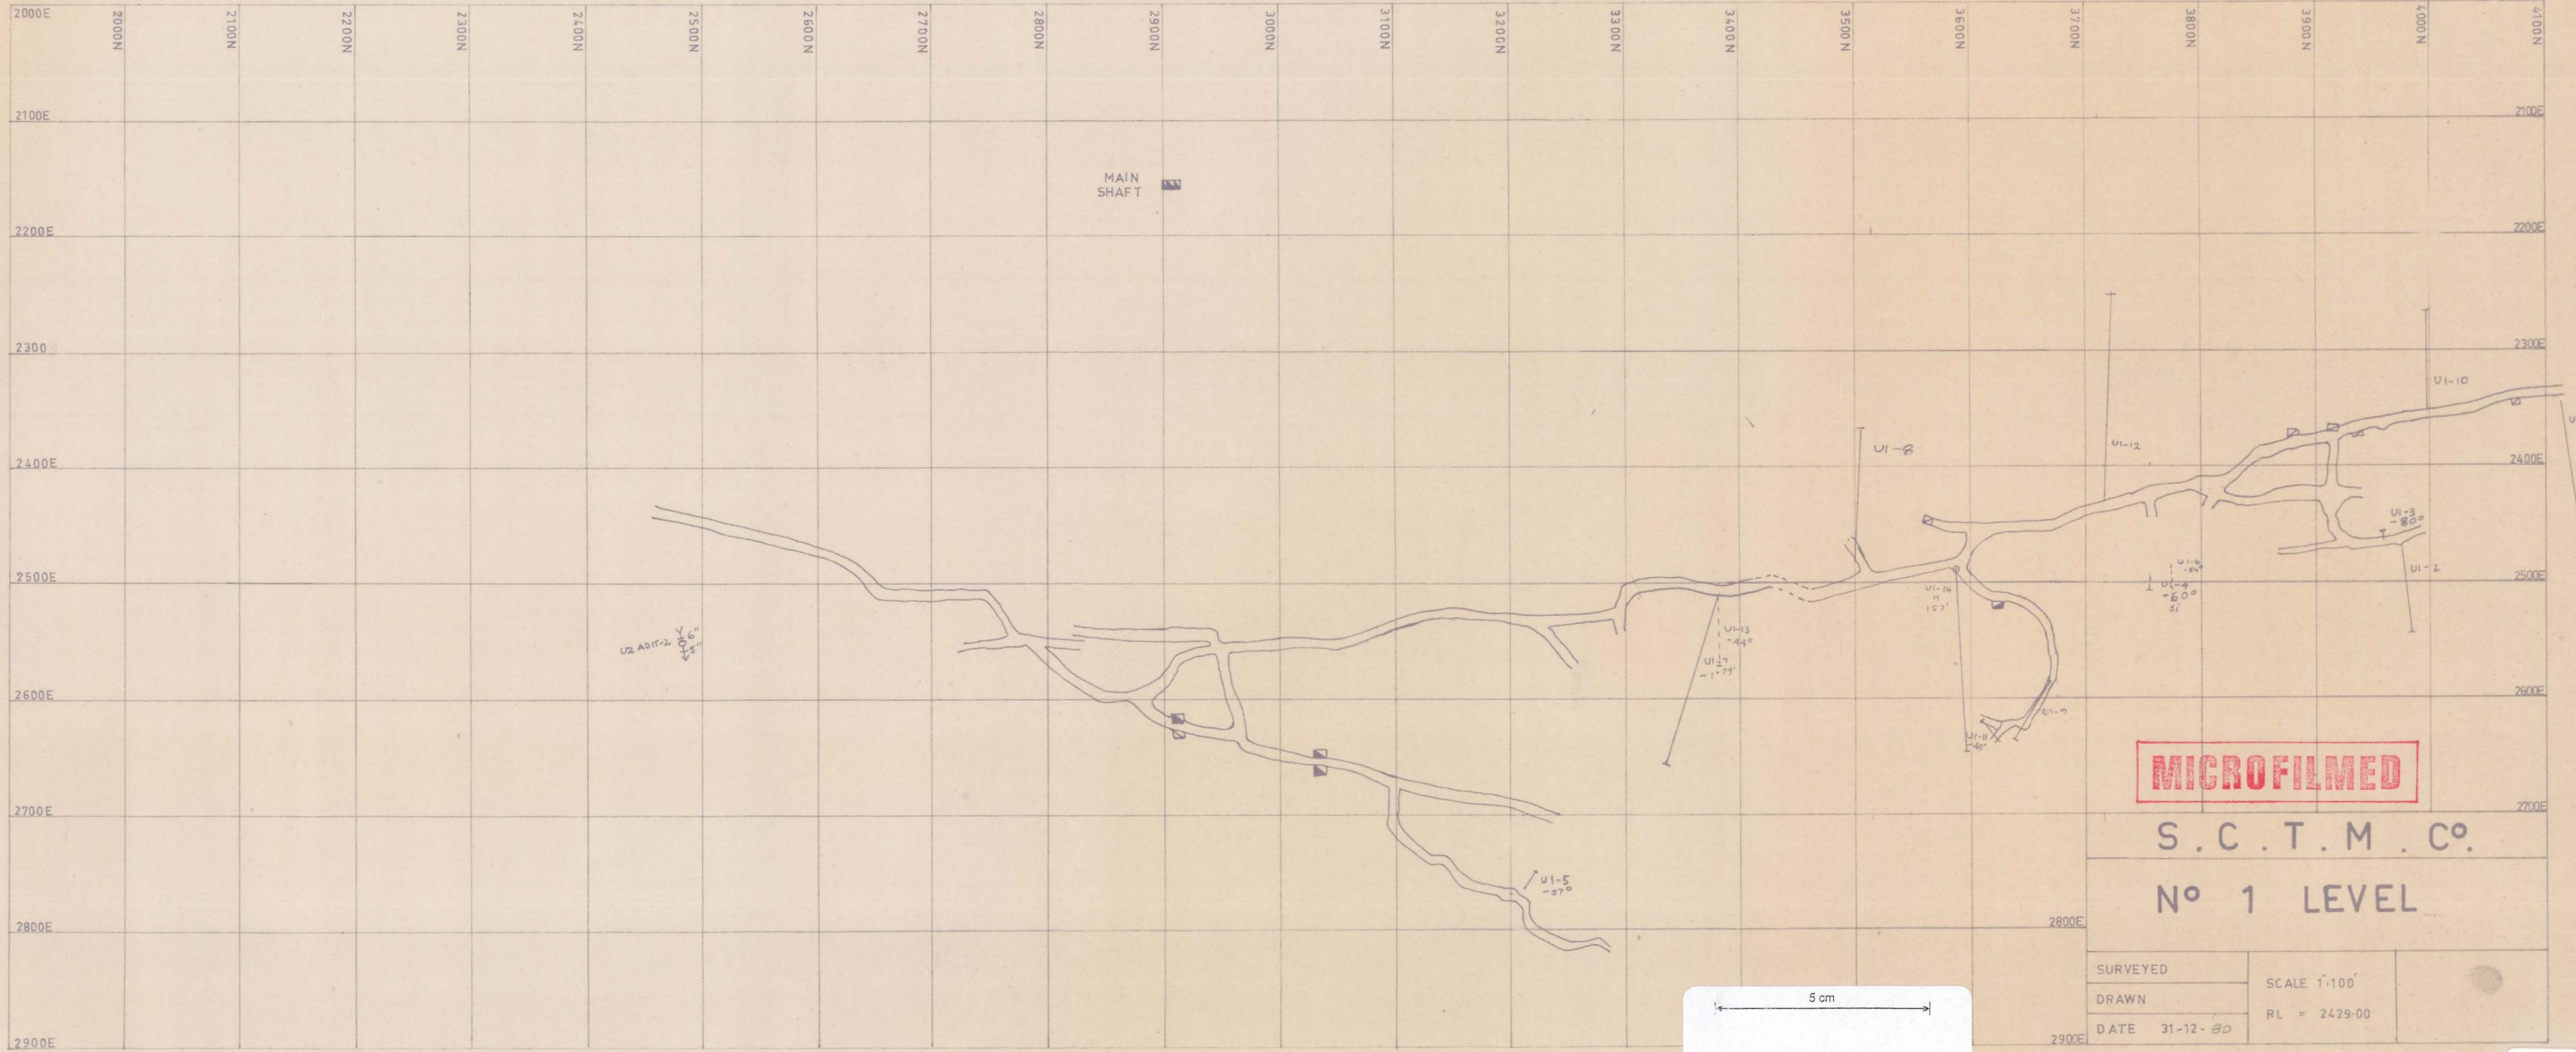

MICROFILMED

S . C . T . M . C . O .

N^o 1 LEVEL

SURVEYED	SCALE 1:100
DRAWN	RL = 2429.00
DATE 31-12-80	

UP DATED AS AT 5-5-81

81003