


ABERF-673

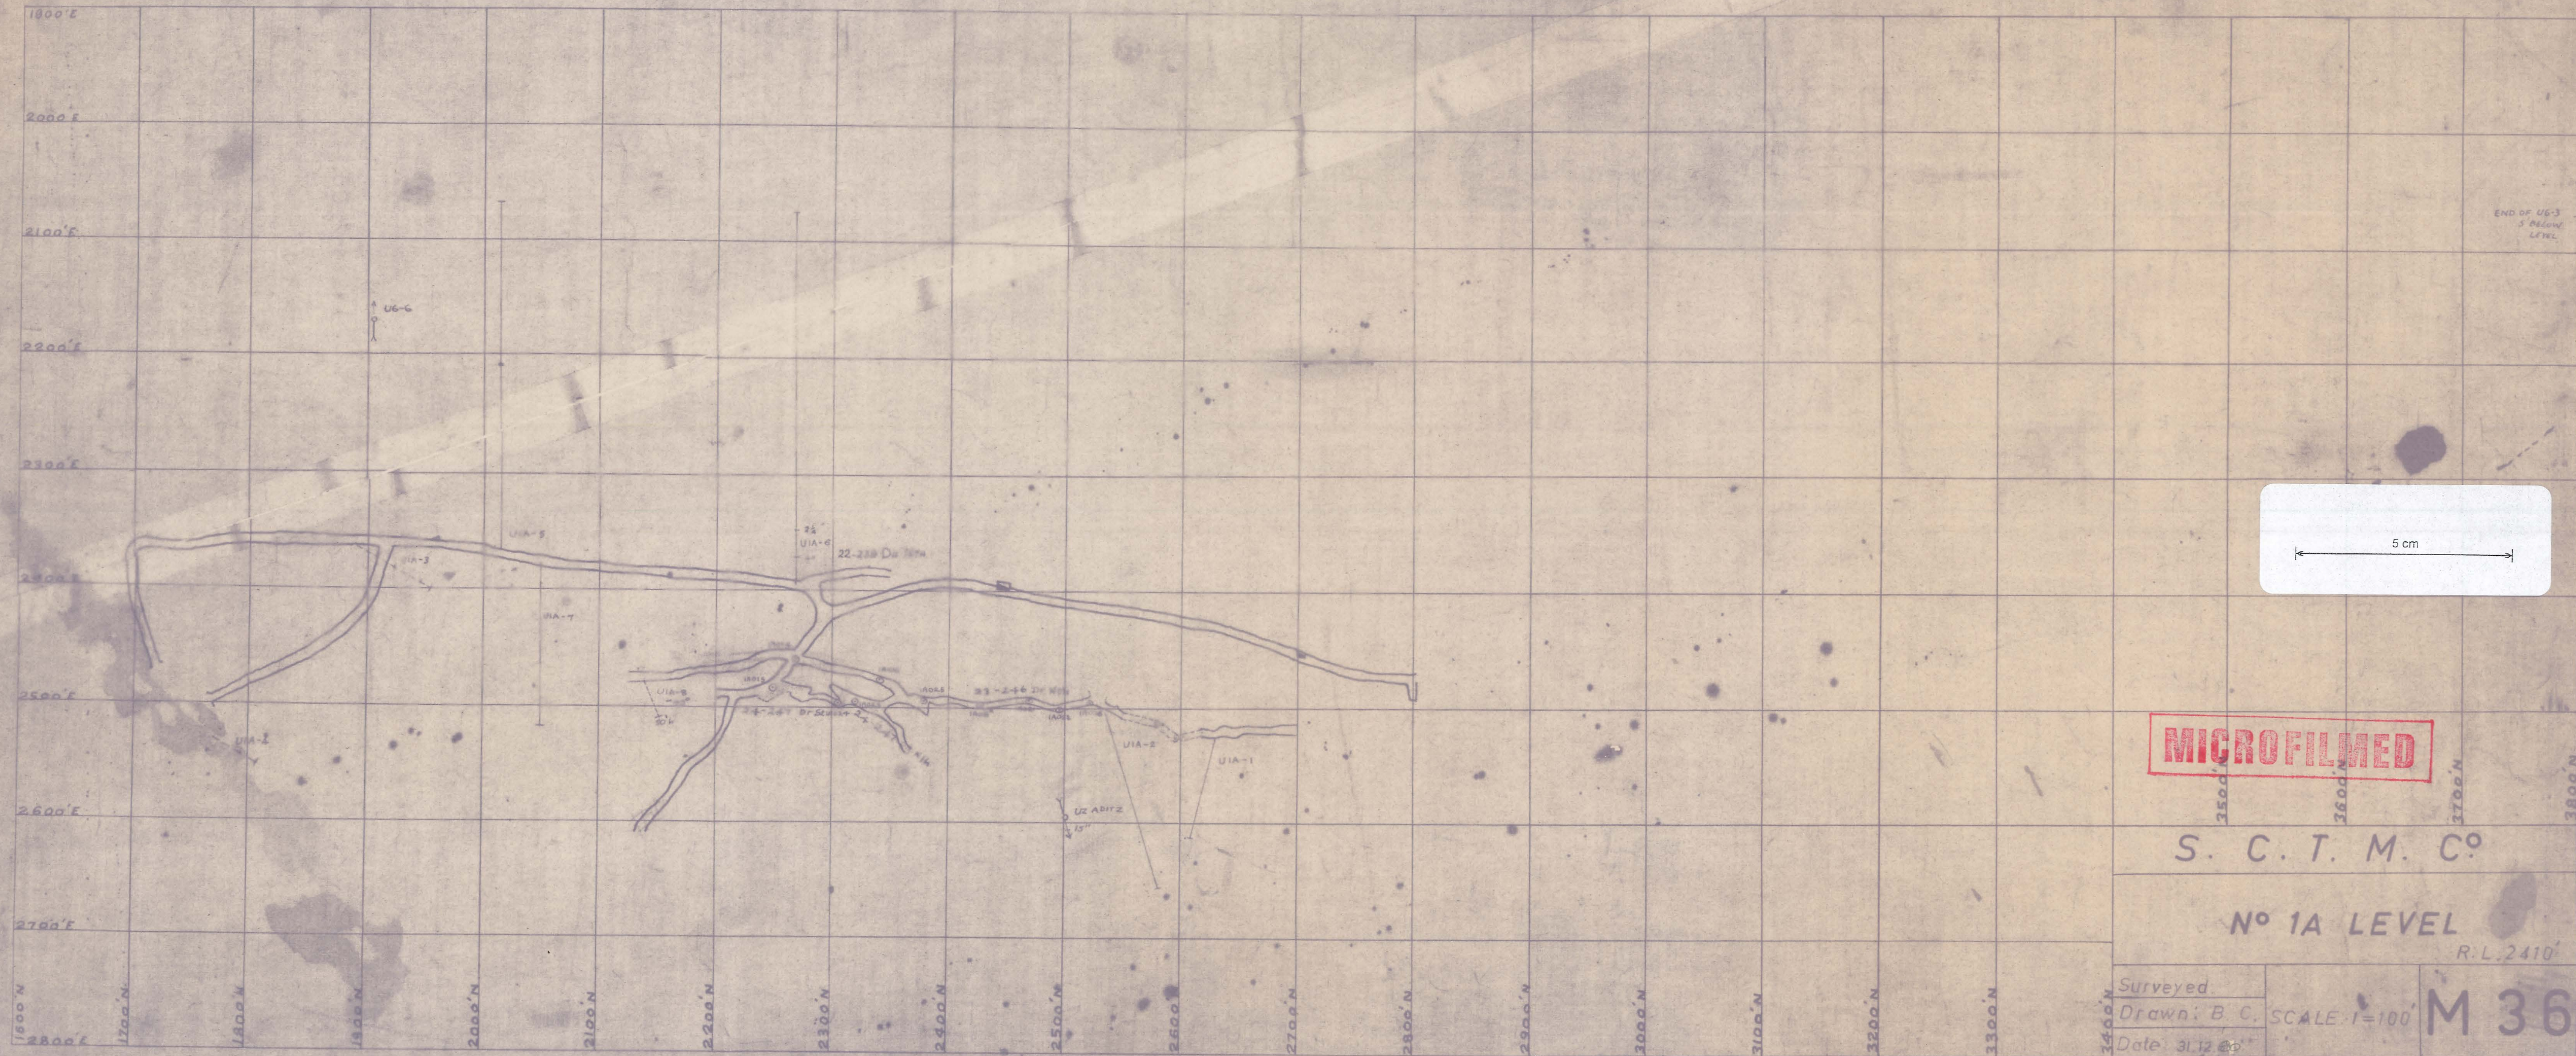

5 cm

MICROFILMED

S. C. T. M. Co

Nº 1A LEVEL

R.L. 2410'

Surveyed.
Drawn: B. C.
Date: 31.12.80

SCALE: 1=100'

M 36

UP DATED AS AT 5-5-81

81004