


ABERF-675

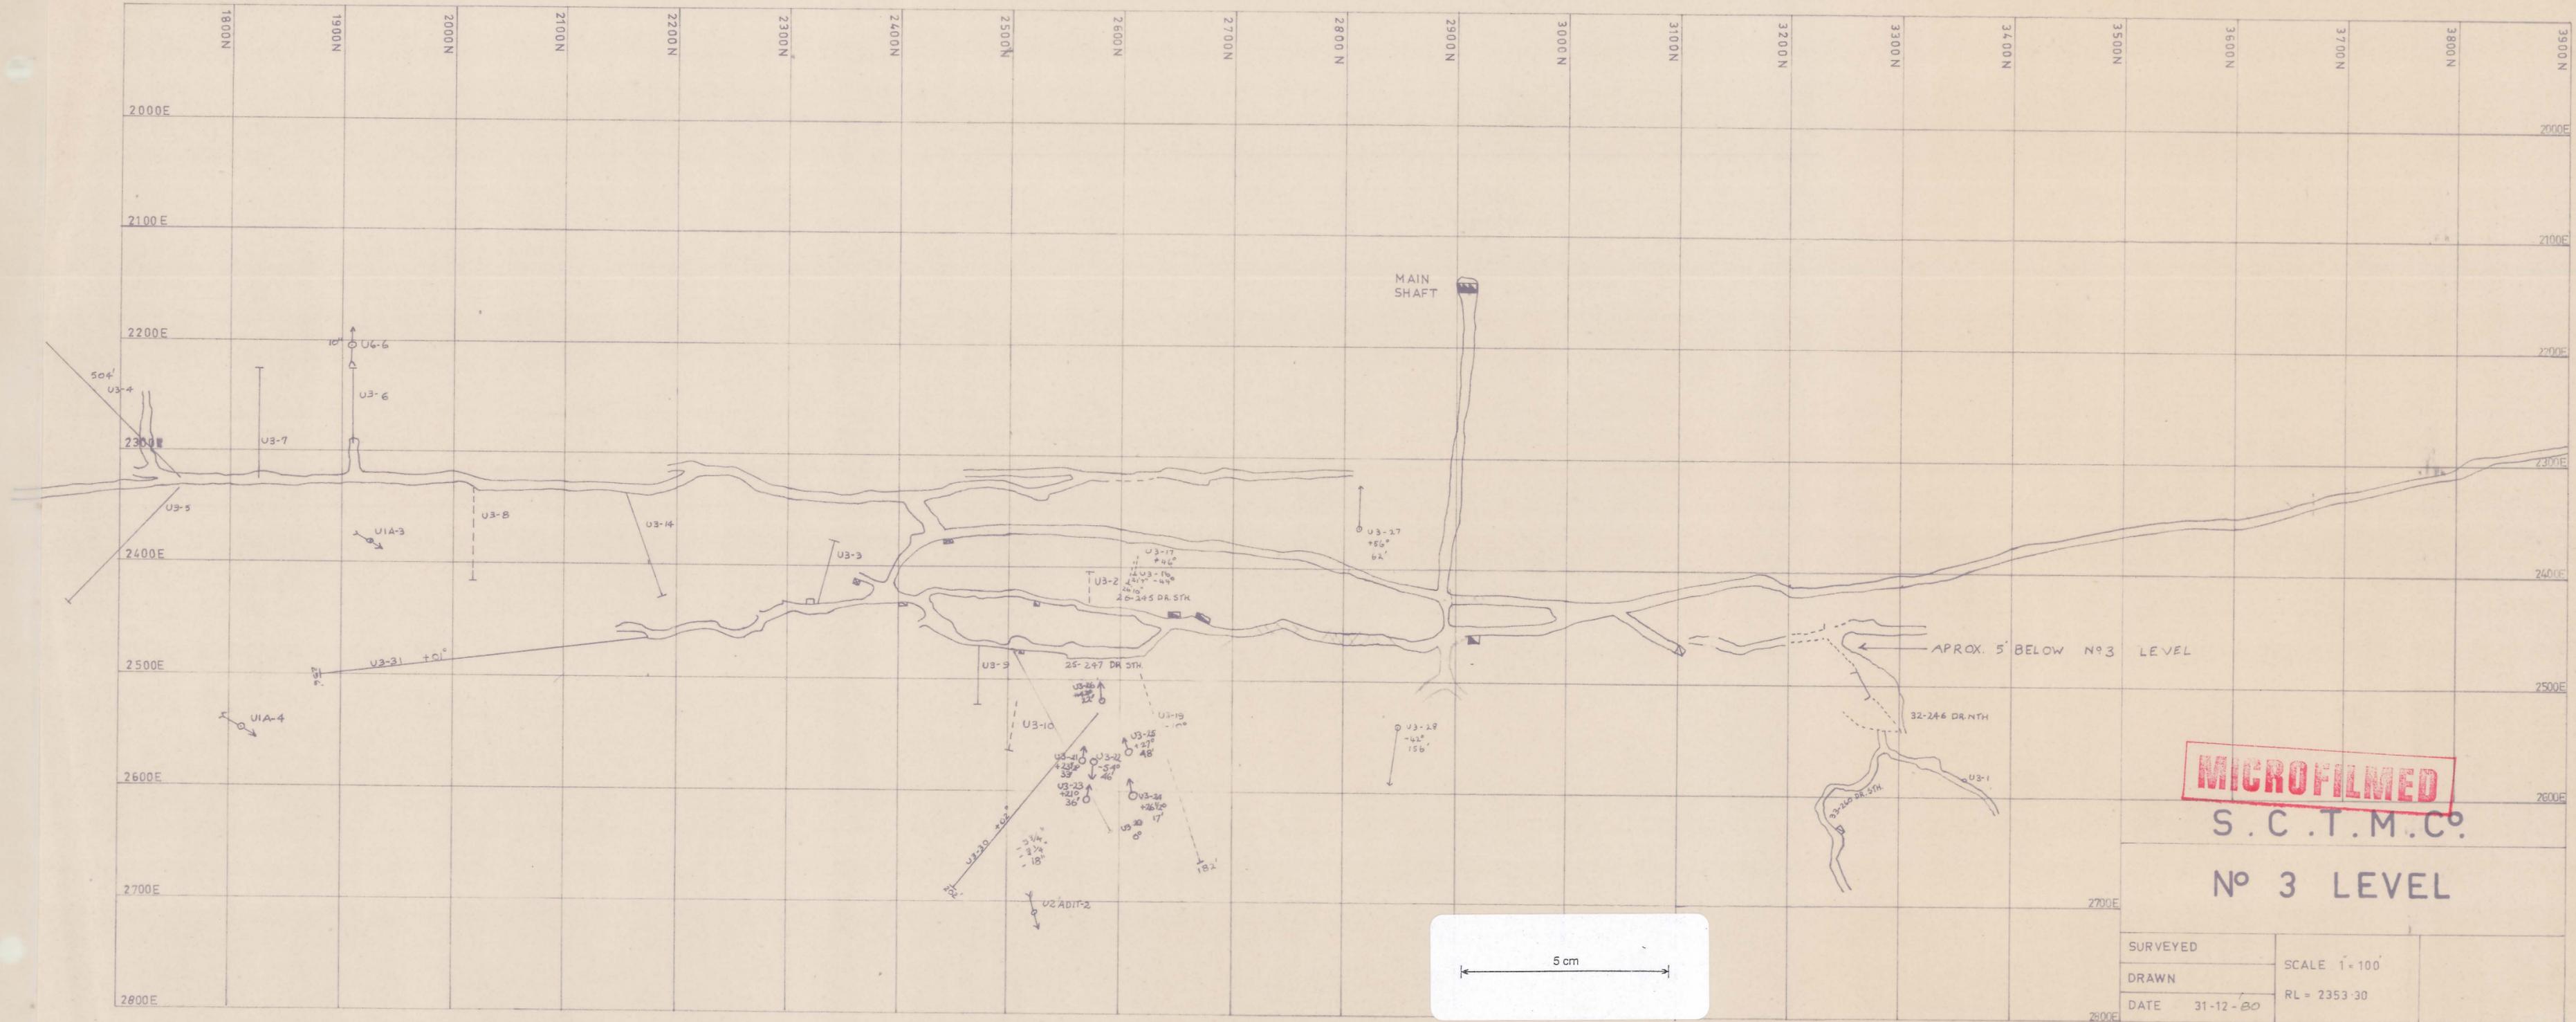

MICROFILMED

S.C.T.M.C.

N° 3 LEVEL

SURVEYED	SCALE 1:100 RL = 2353.30
DRAWN	
DATE 31-12-80	

UP DATED AS AT 5-5-81

81006