


ABERF - 676

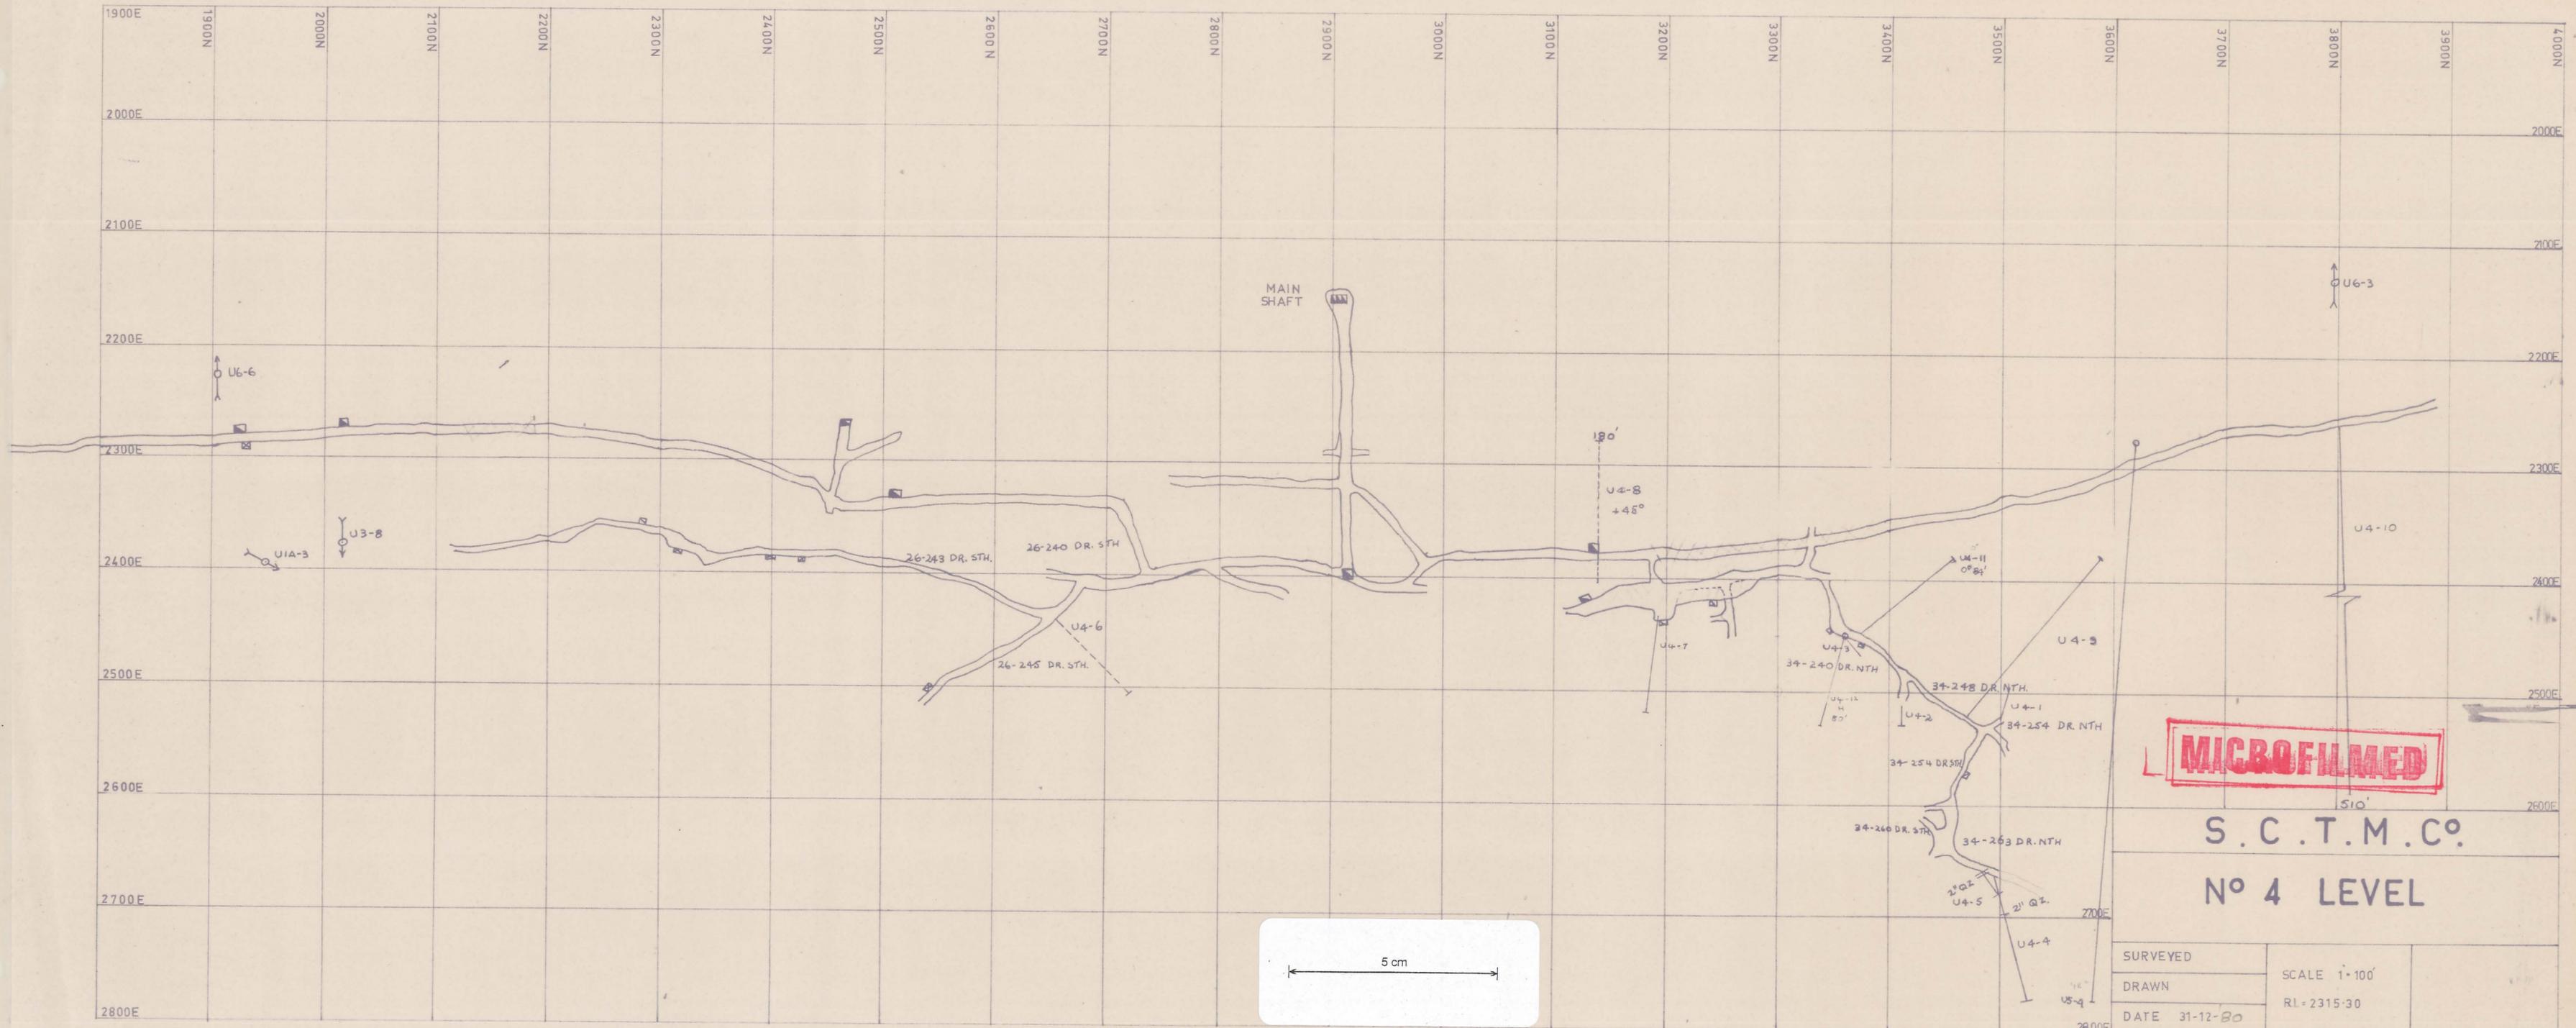

**MICROFILMED**

S.C.T.M.C.º  
Nº 4 LEVEL

SURVEYED	SCALE 1:100'
DRAWN	RI - 2315-30
DATE 31-12-80	

UPDATED AS AT 5-5-81

81007