


ABERF - 677

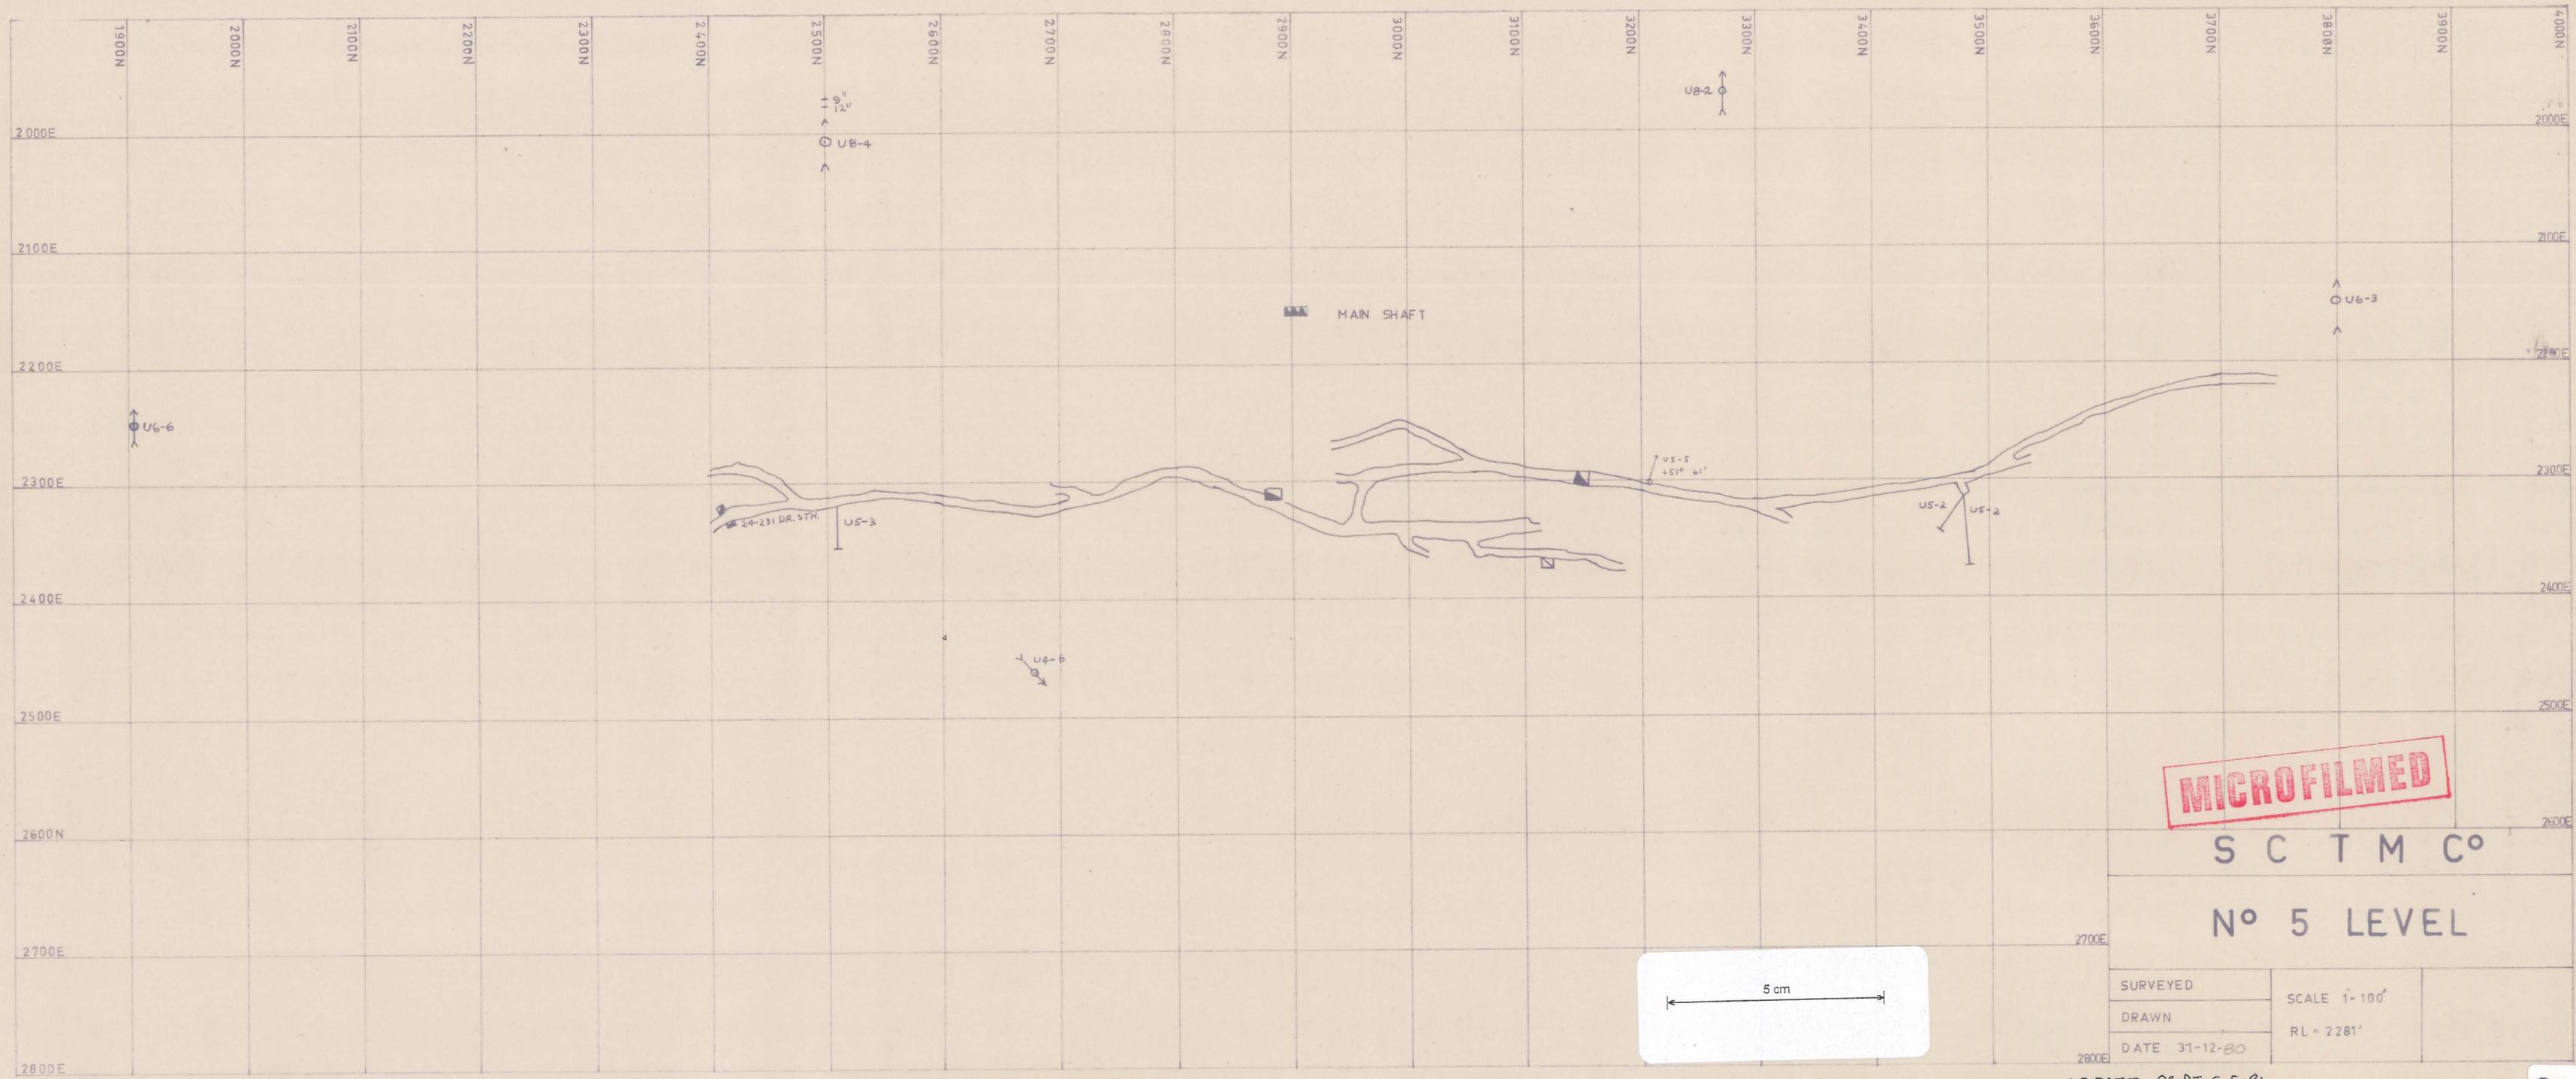

MICROFILMED

S C T M C°

N° 5 LEVEL

SURVEYED	SCALE 1"=100'
DRAWN	RL = 2281'
DATE 31-12-80	

UP DATED AS AT 5-5-81

81008