


ABEP-679

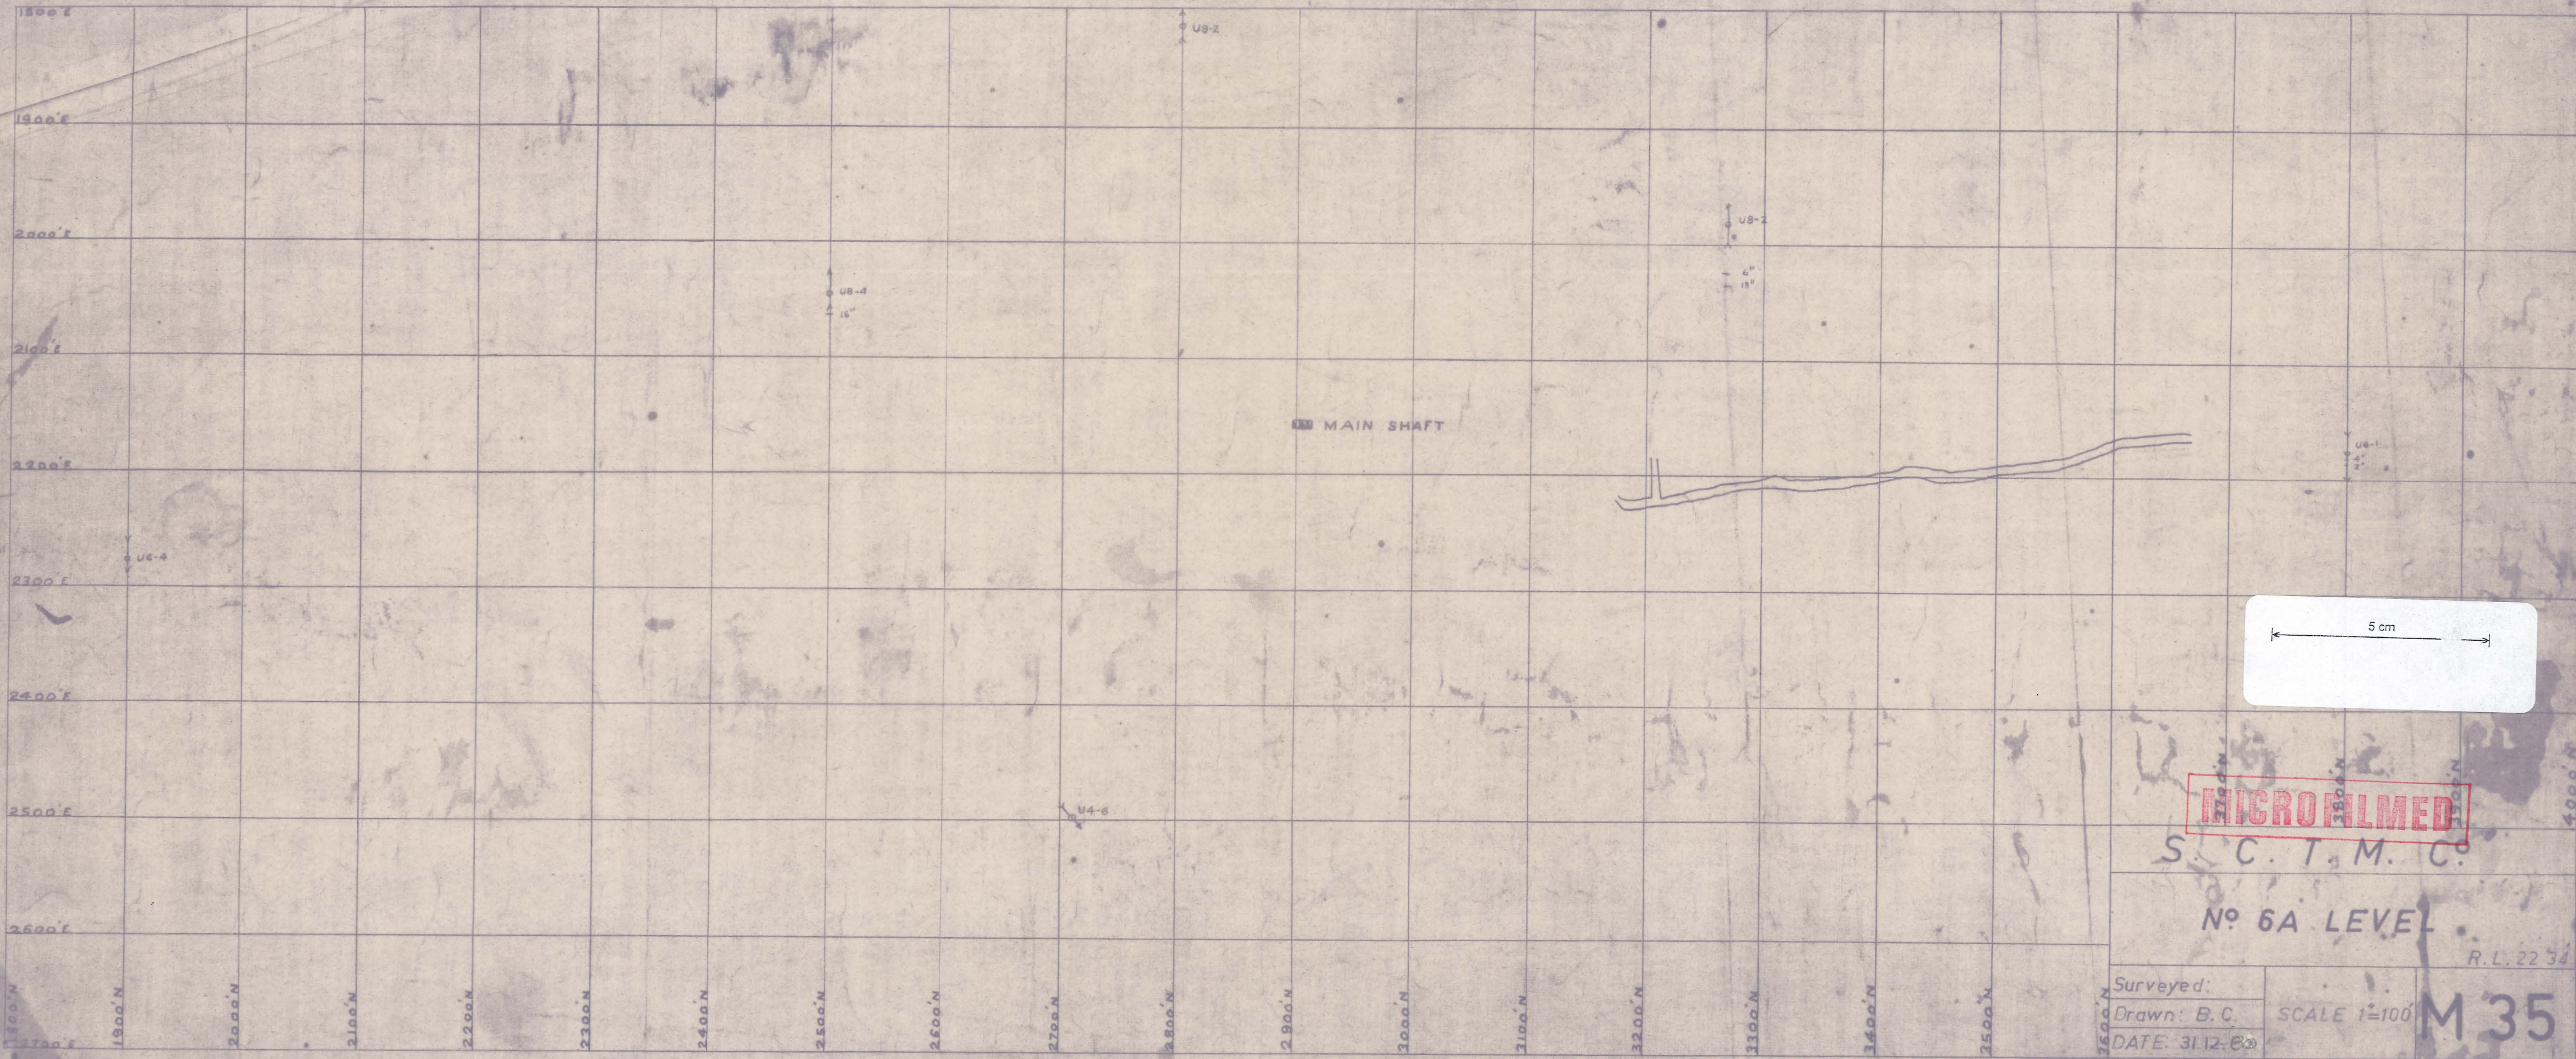

MICROFILMED

S. C. T. M. C.

No 6A LEVEL

R.L. 22 34

Surveyed:
Drawn: B.C.
DATE: 31.12.80

SCALE 1"=100'

M 35

UPDATED AS AT 5-5-81

81010