
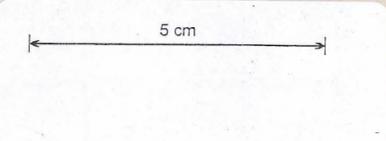


ABERF - 680

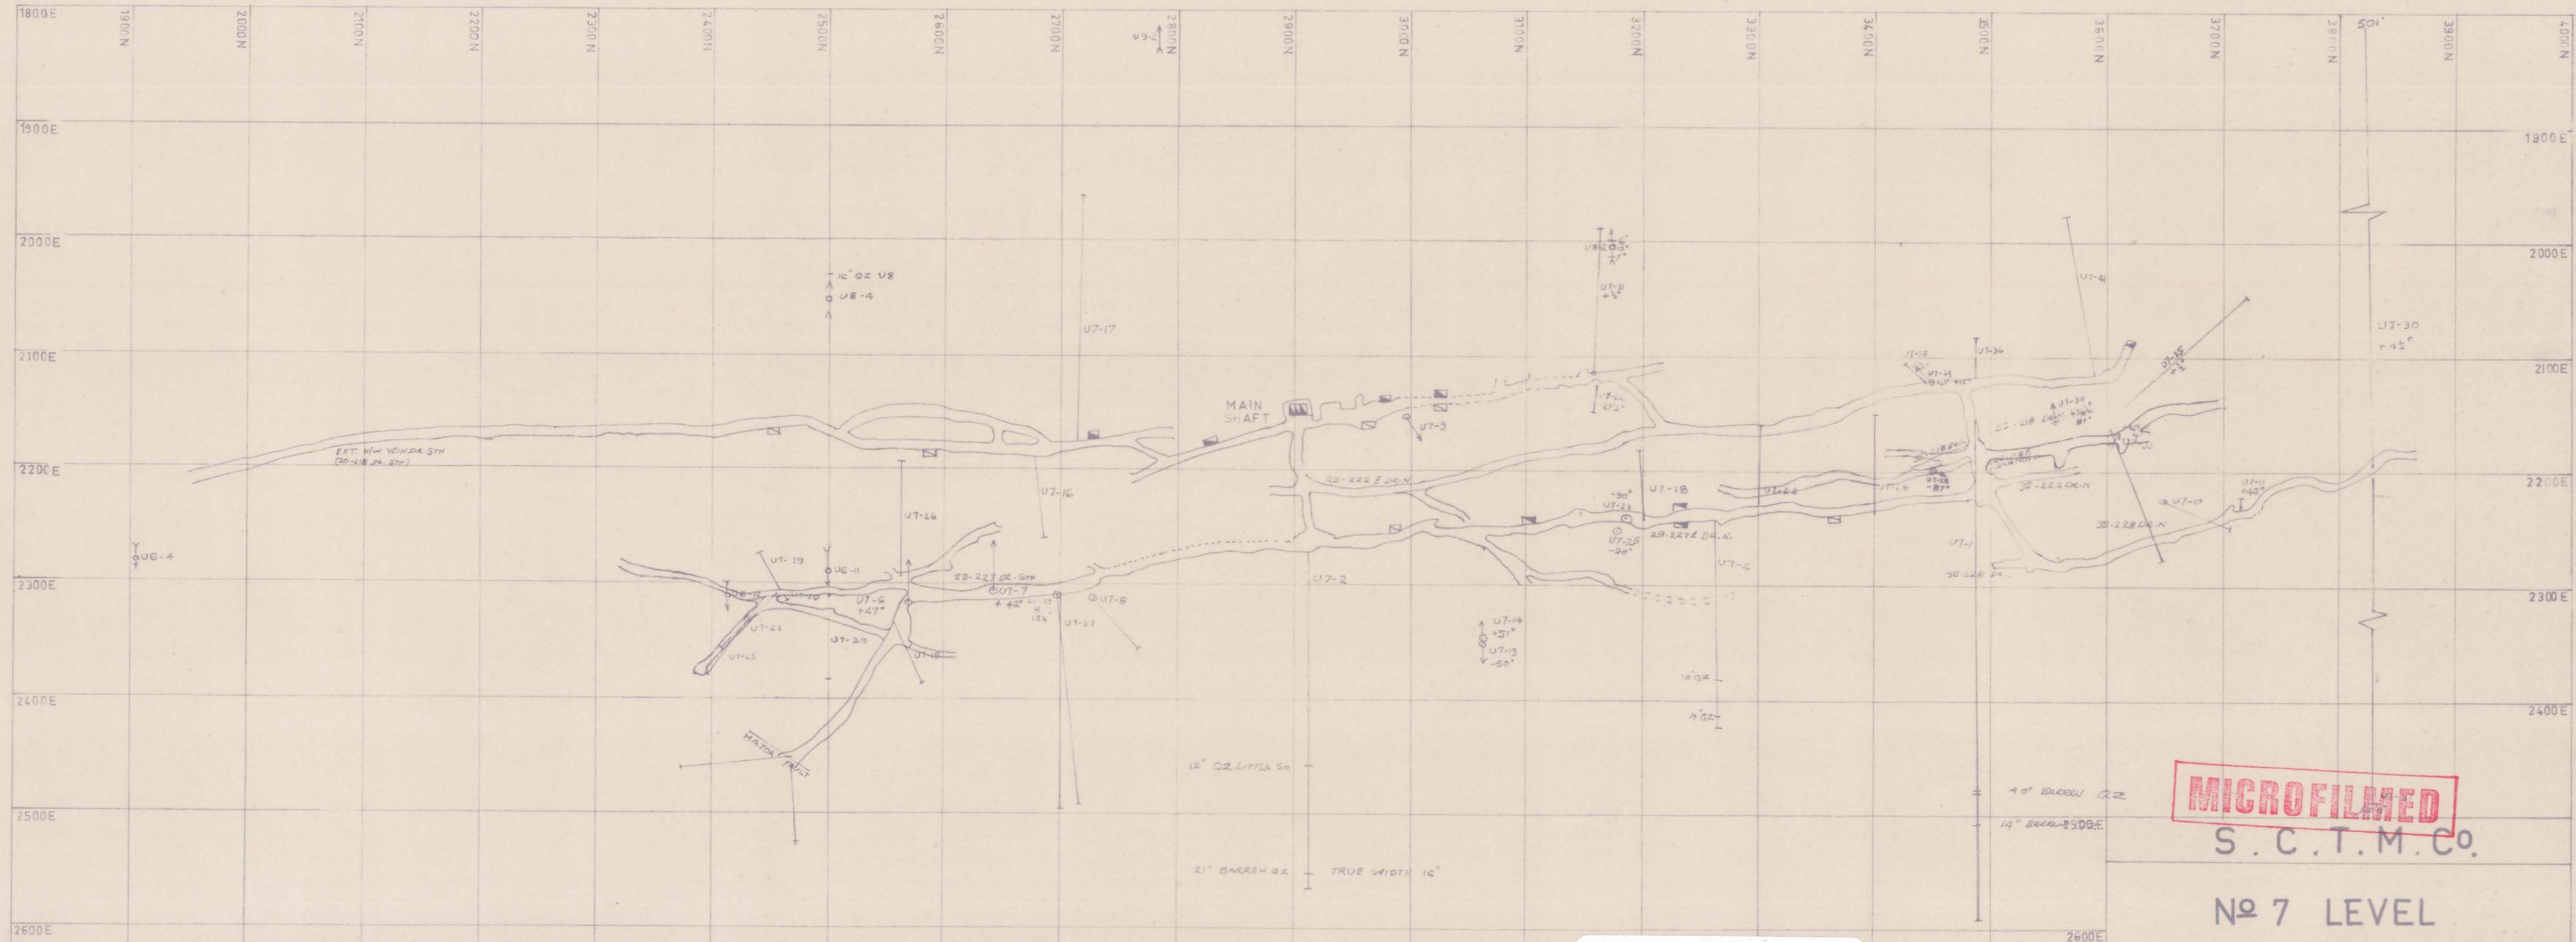

**MICROFILMED**

S. C. T. M. Co.

No 7 LEVEL

SURVEYED	SCALE 1"=100'	M 20
DRAWN	RL = 2216.69	
DATE 31-12-80		

UPDATED AS AT 5-5-81

8101