


ABERF - 681

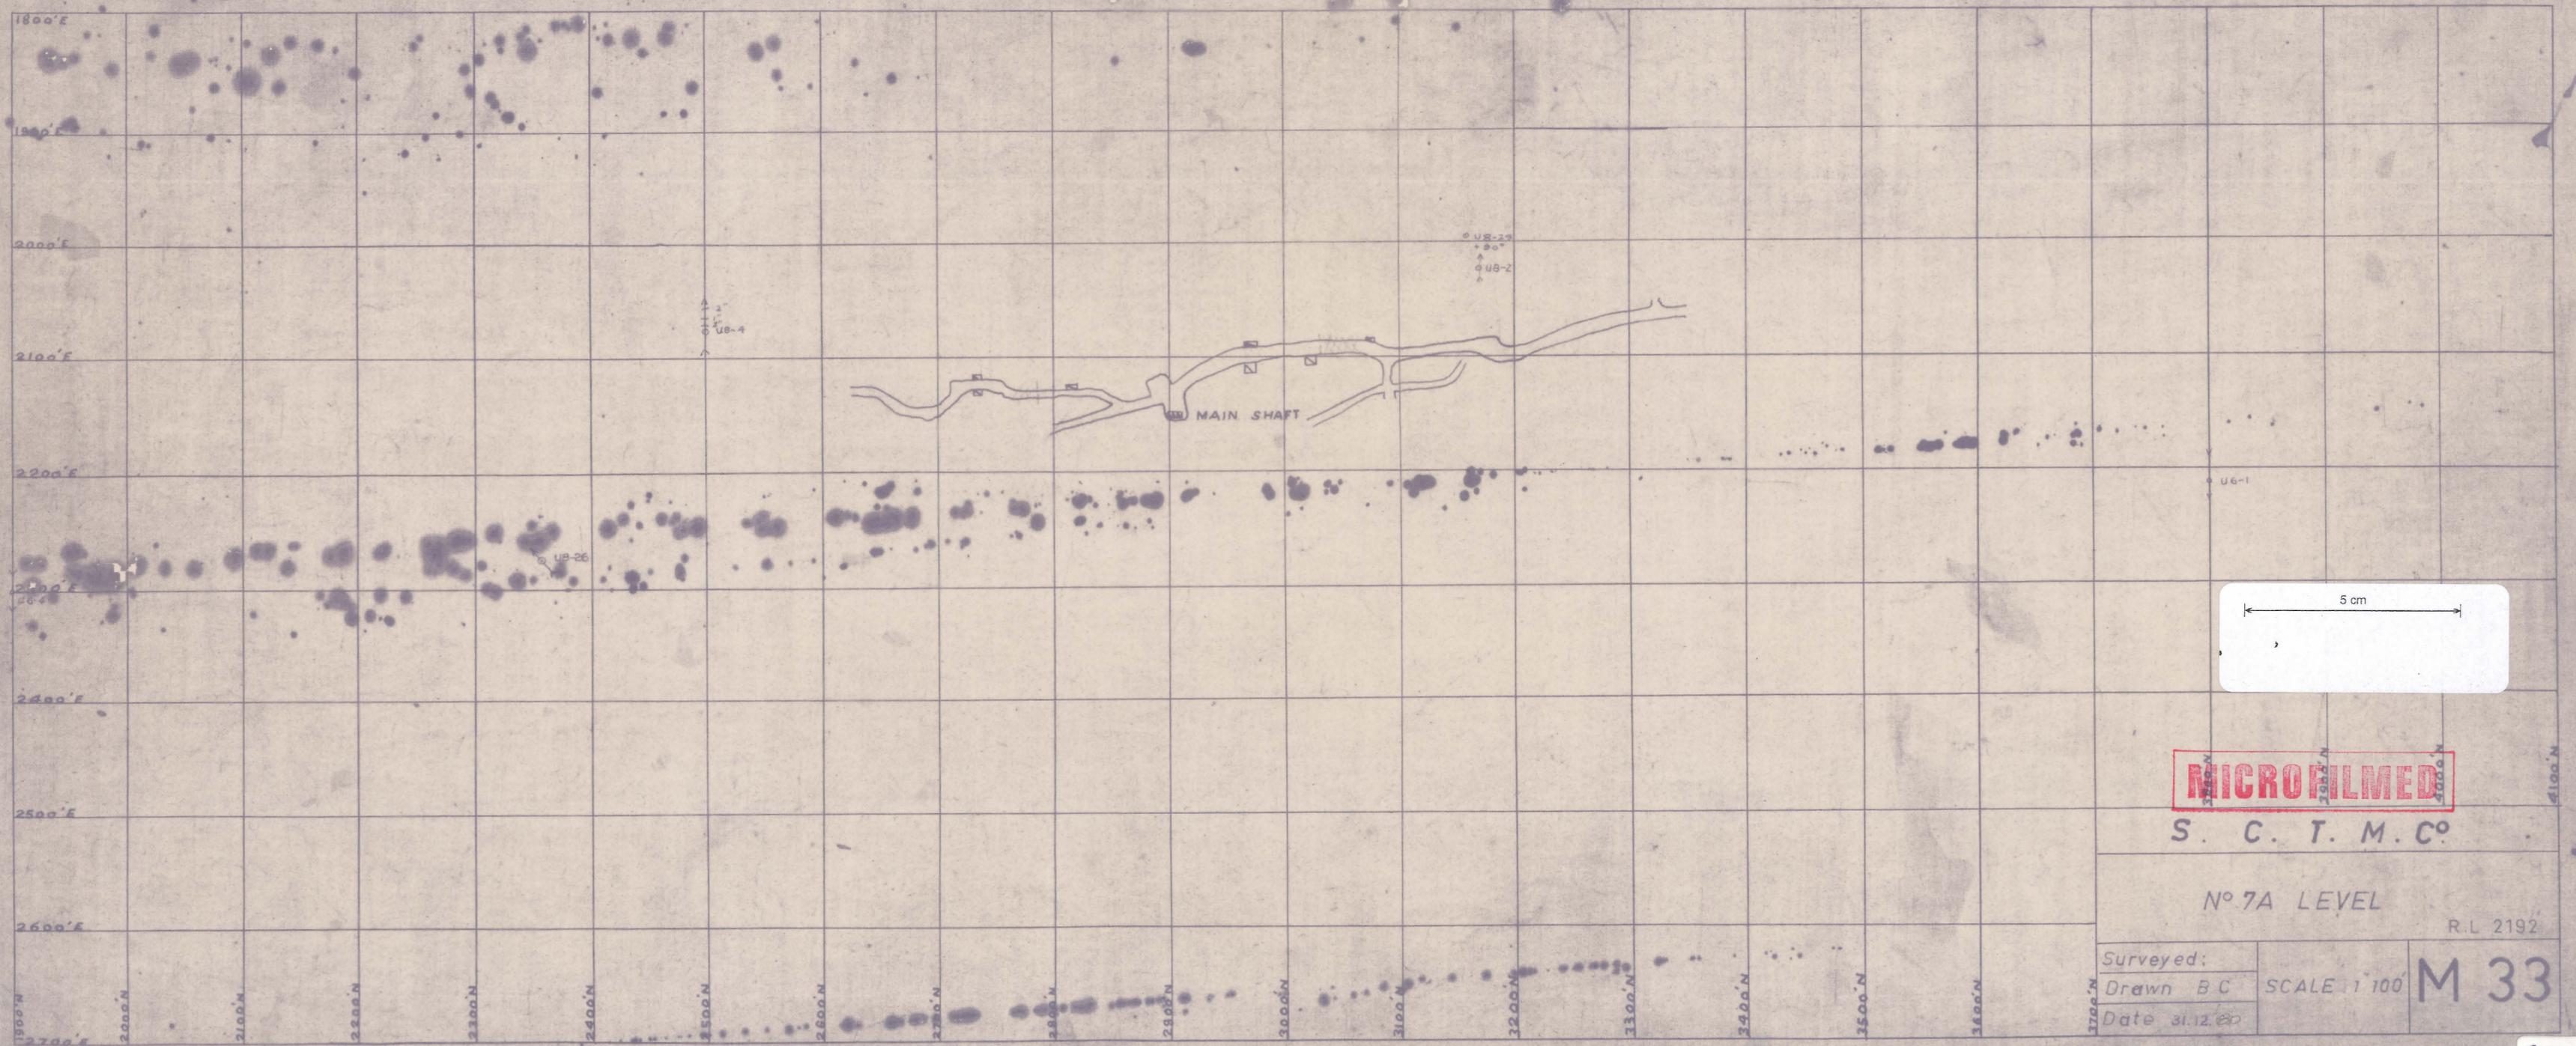

MICROFILMED

S. C. T. M. C.

Nº 7A LEVEL

R.L. 2192

Surveyed:
 Drawn B.C.
 Date 31.12.80

SCALE 1" = 100'

M 33

UP DATED AS AT 5-5-81

81012