


ABERF-682



**MICROFILMED**

S.C.T.M.Co.N.L.

No 8 LEVEL

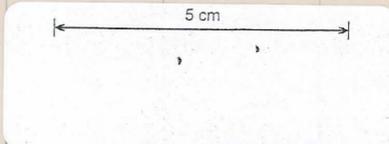

SURVEYED,	SCALE: 1" = 100'
DRAWN,	RL = 2166-13
DATE: 31-12-80	

UP DATED AS AT 5-5-81

81014