


ABERF-687

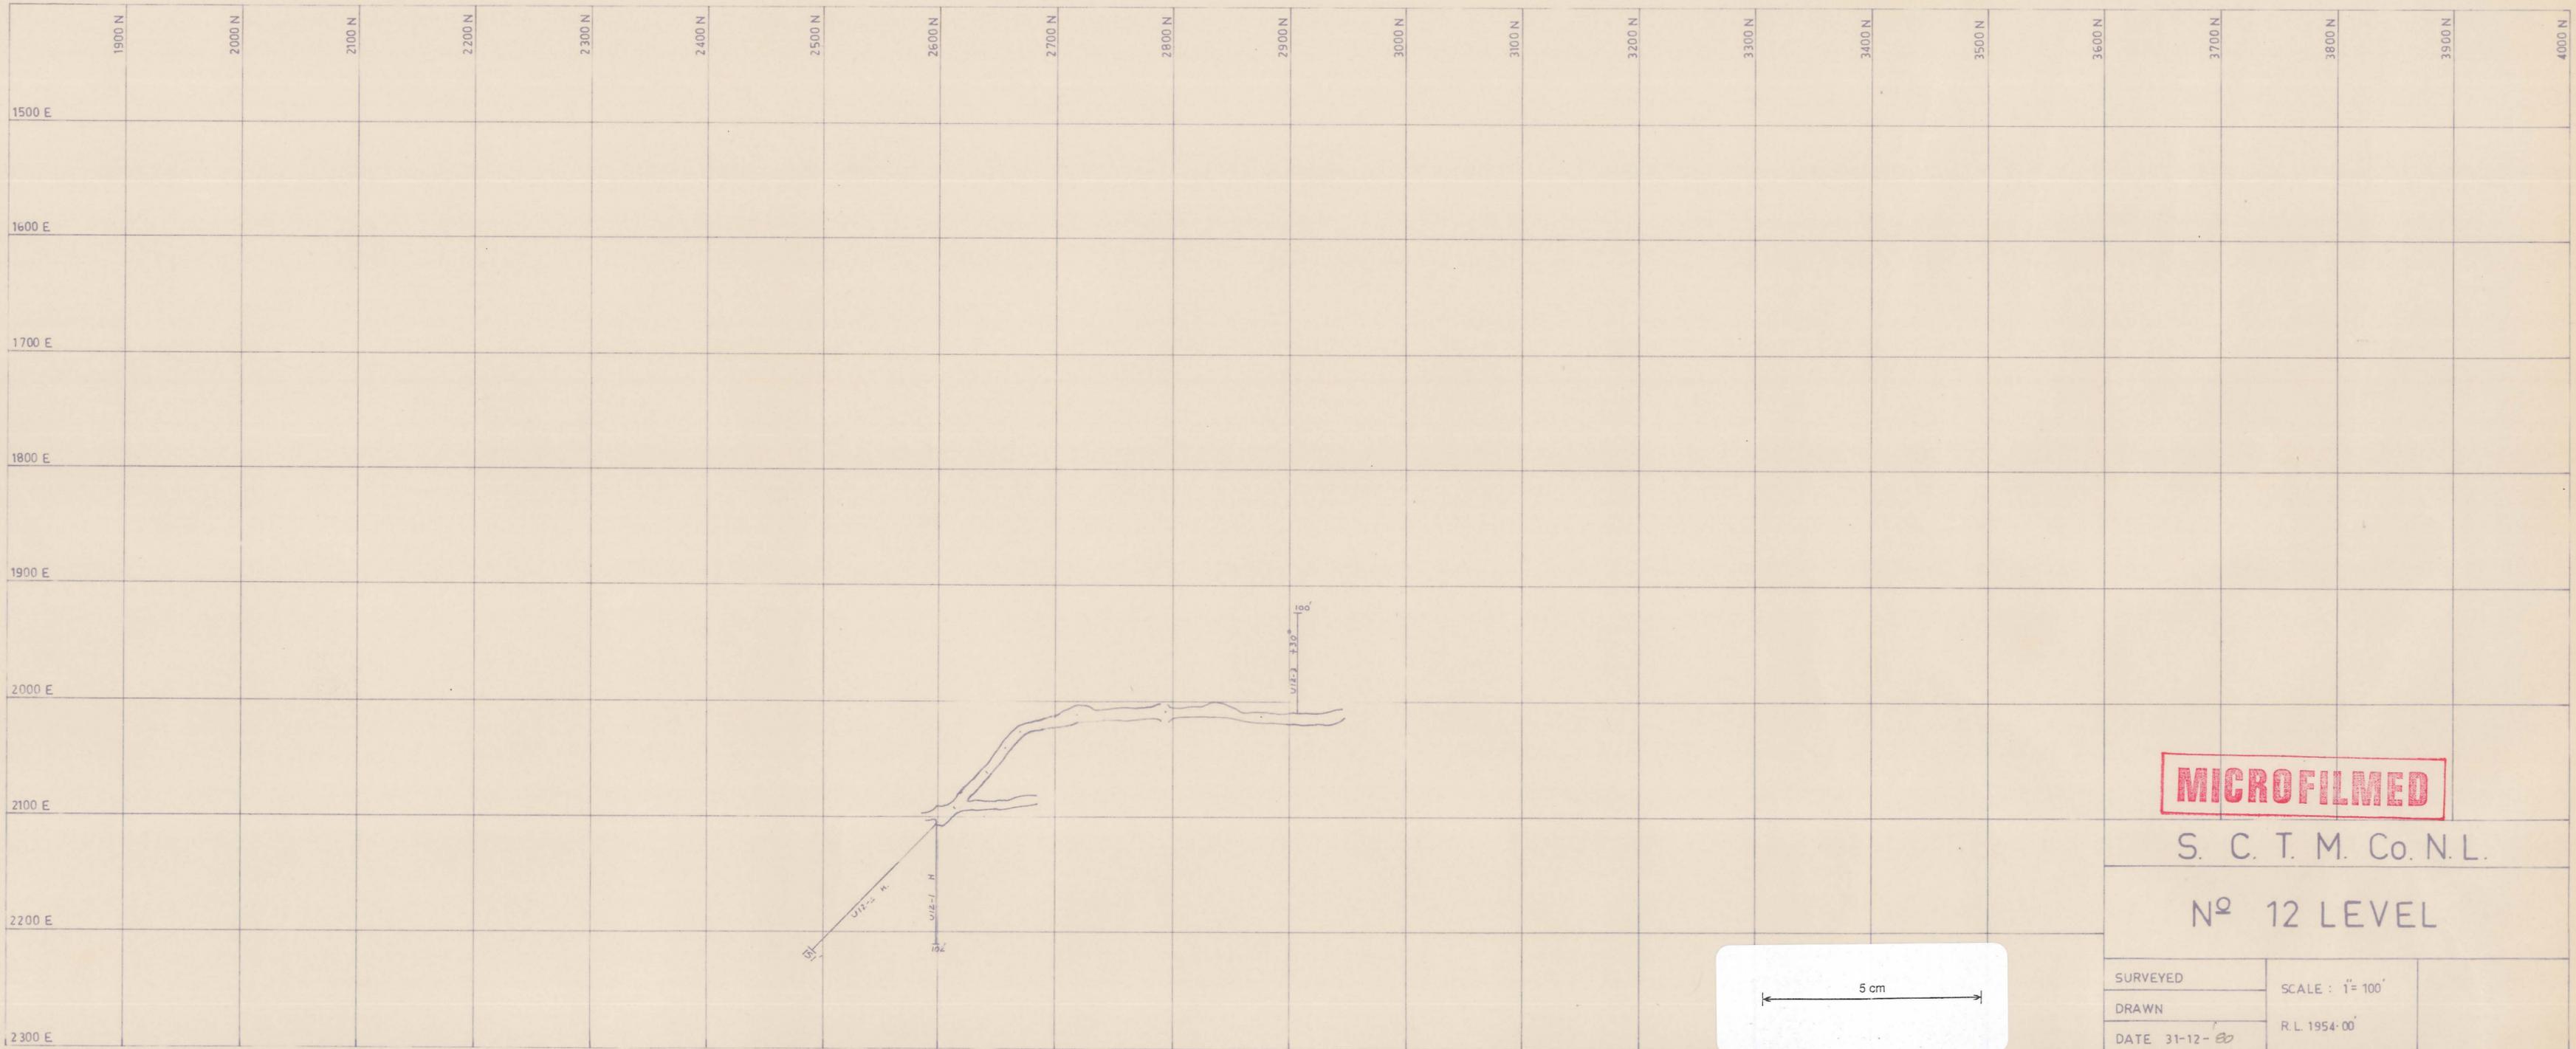


**MICROFILMED**

S. C. T. M. Co. N. L.

N<sup>o</sup> 12 LEVEL

SURVEYED	SCALE: 1" = 100'
DRAWN	R. L. 1954-00
DATE 31-12-80	

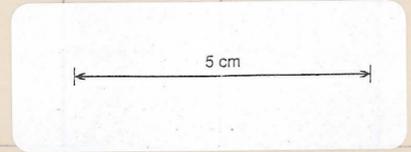

UPDATED AS AT 5-5-81

81019