


ABEF-692

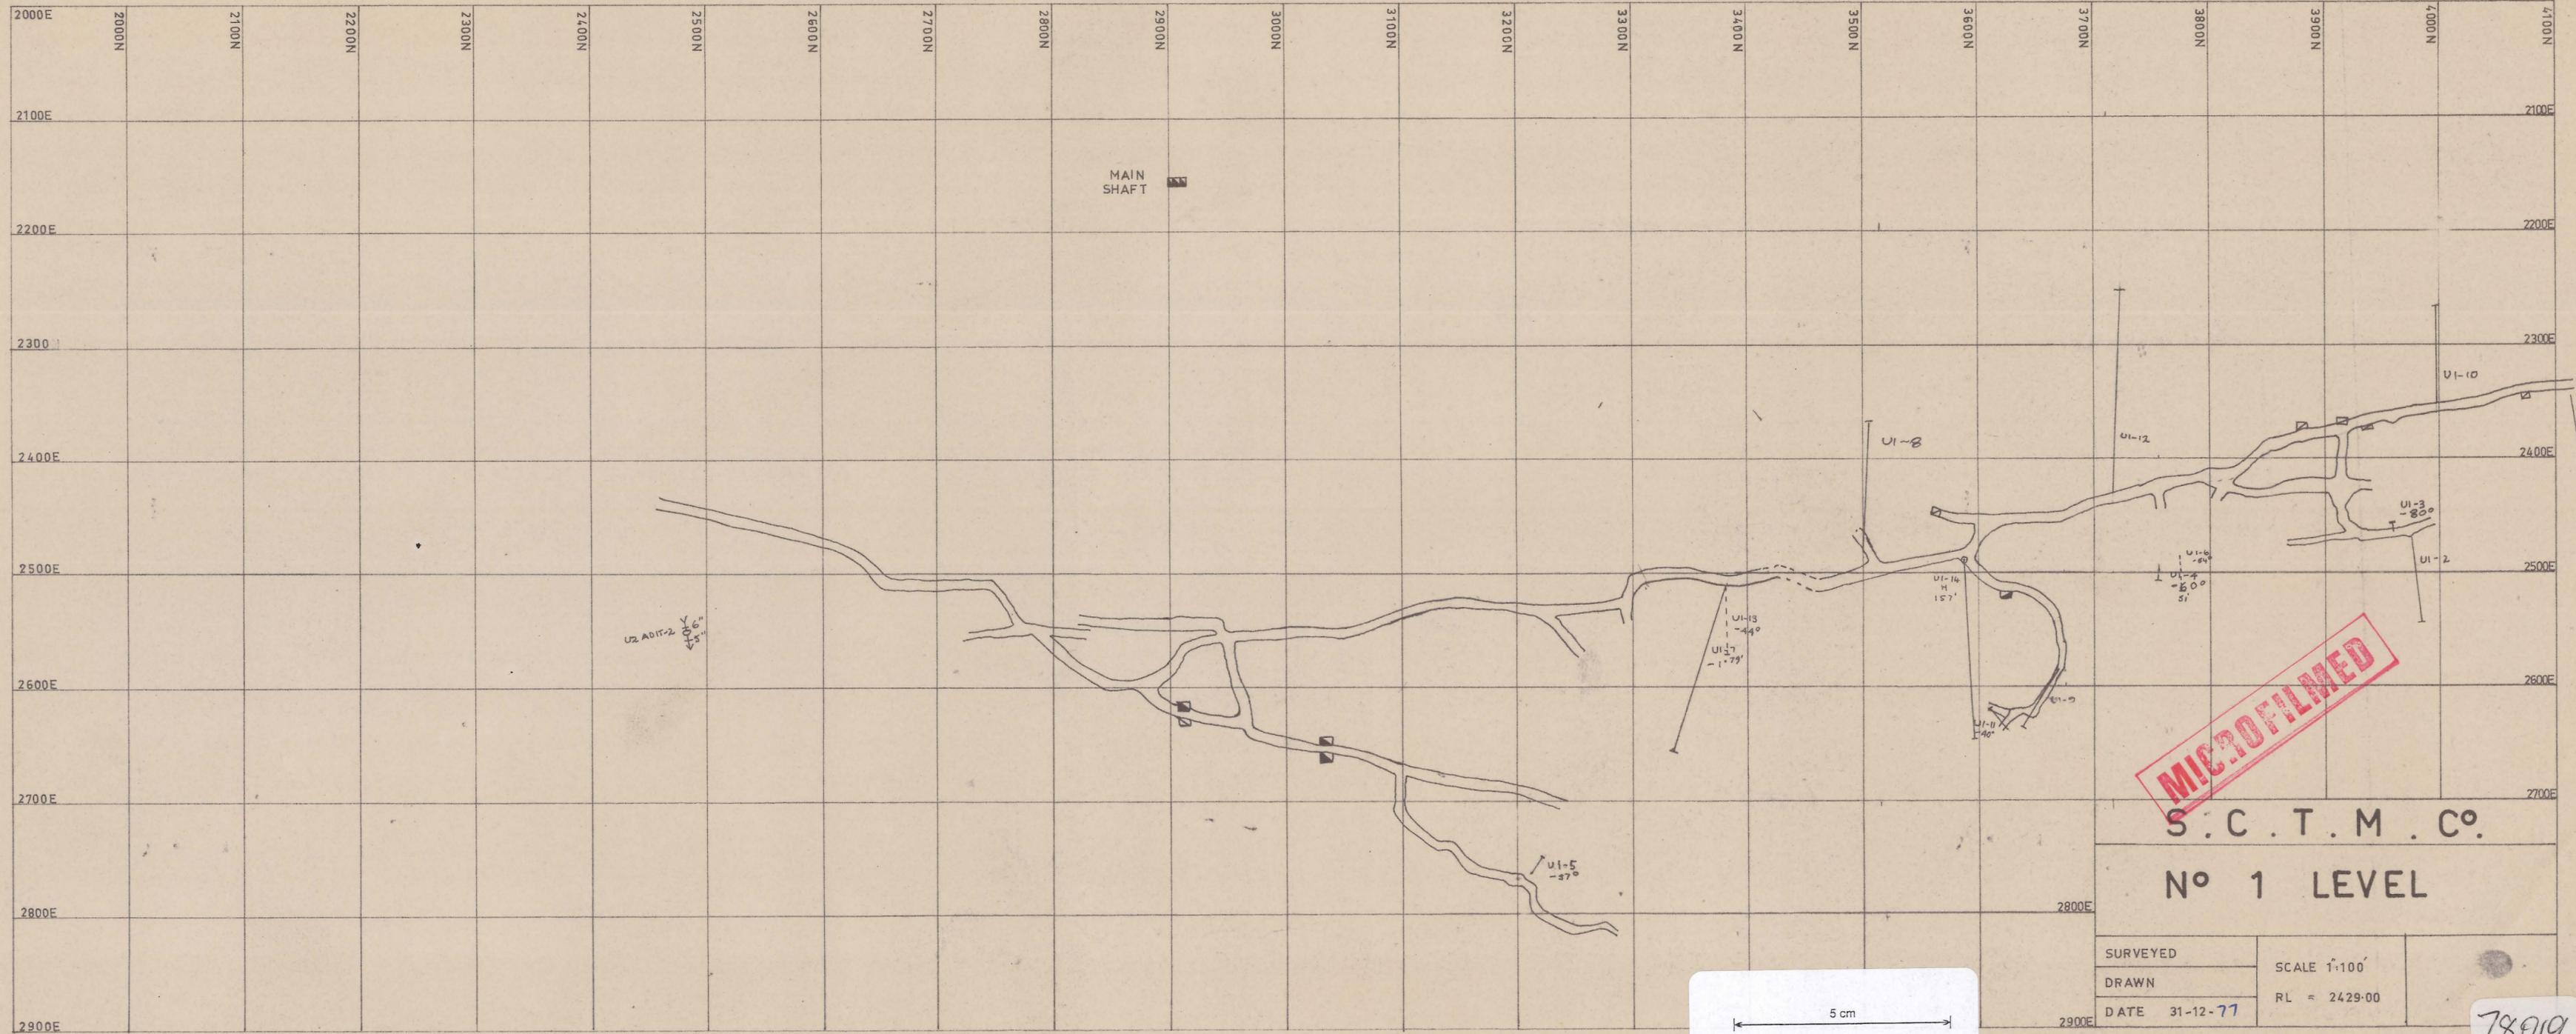

MICROFILMED

S. C. T. M. C. O.

N^o 1 LEVEL

SURVEYED	SCALE 1"=100' RL = 2429.00
DRAWN	
DATE 31-12-77	

5 cm

78019