


ABERF-696

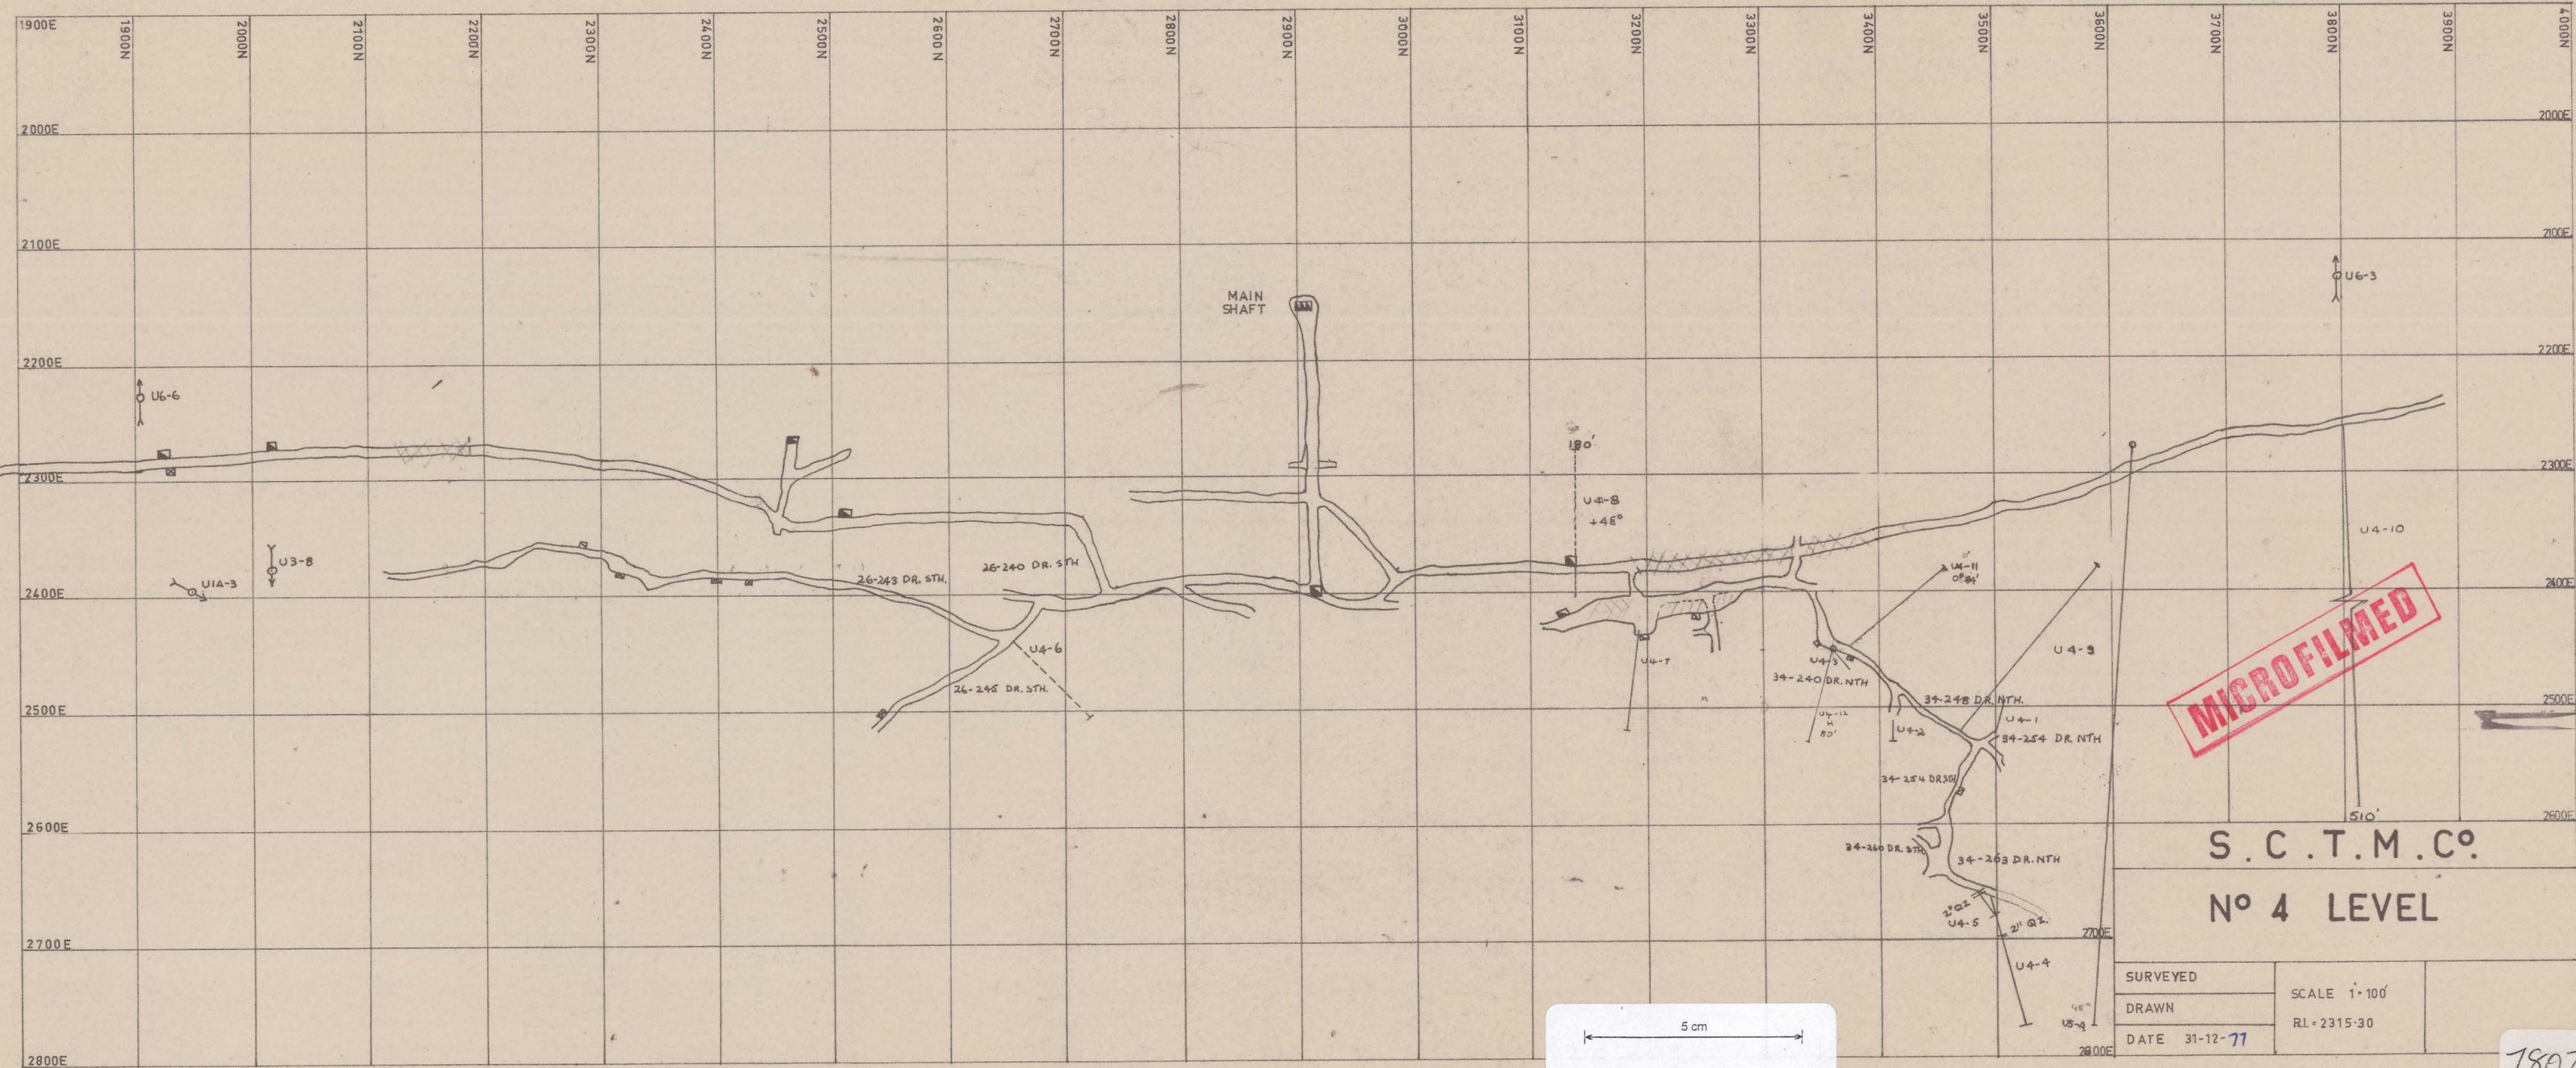

MICROFILMED

S.C.T.M.C.
N° 4 LEVEL

SURVEYED	SCALE 1:100'
DRAWN	RL = 2315.30
DATE 31-12-77	

5 cm

78023