



ABERF-697

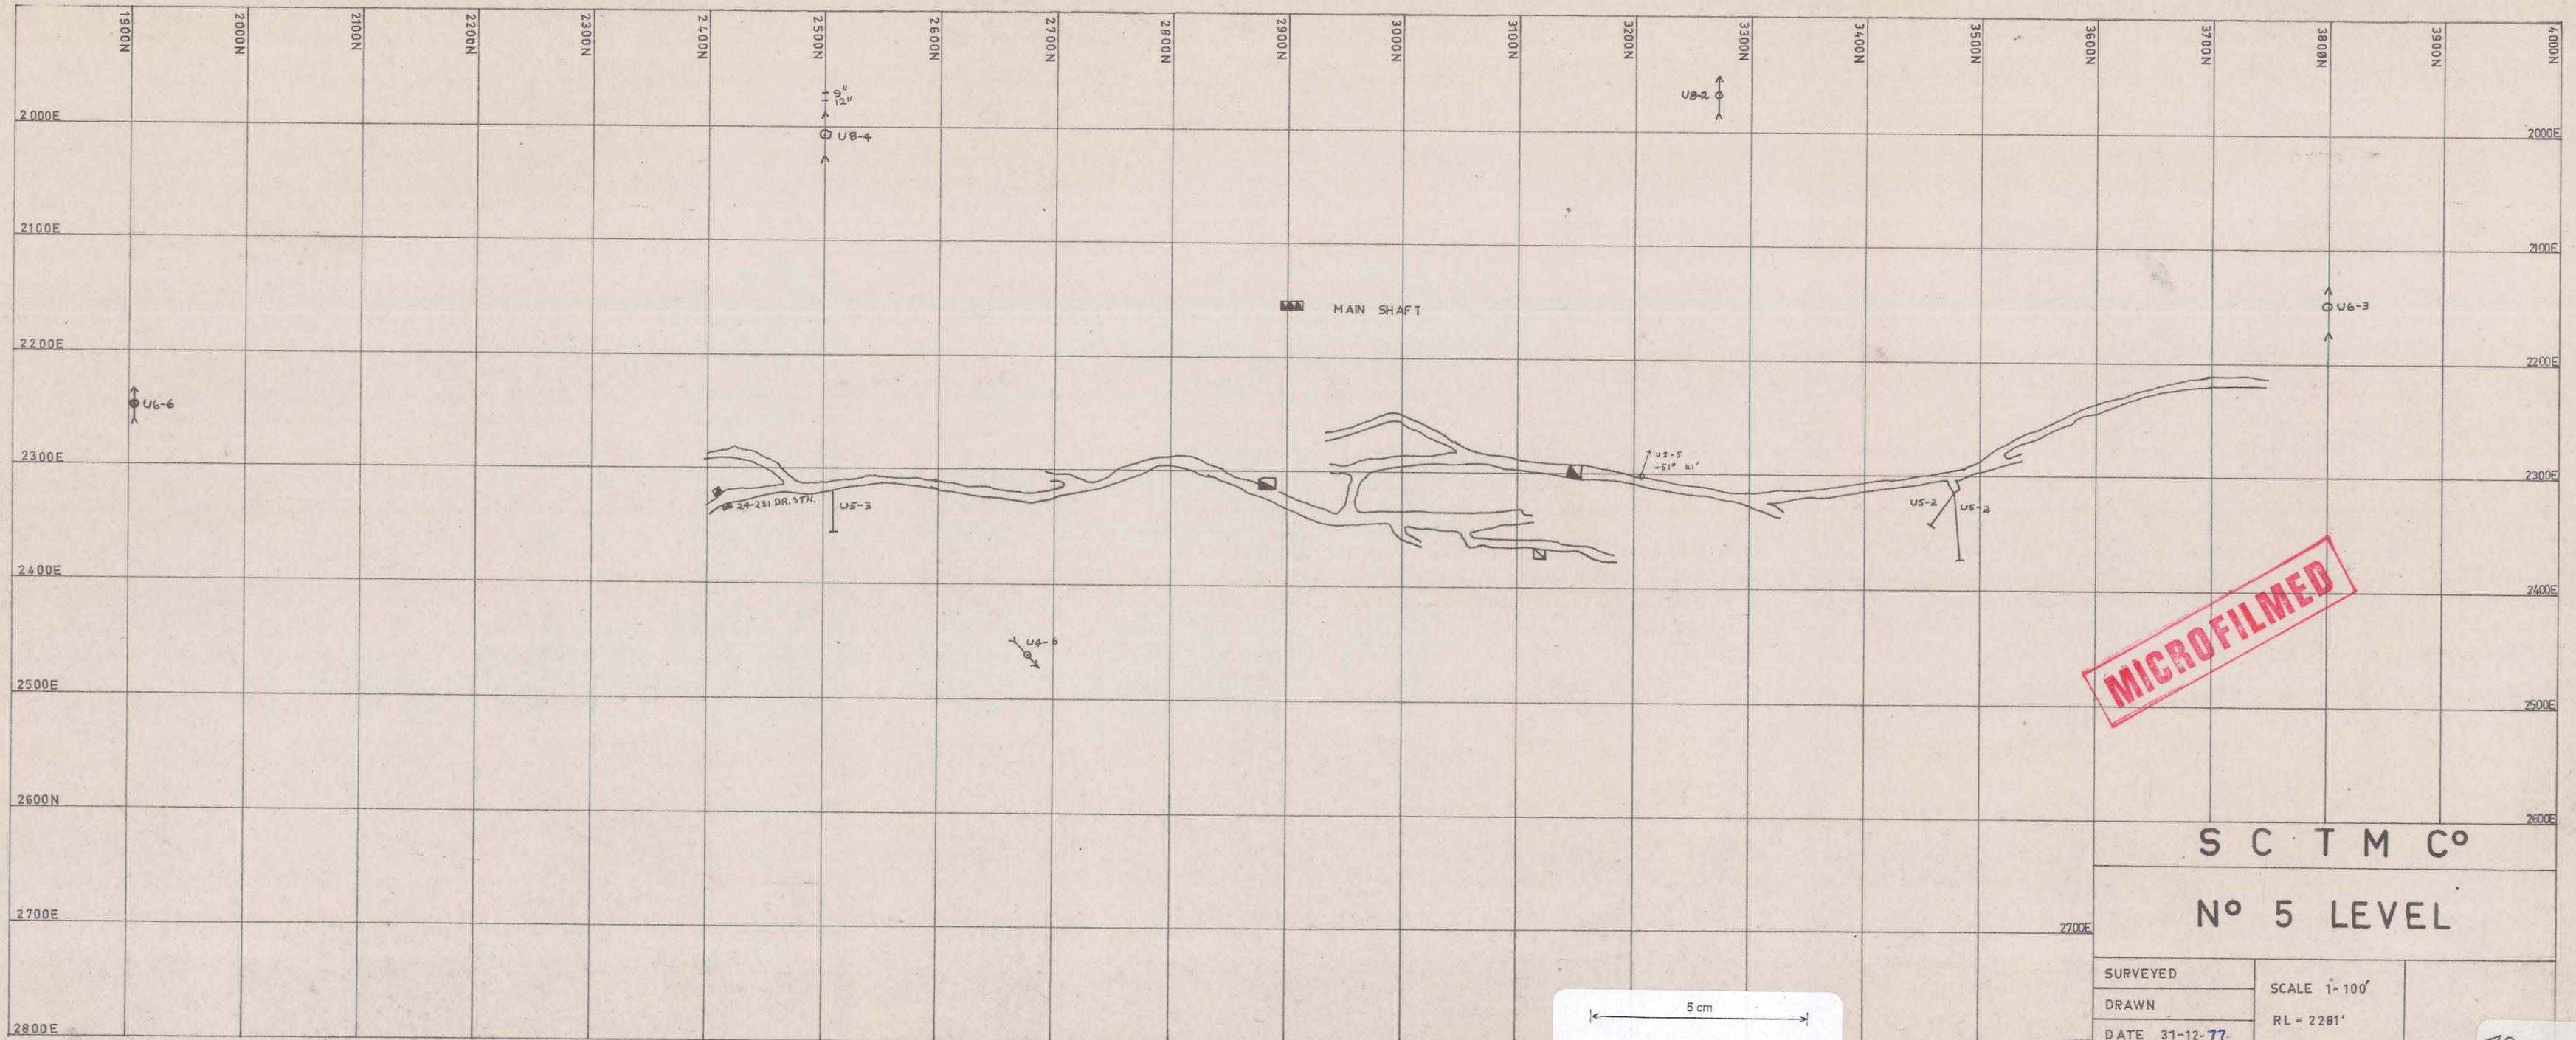

MICROFILMED

S C T M C°  
N° 5 LEVEL

SURVEYED	SCALE 1:100'
DRAWN	RL = 2281'
DATE 31-12-77	

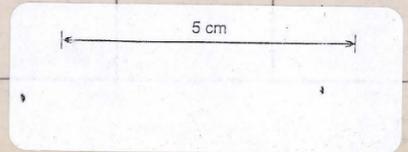

78024