



ABEF-698

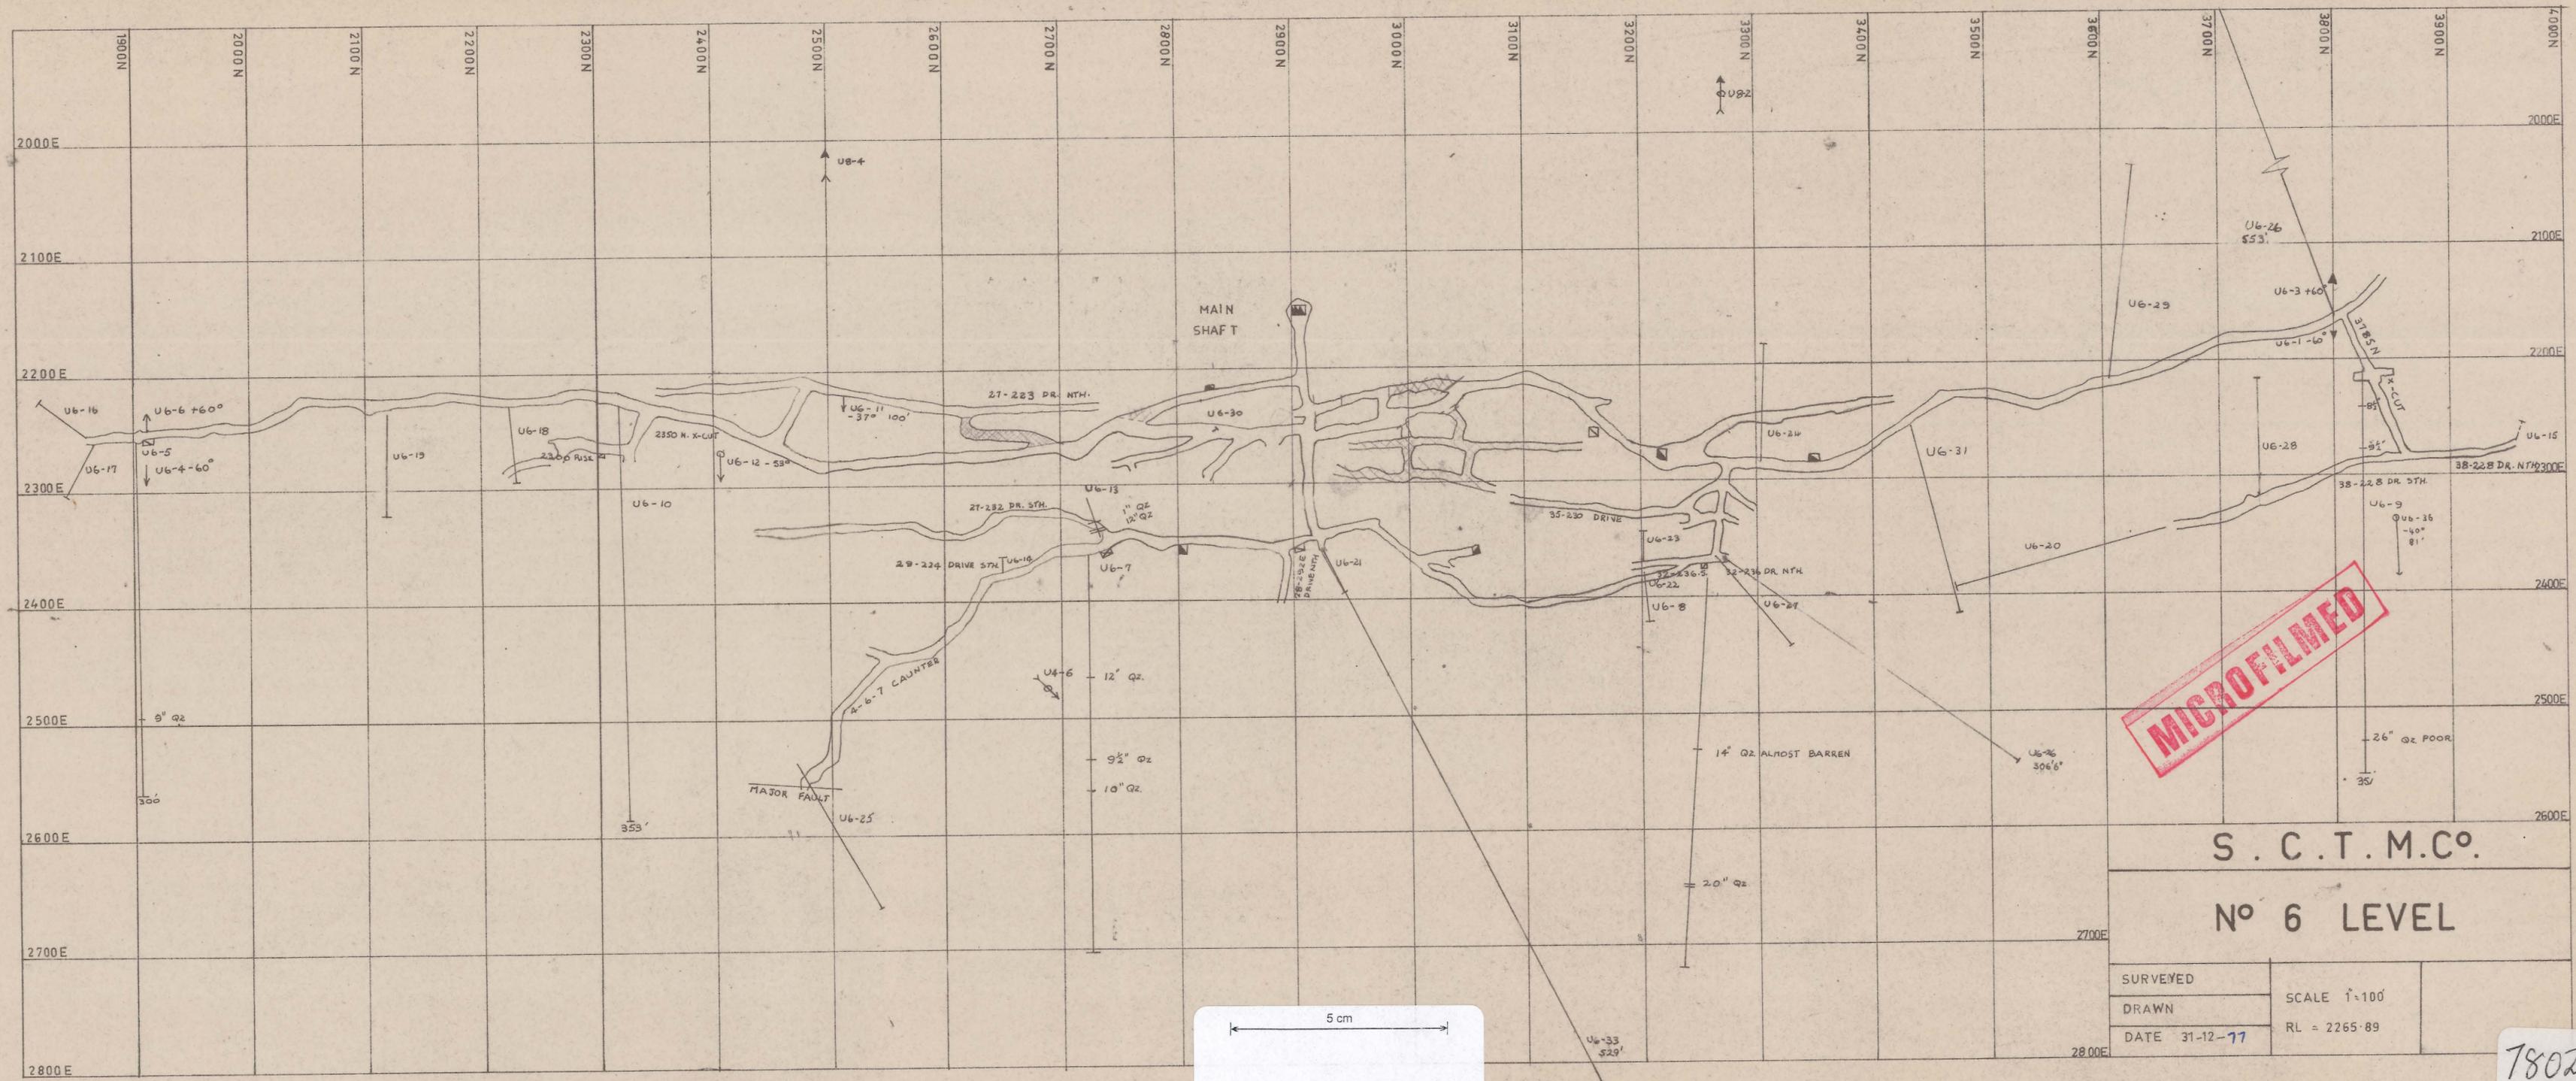

MICROFILMED

S. C. T. M. C.
No 6 LEVEL

SURVEYED	SCALE 1"=100' RL = 2265.89
DRAWN	
DATE 31-12-77	

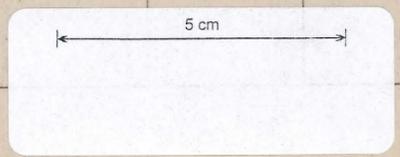

78025