



ABEF-700

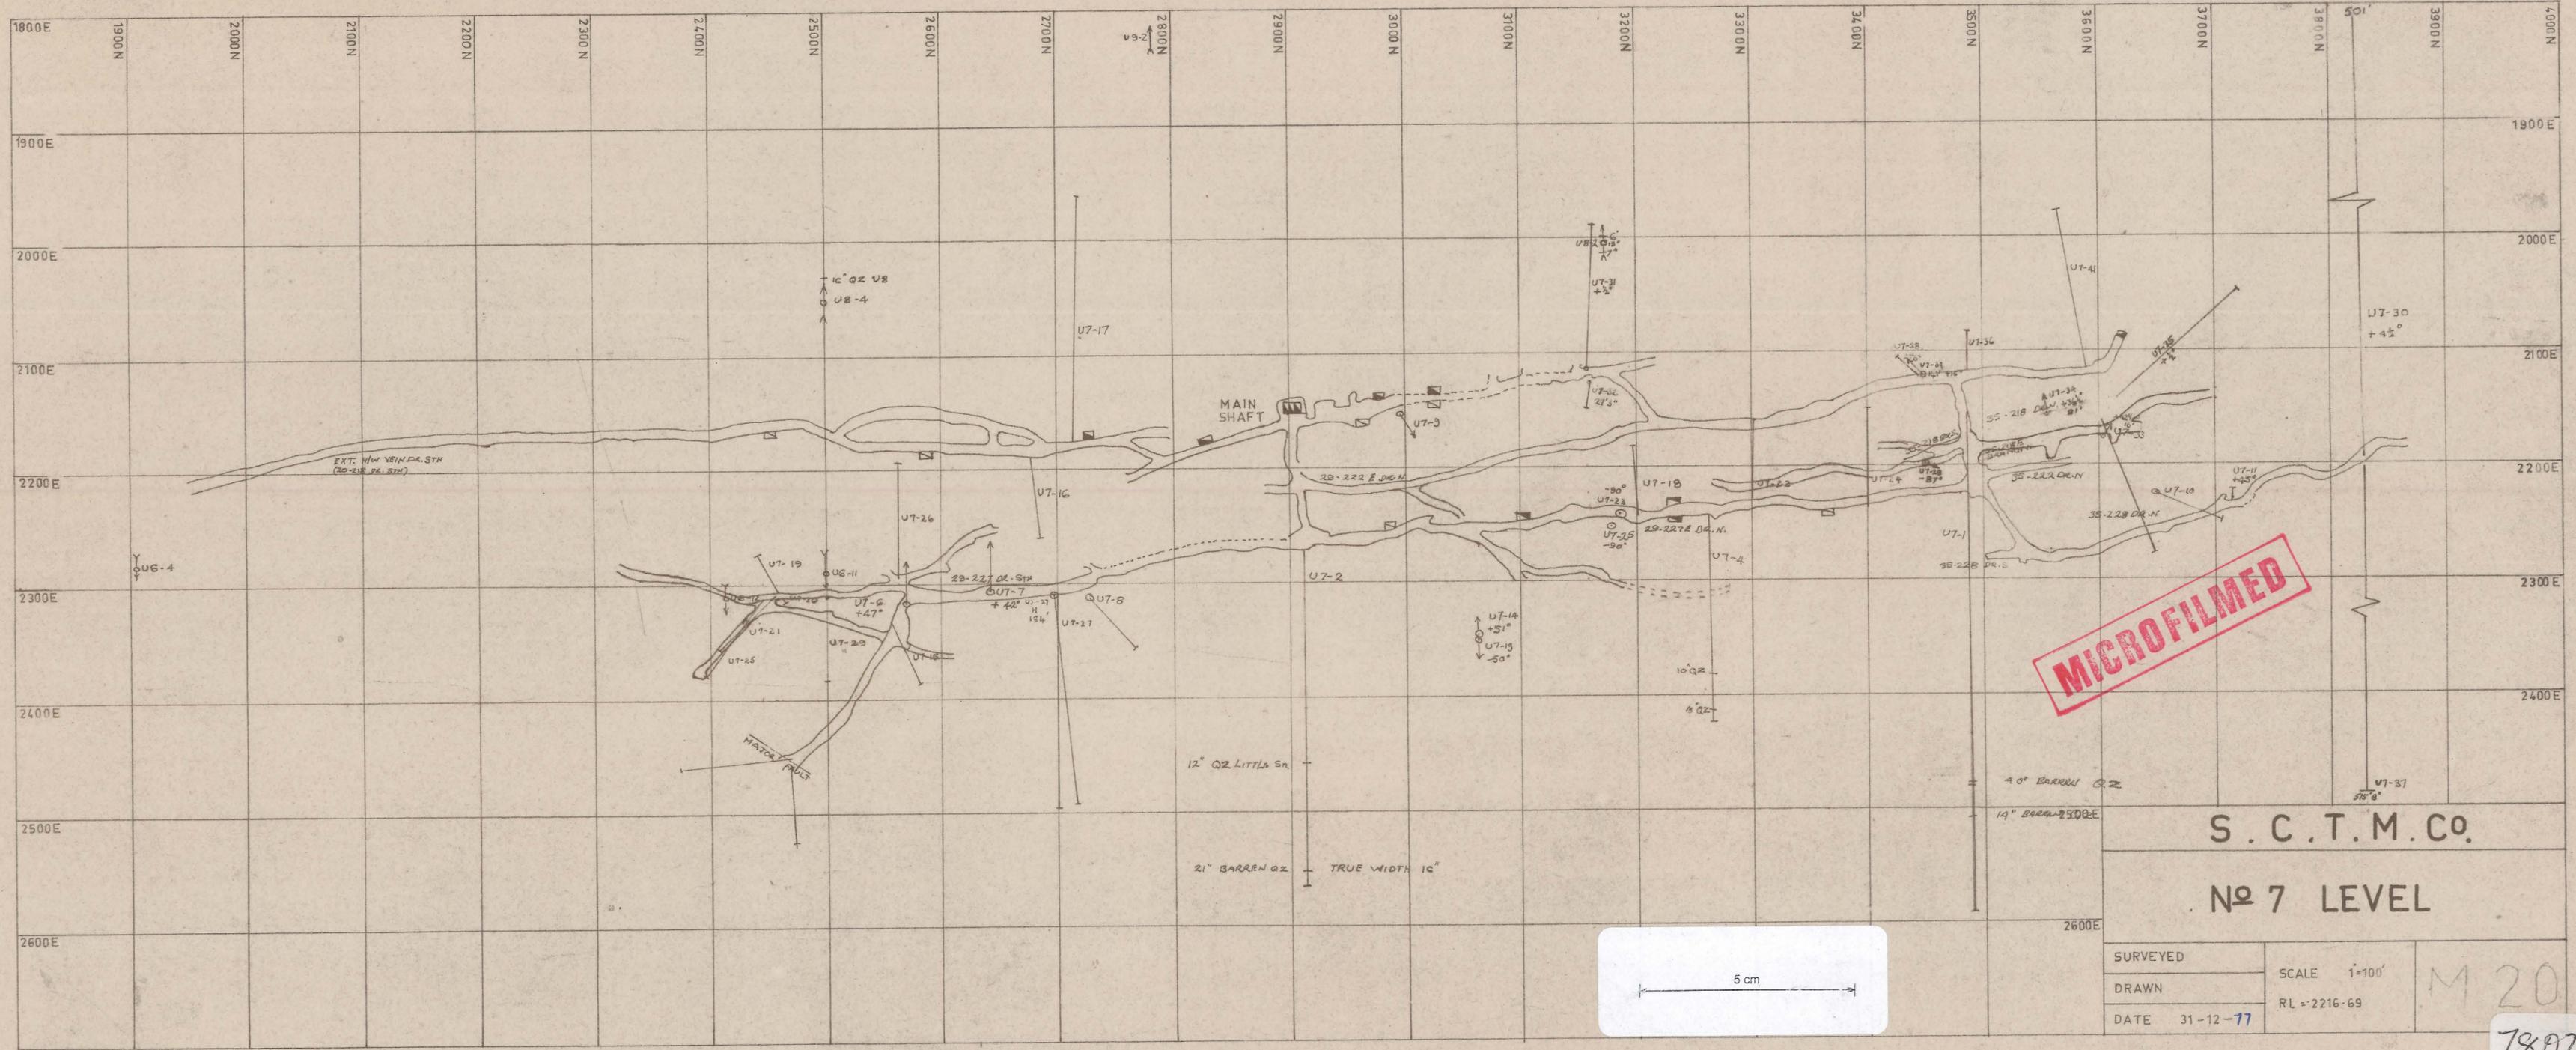

**MICROFILMED**

S. C. T. M. CO.  
No 7 LEVEL

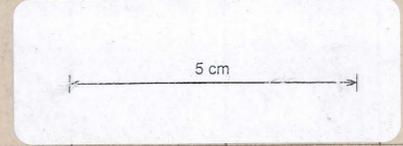

SURVEYED	SCALE 1"=100' RL = 2216.69
DRAWN	
DATE 31-12-77	

M 20  
78027