


ABERF-201

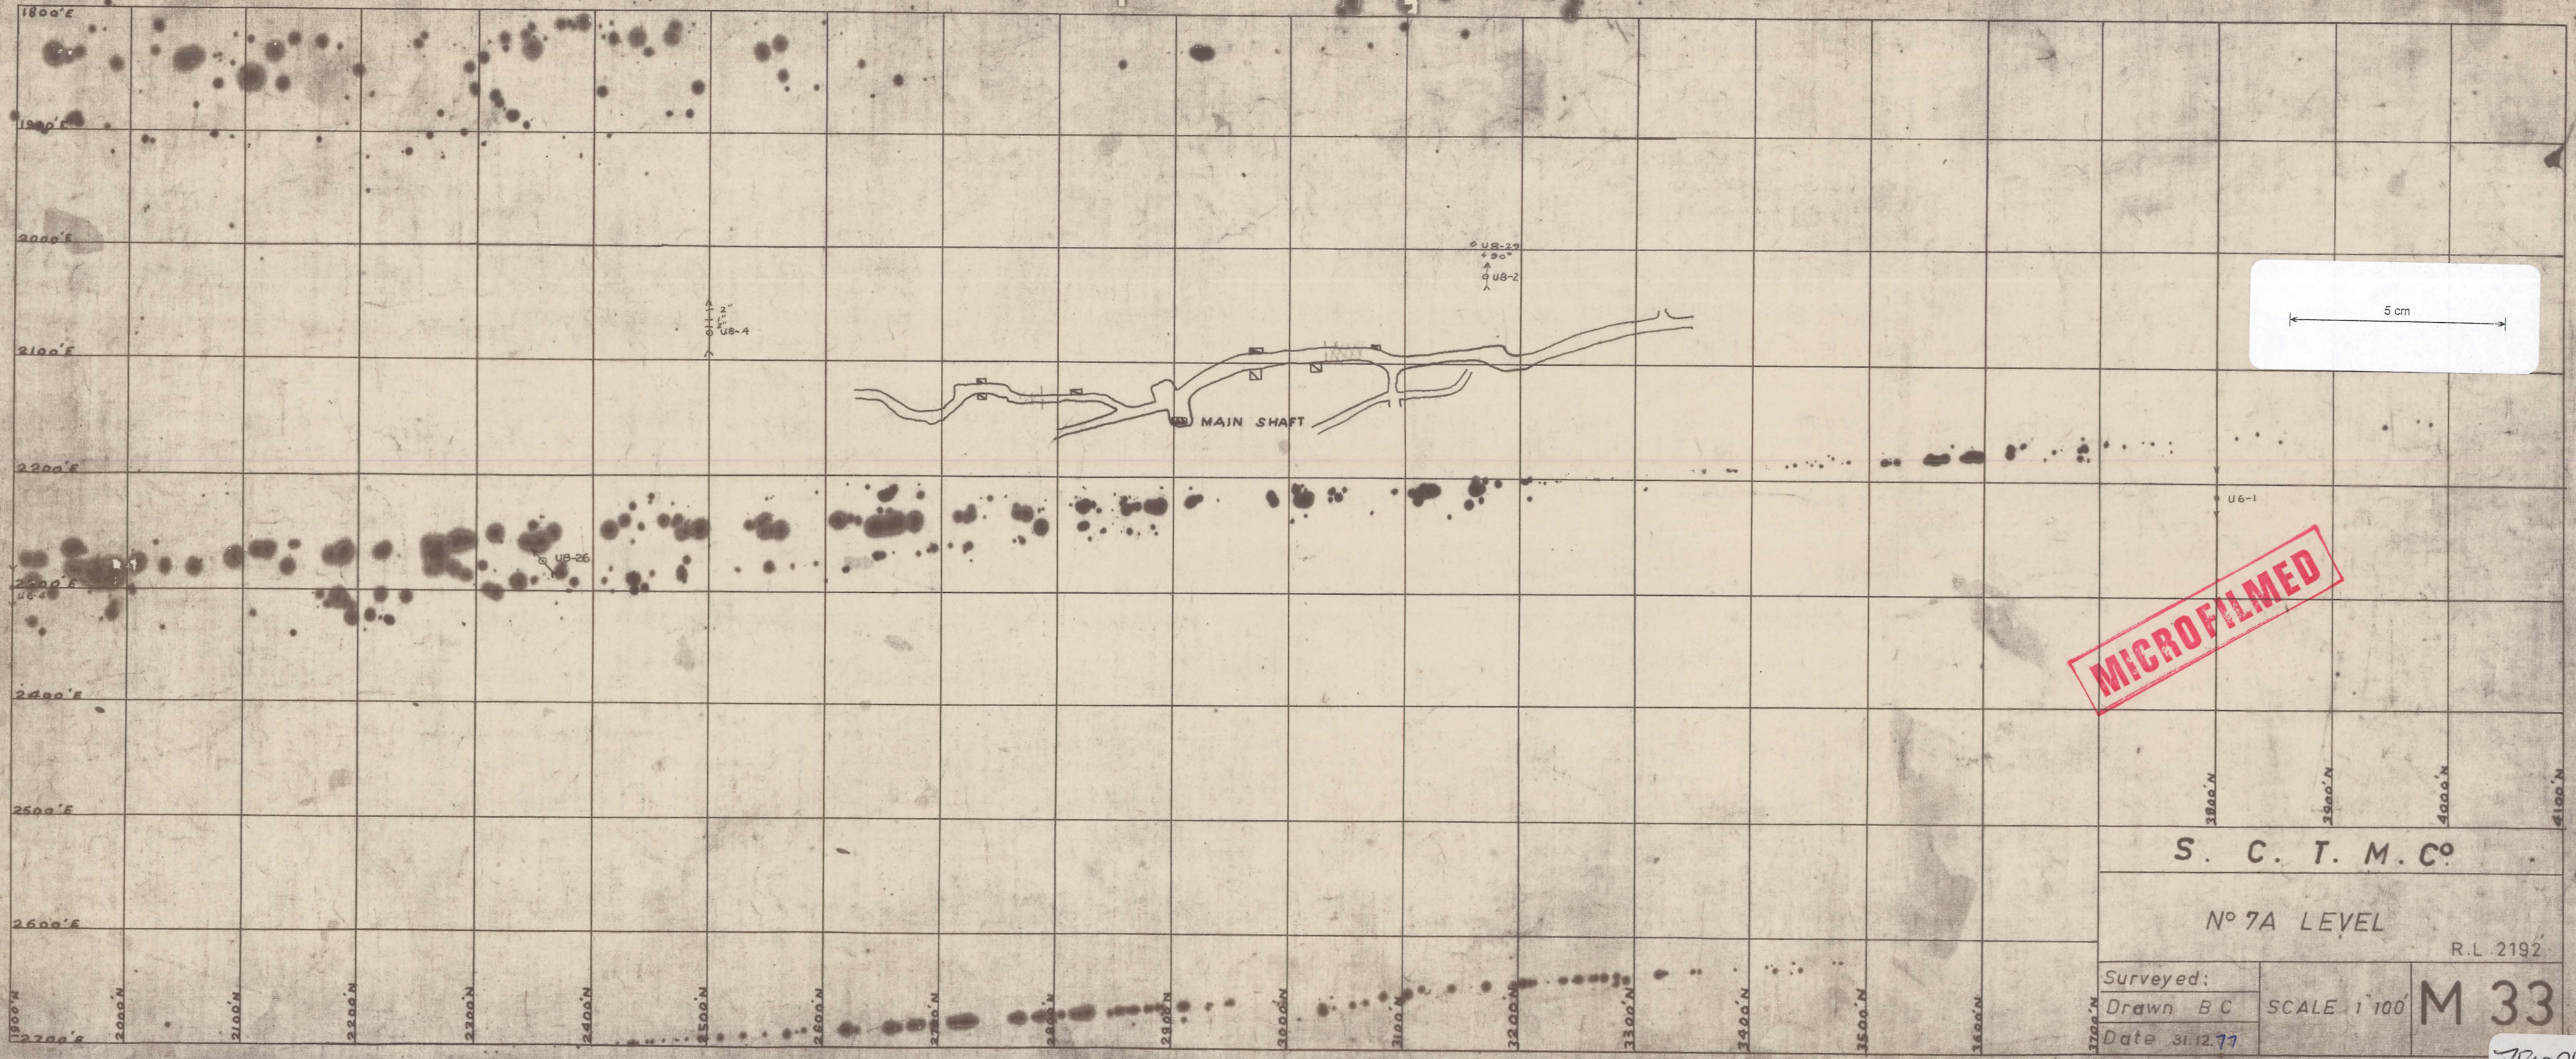

MICROFILMED

S. C. T. M. CO.

No 7A LEVEL

R.L. 2192

Surveyed:
Drawn B.C.
Date 31.12.77

SCALE 1"=100'

M 33

78028