



ABEAF-703

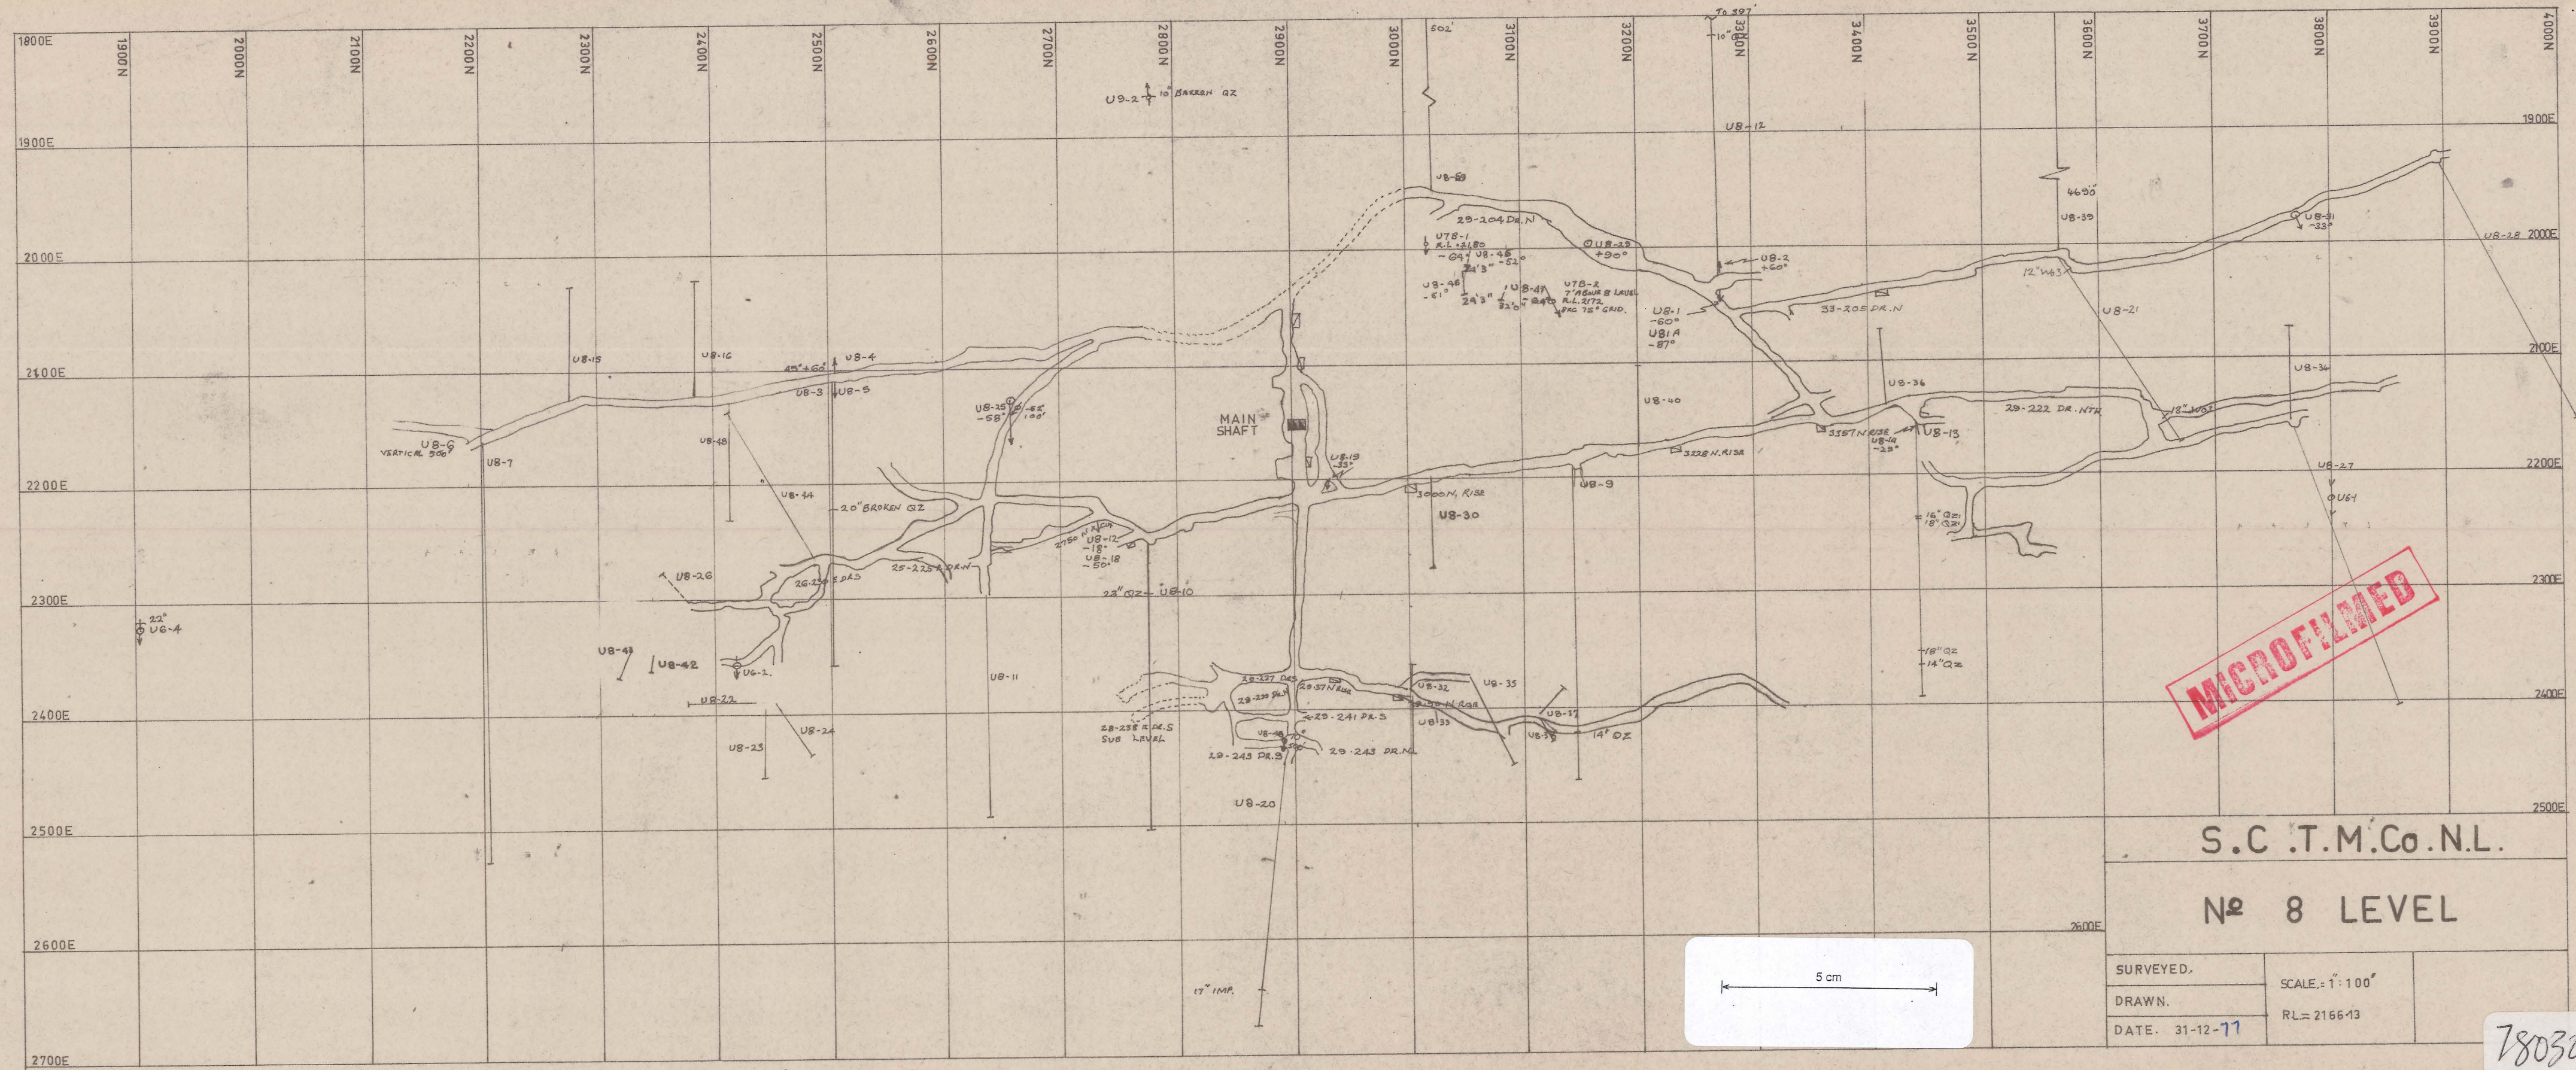

MICROFILMED

S.C.T.M.Co.N.L.
No 8 LEVEL

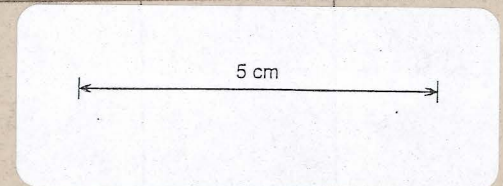

SURVEYED,	SCALE: 1" = 100' RL = 2166.13
DRAWN,	
DATE: 31-12-77	

78030