


ABERF-705

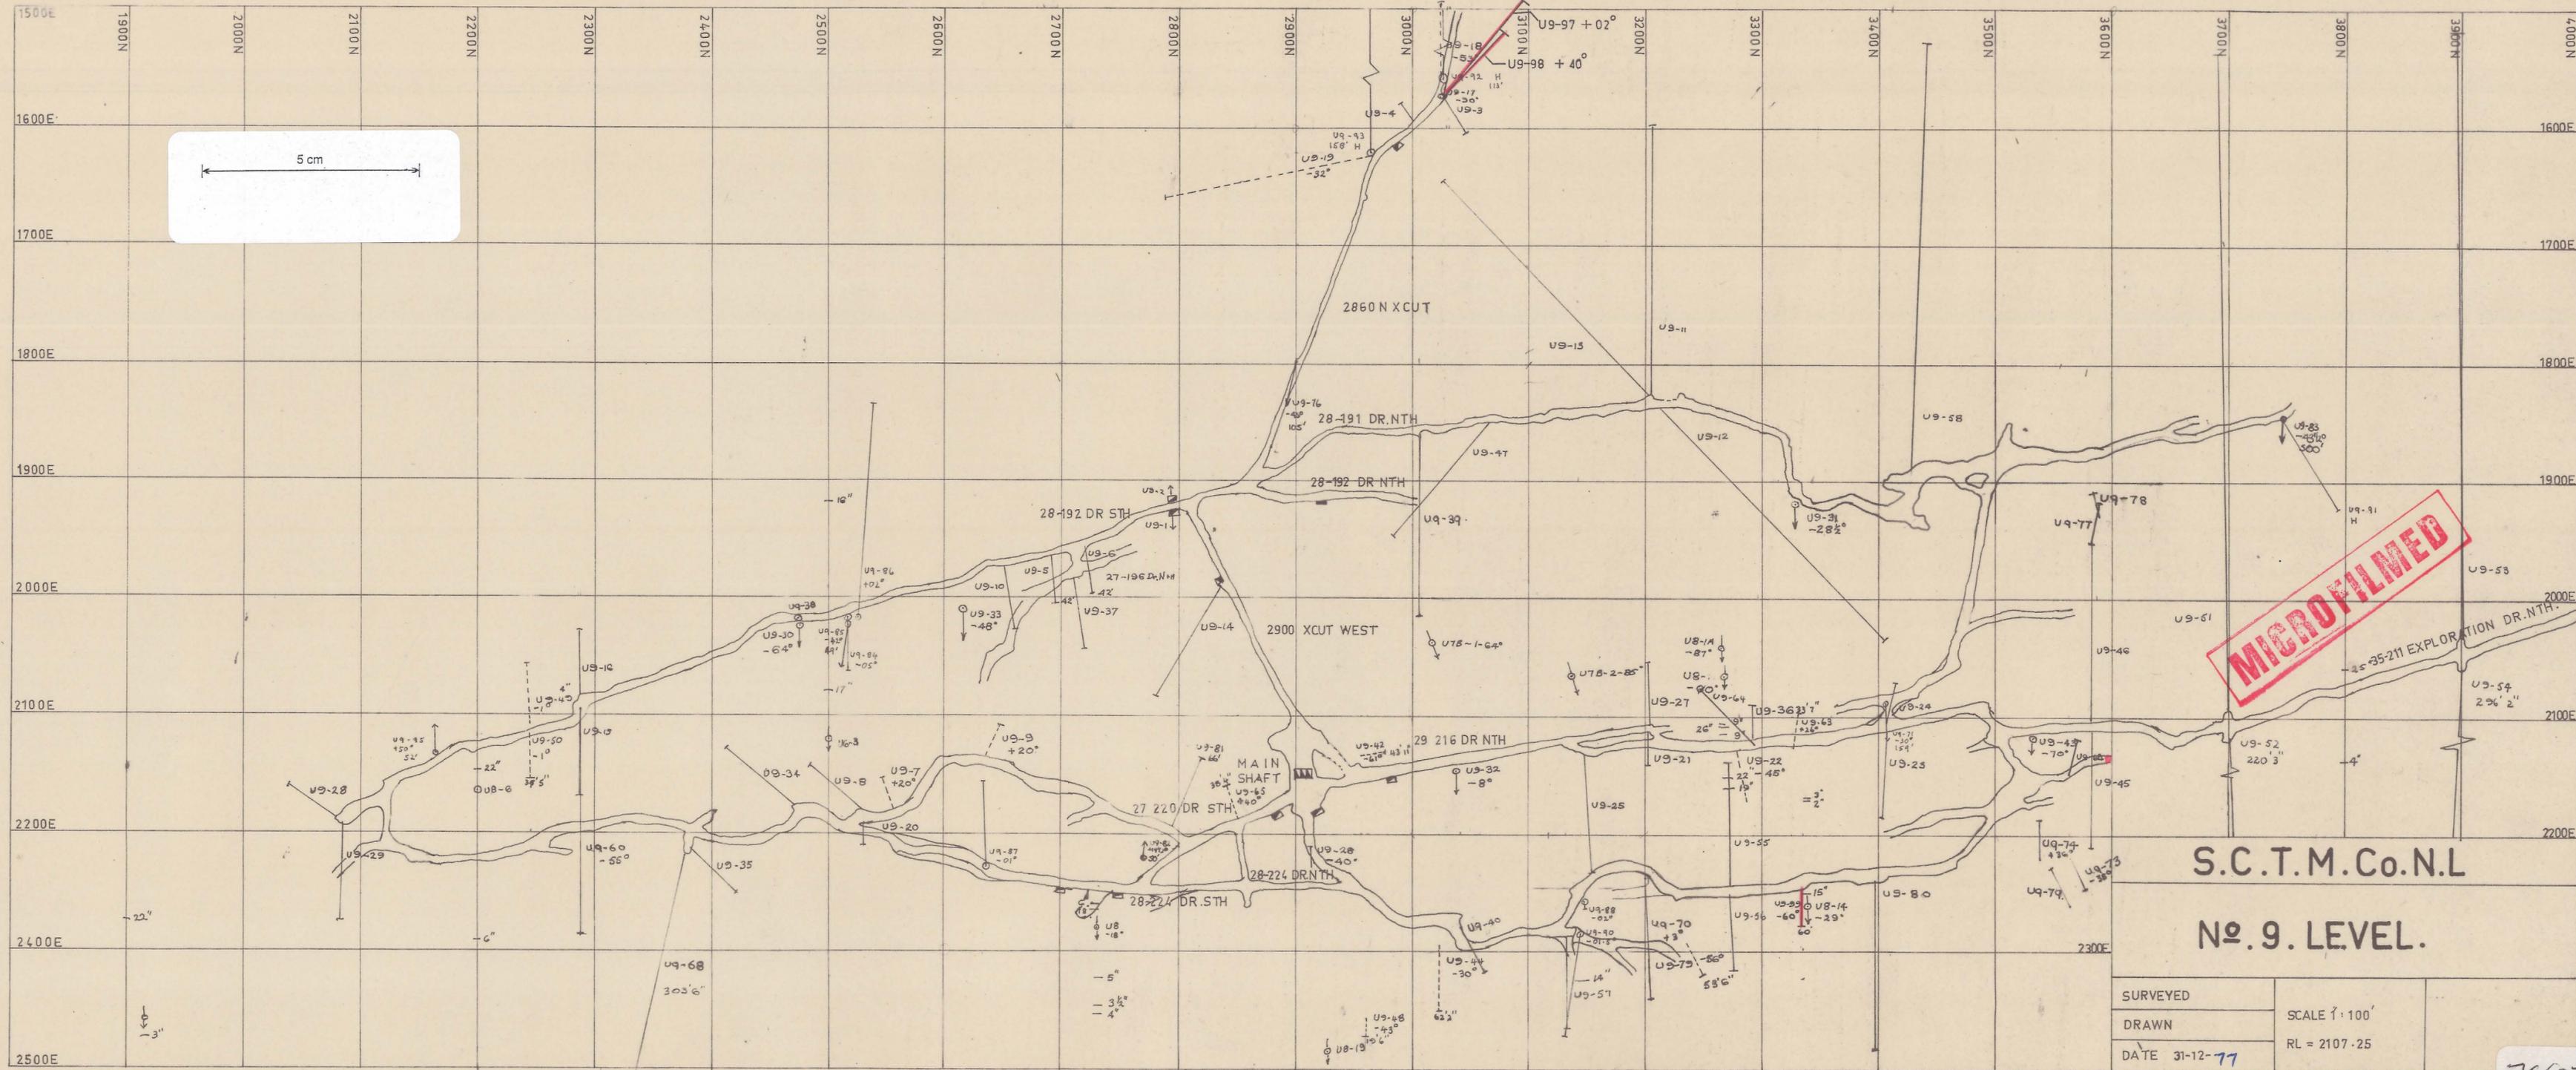

MICROFILMED

S.C.T.M.Co.N.L
No. 9. LEVEL.

SURVEYED	SCALE 1:100' RL = 2107.25
DRAWN	
DATE 31-12-77	

78032