



ABERF-706

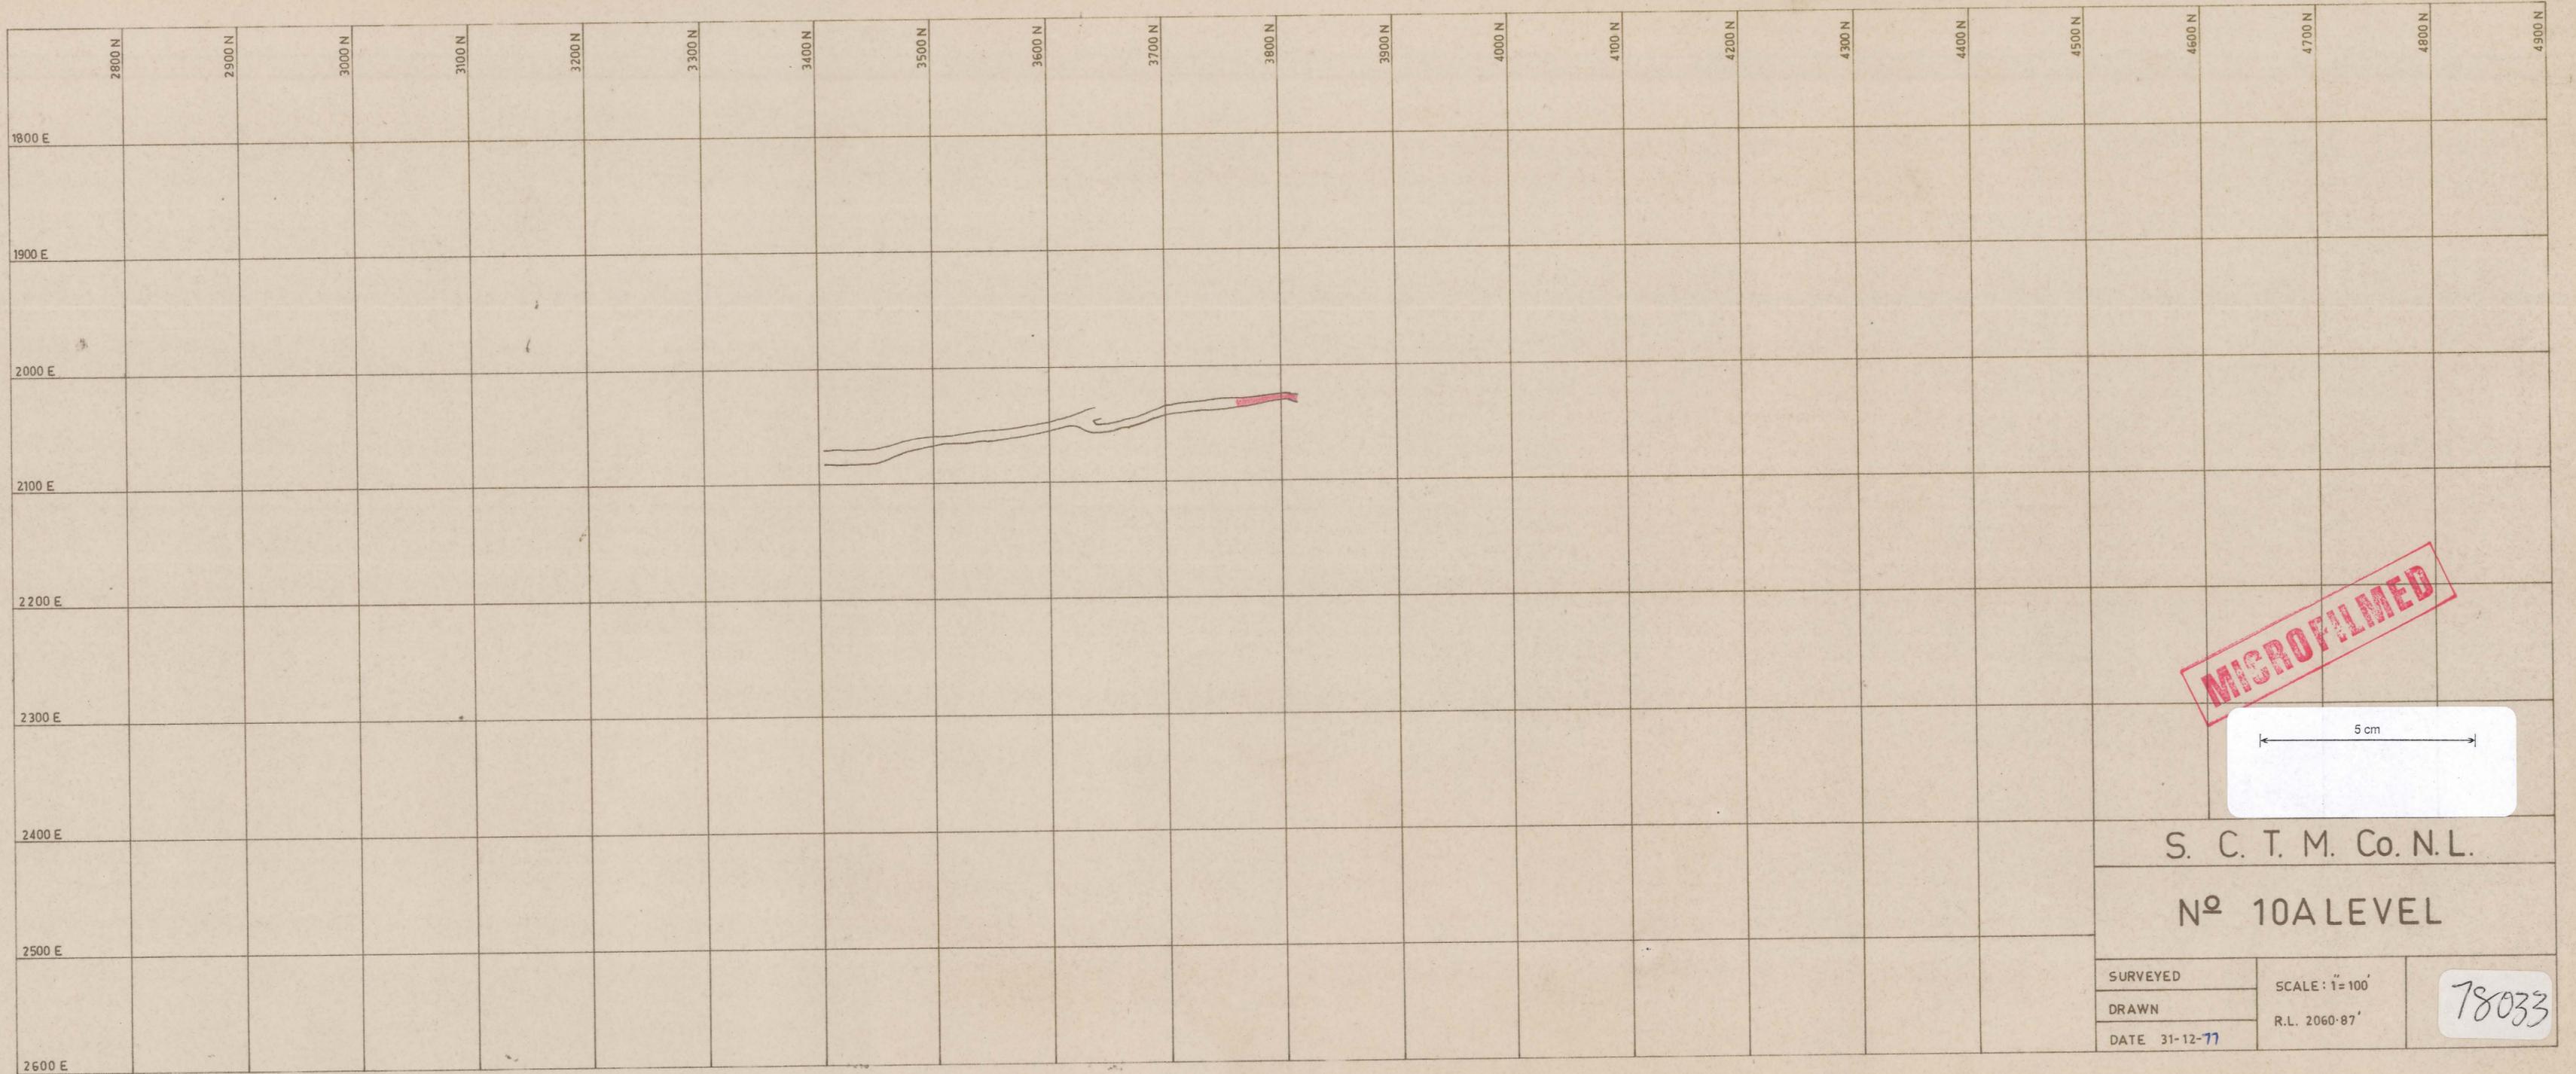

MICROFILMED

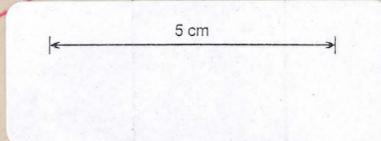

S. C. T. M. Co. N.L.

Nº 10A LEVEL

SURVEYED	SCALE: 1"=100'
DRAWN	R.L. 2060-87'
DATE 31-12-77	

78033