



ABERF-708

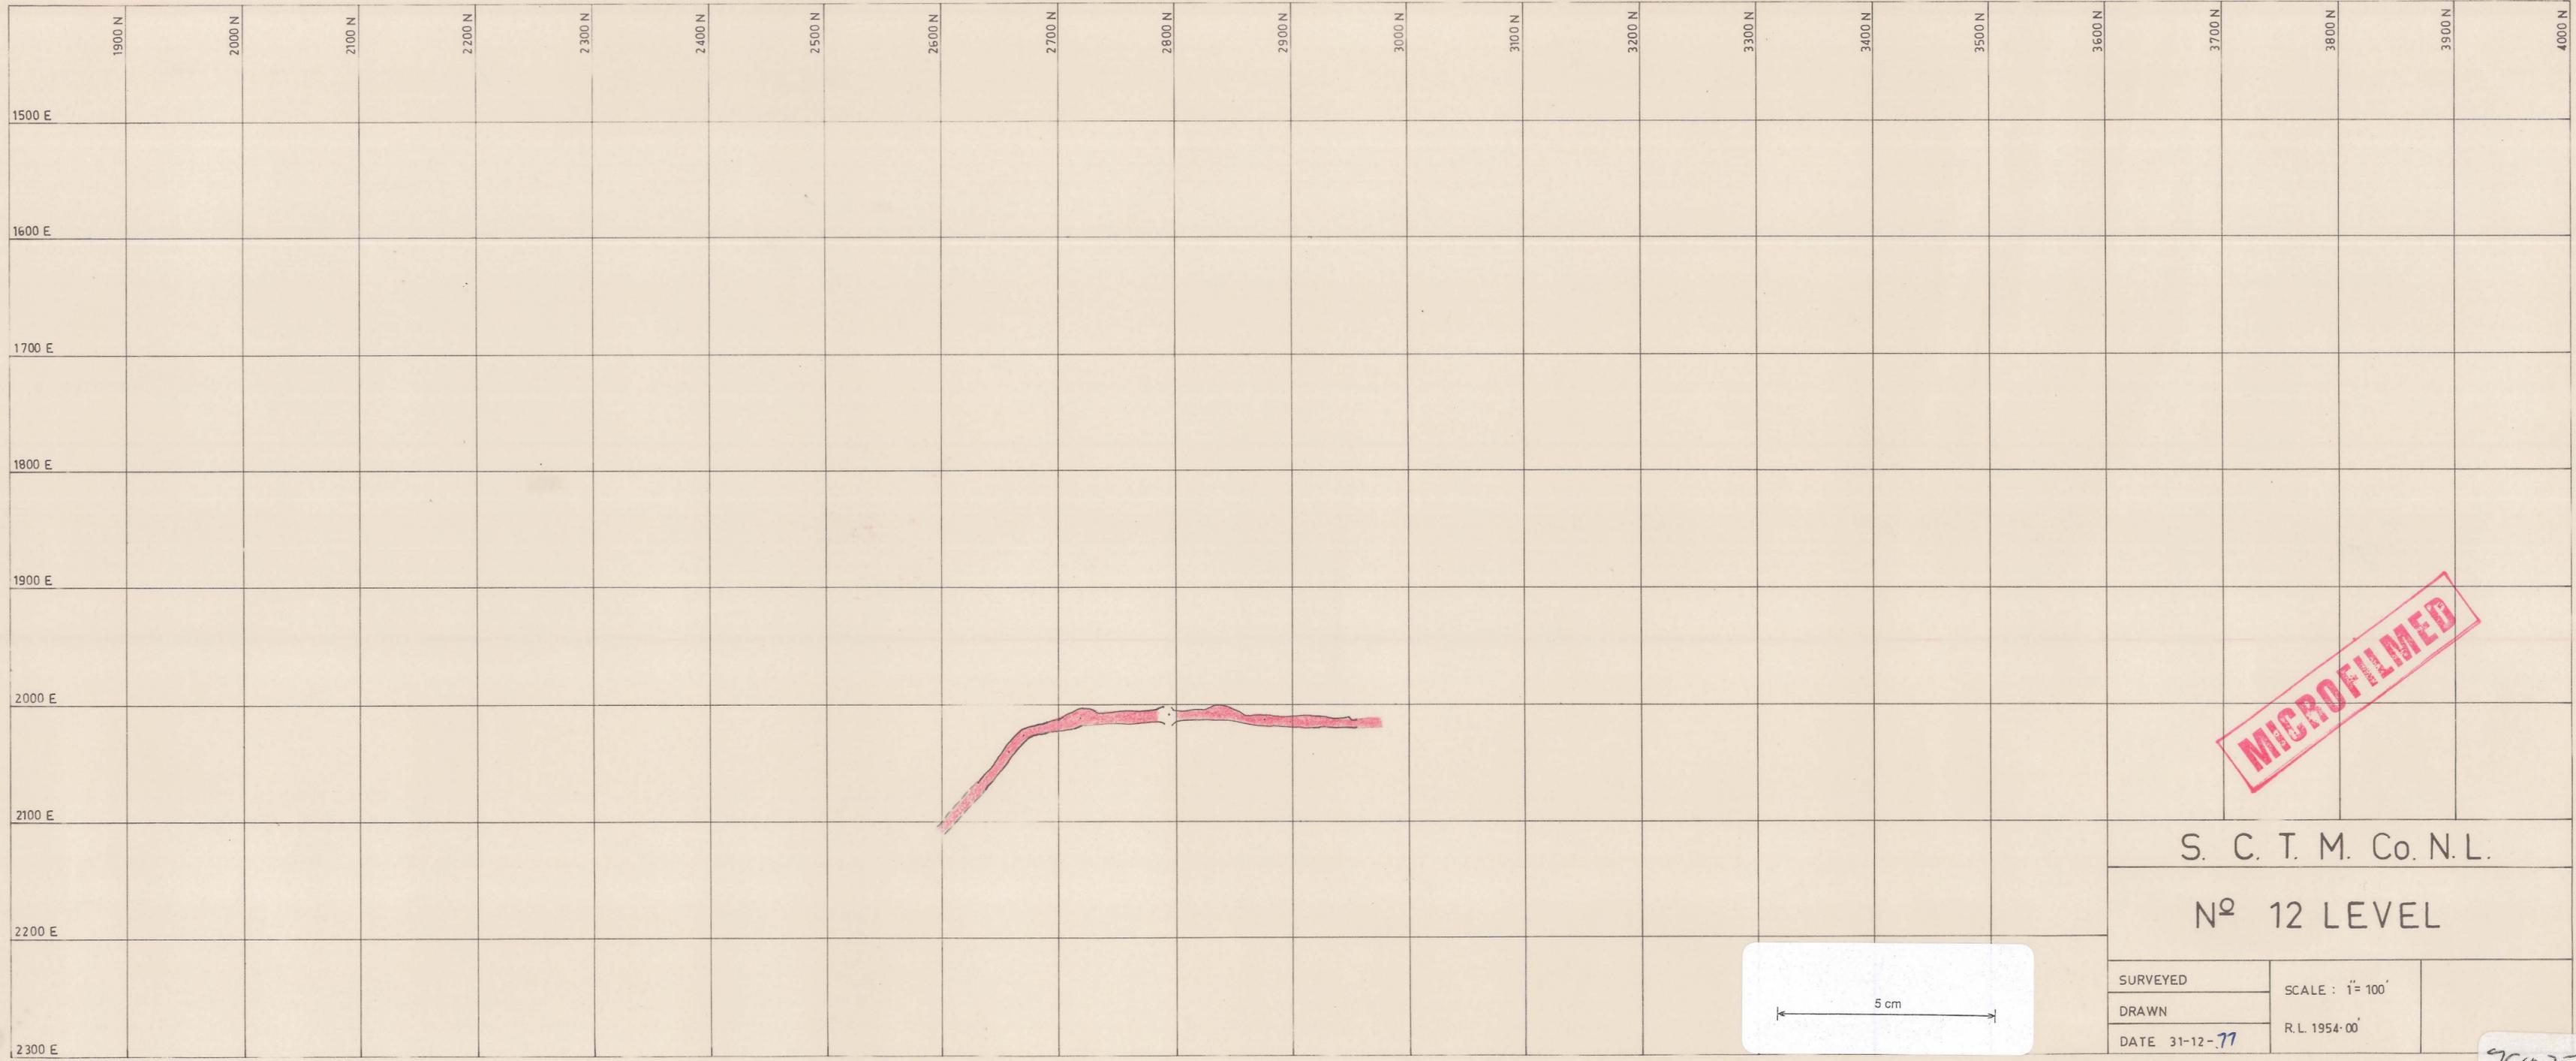

MICROFILMED

S. C. T. M. Co. N. L.

Nº 12 LEVEL

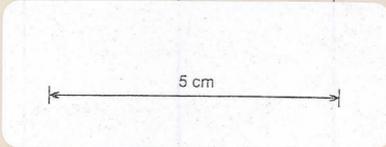

SURVEYED	SCALE : 1" = 100'
DRAWN	R. L. 1954-00
DATE 31-12-77	

78035