


ABERF - 711

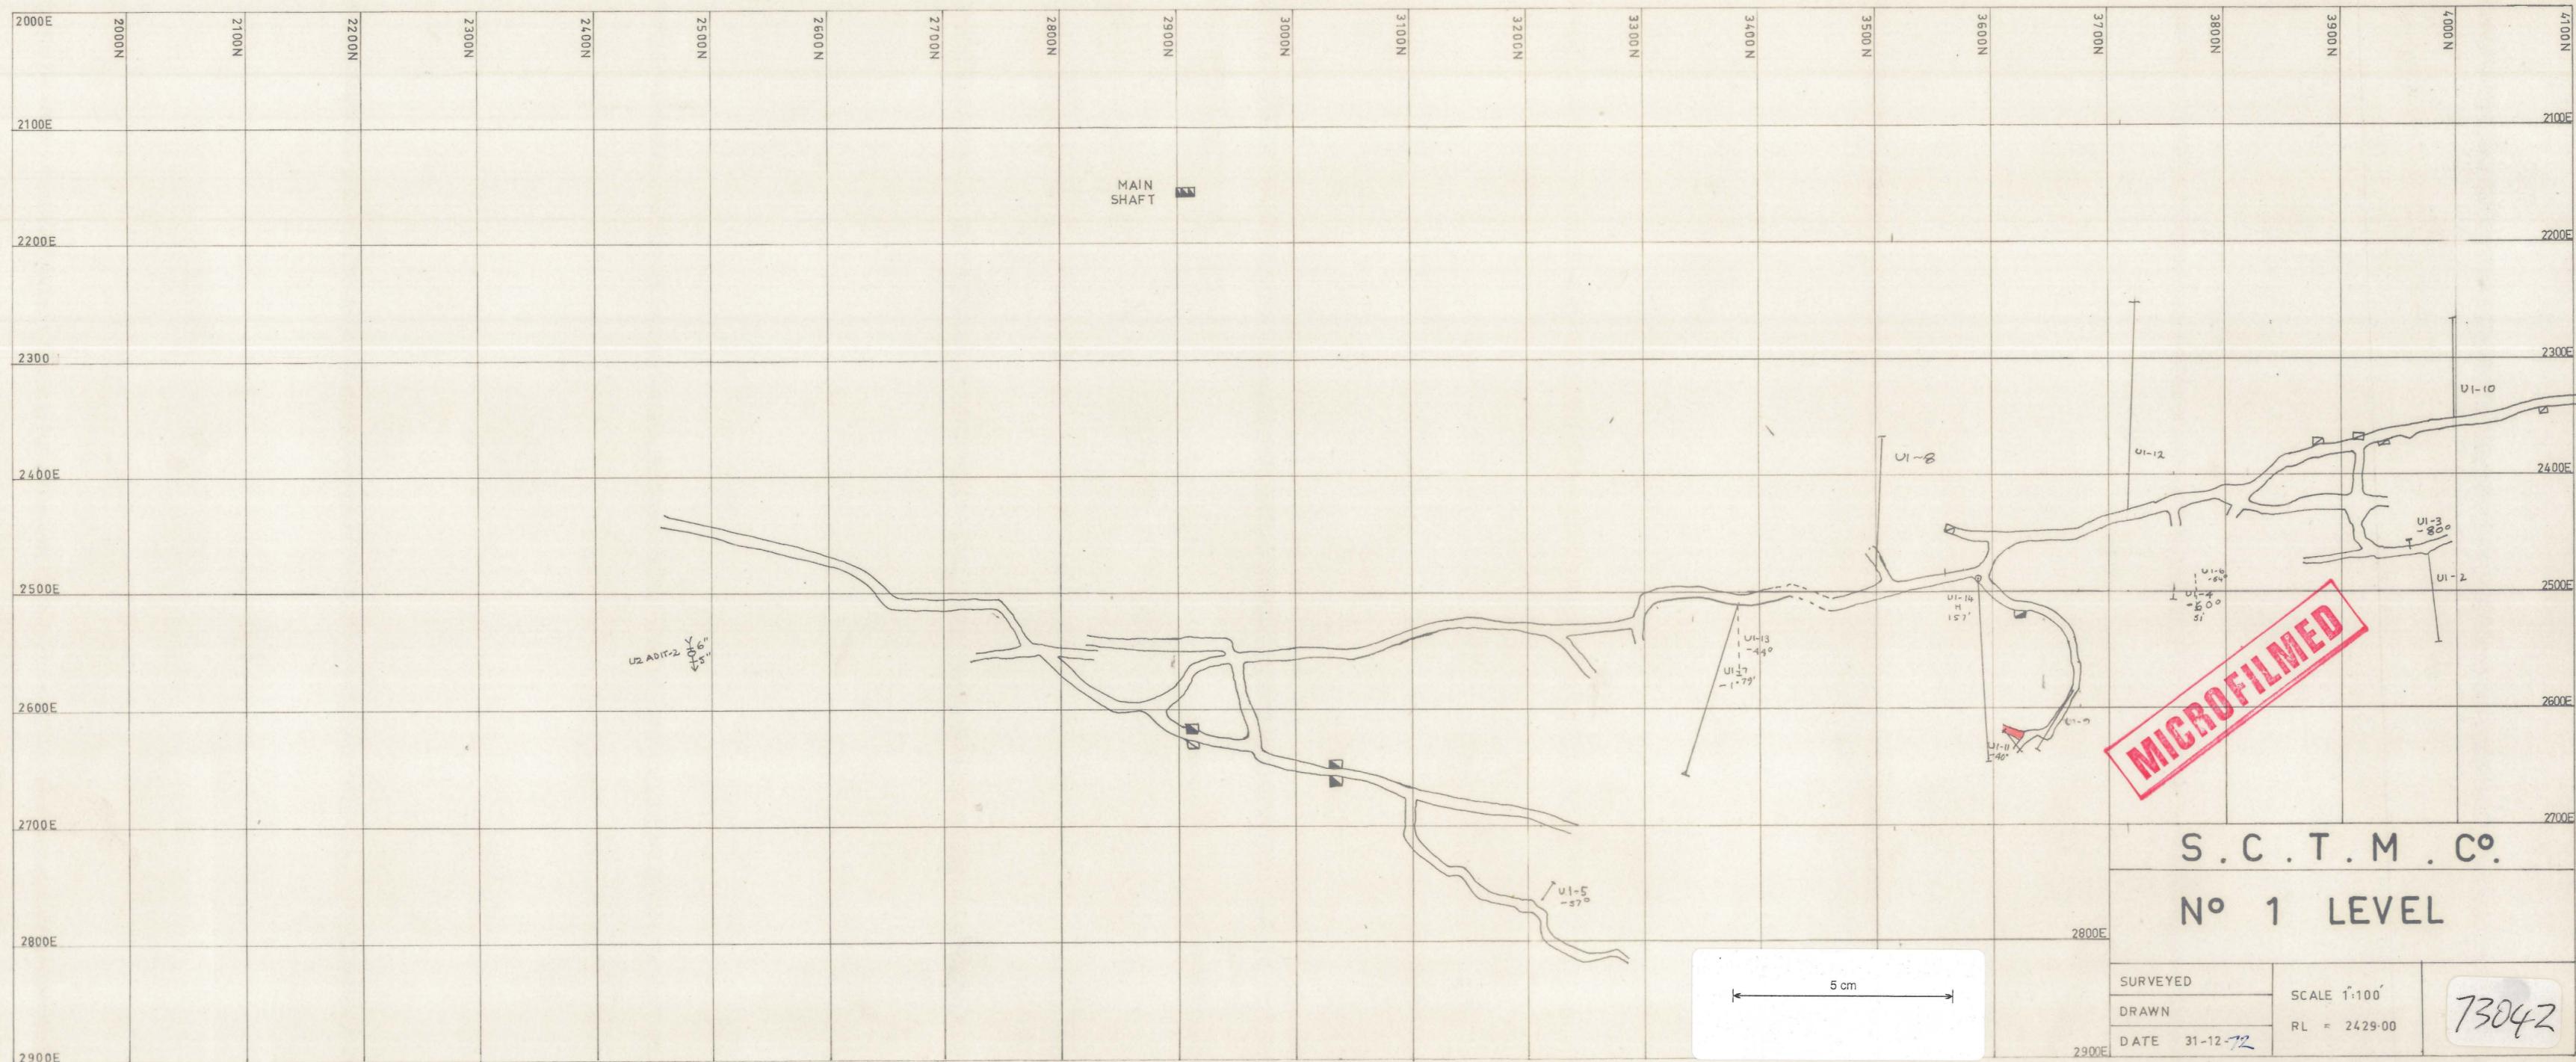

**MICROFILMED**

S . C . T . M . C . O .  
N° 1 LEVEL

SURVEYED	SCALE 1"=100'
DRAWN	RL = 2429-00
DATE 31-12-72	

73042