


ABERF - 715

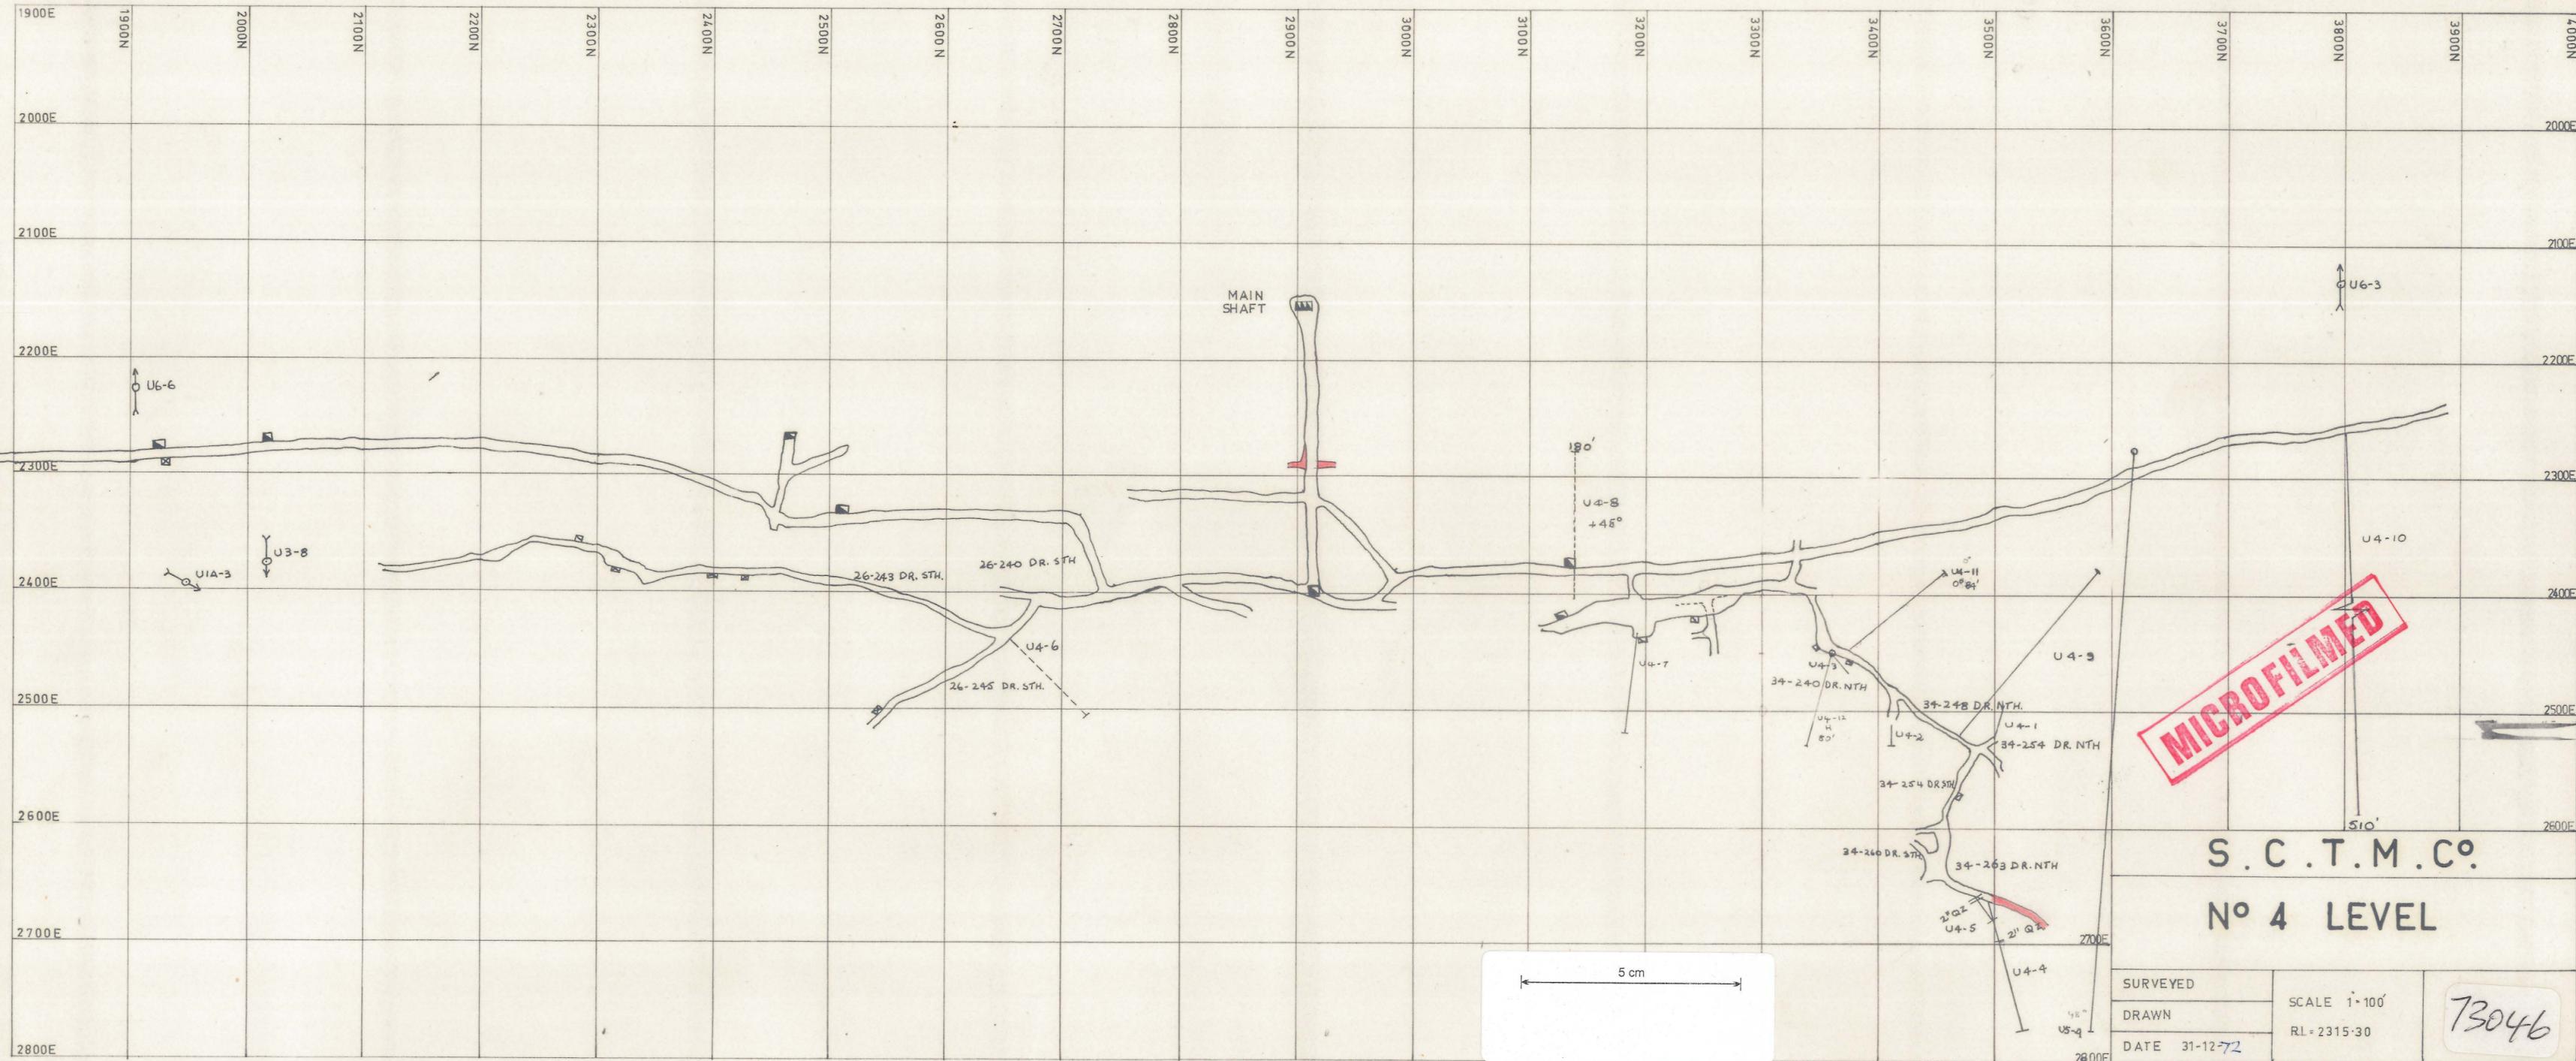

MICROFILMED

S.C.T.M.C.º
Nº 4 LEVEL

SURVEYED	SCALE 1:100'
DRAWN	RL = 2315.30
DATE 31-12-72	

73046

5 cm