


ABERF-716

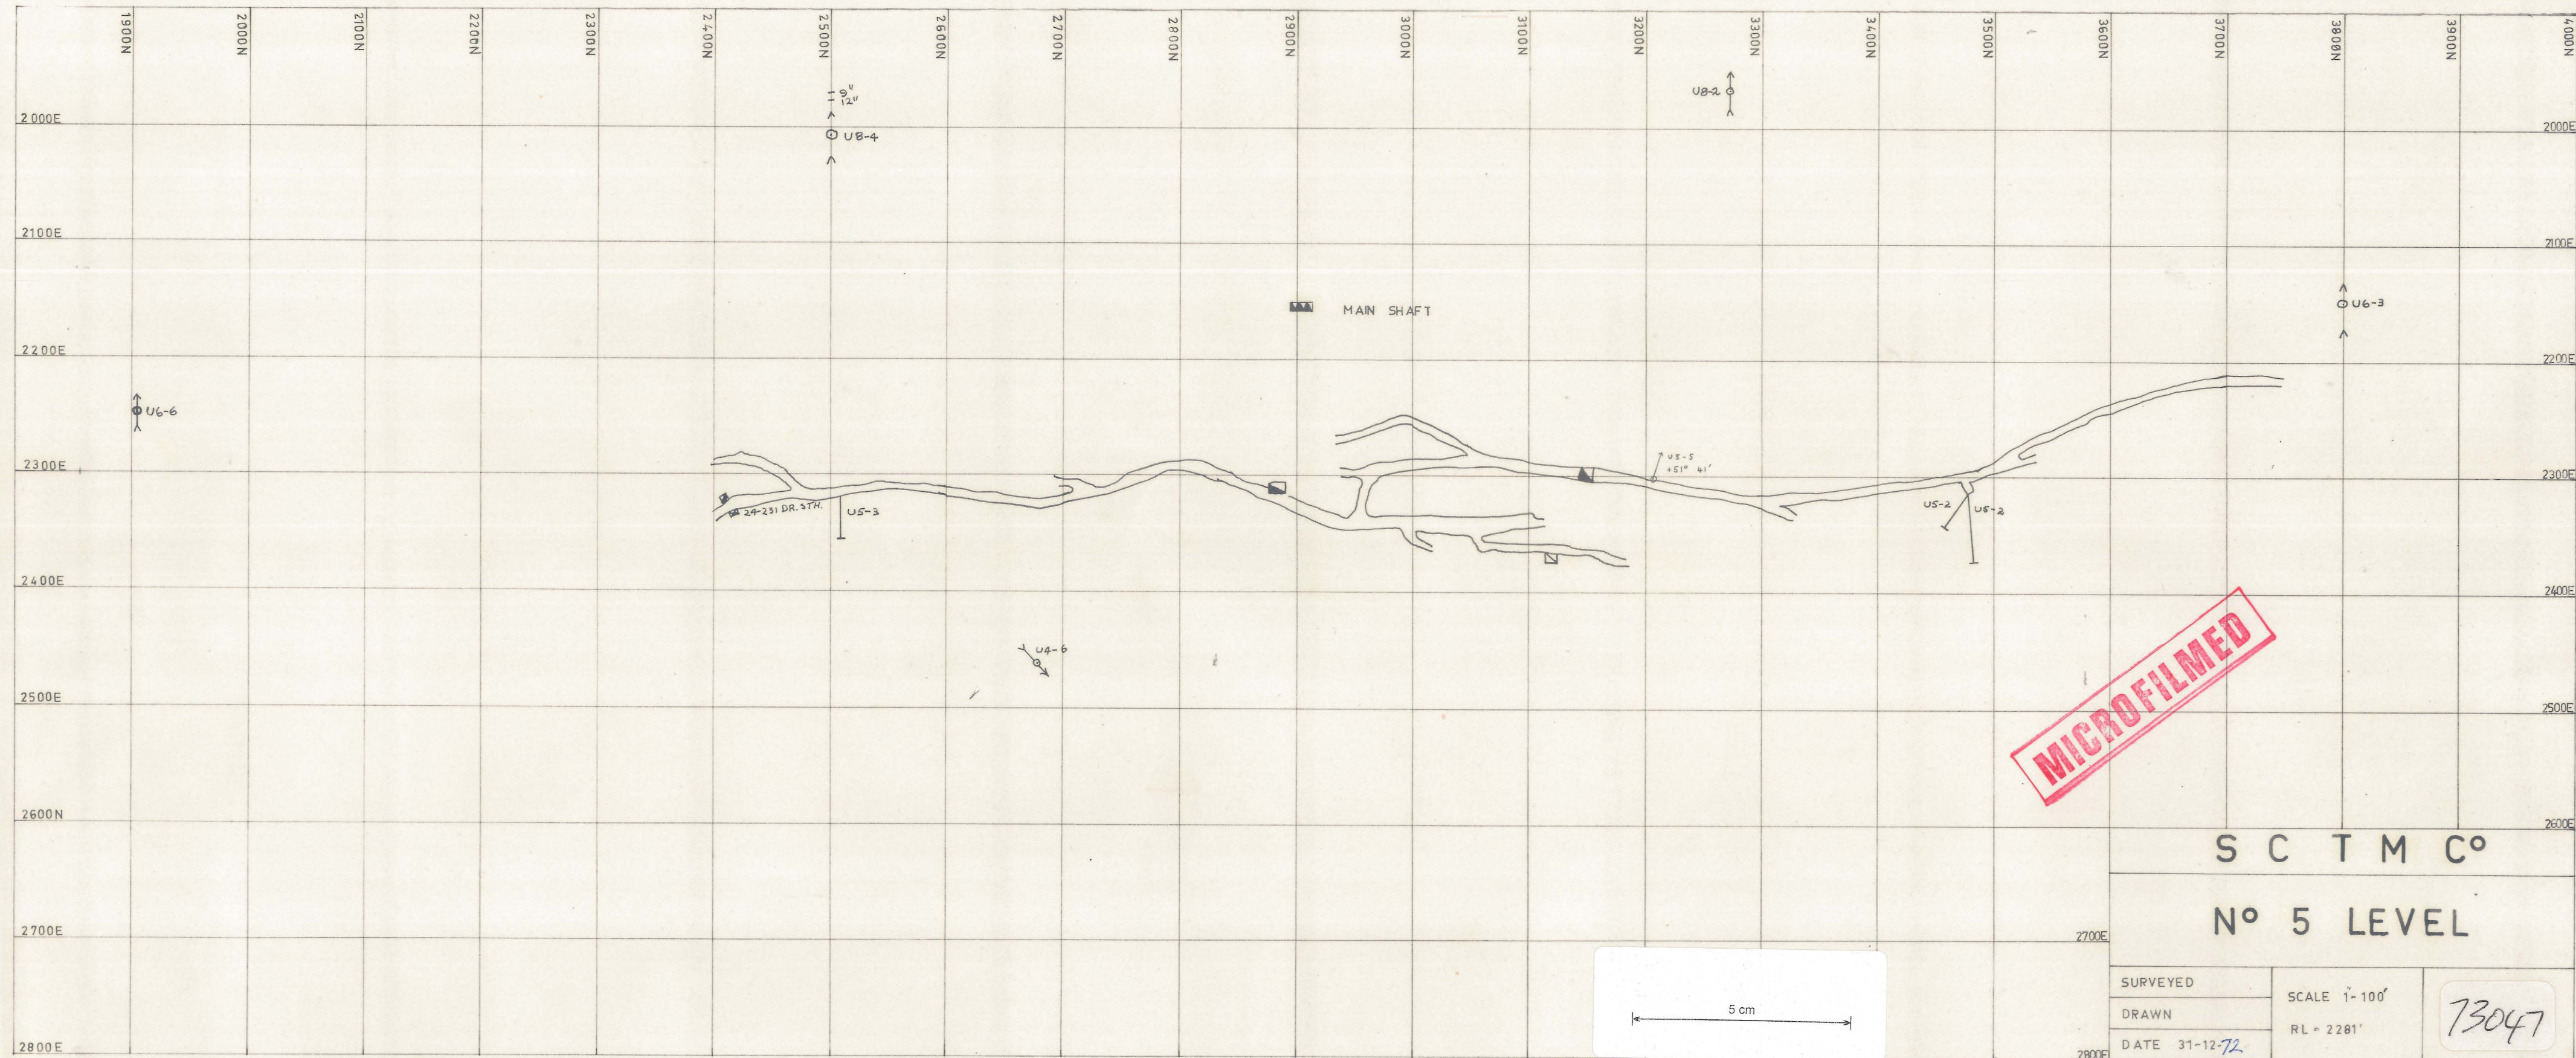

MICROFILMED

S C T M C°

No 5 LEVEL

SURVEYED

DRAWN

DATE 31-12-72

SCALE 1" = 100'

RL = 2281'

73047