



ABERF - 717

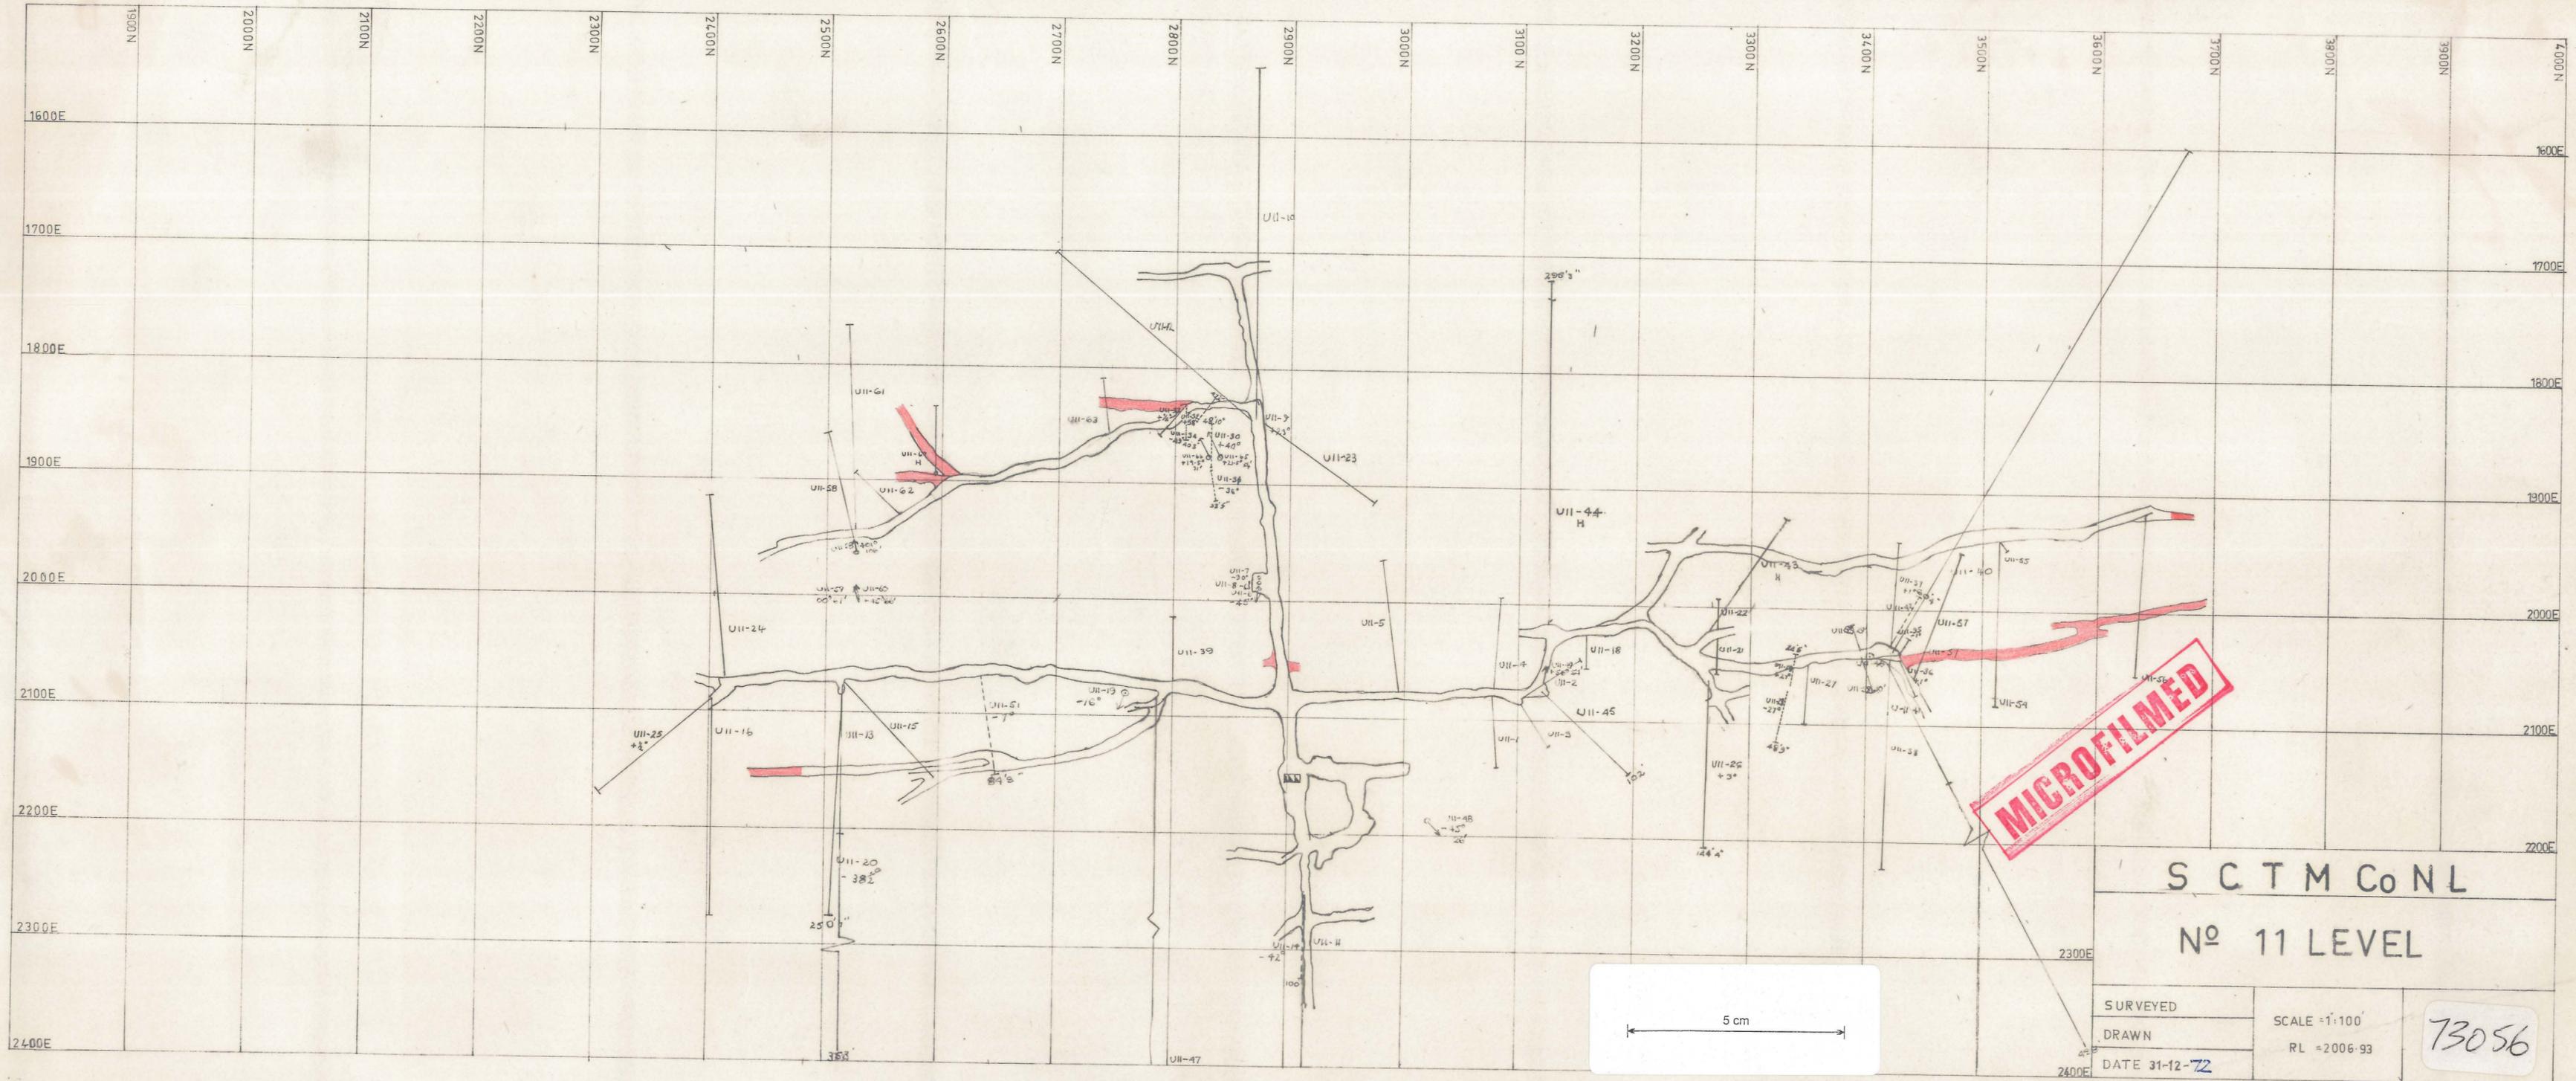

MICROFILMED

S C T M Co NL
No 11 LEVEL

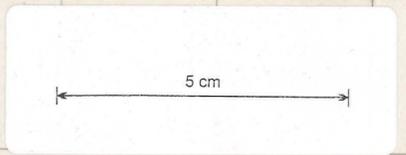

SURVEYED	SCALE = 1:100 RL = 2006.93	73056
DRAWN		
DATE 31-12-72		