


ABERF-718

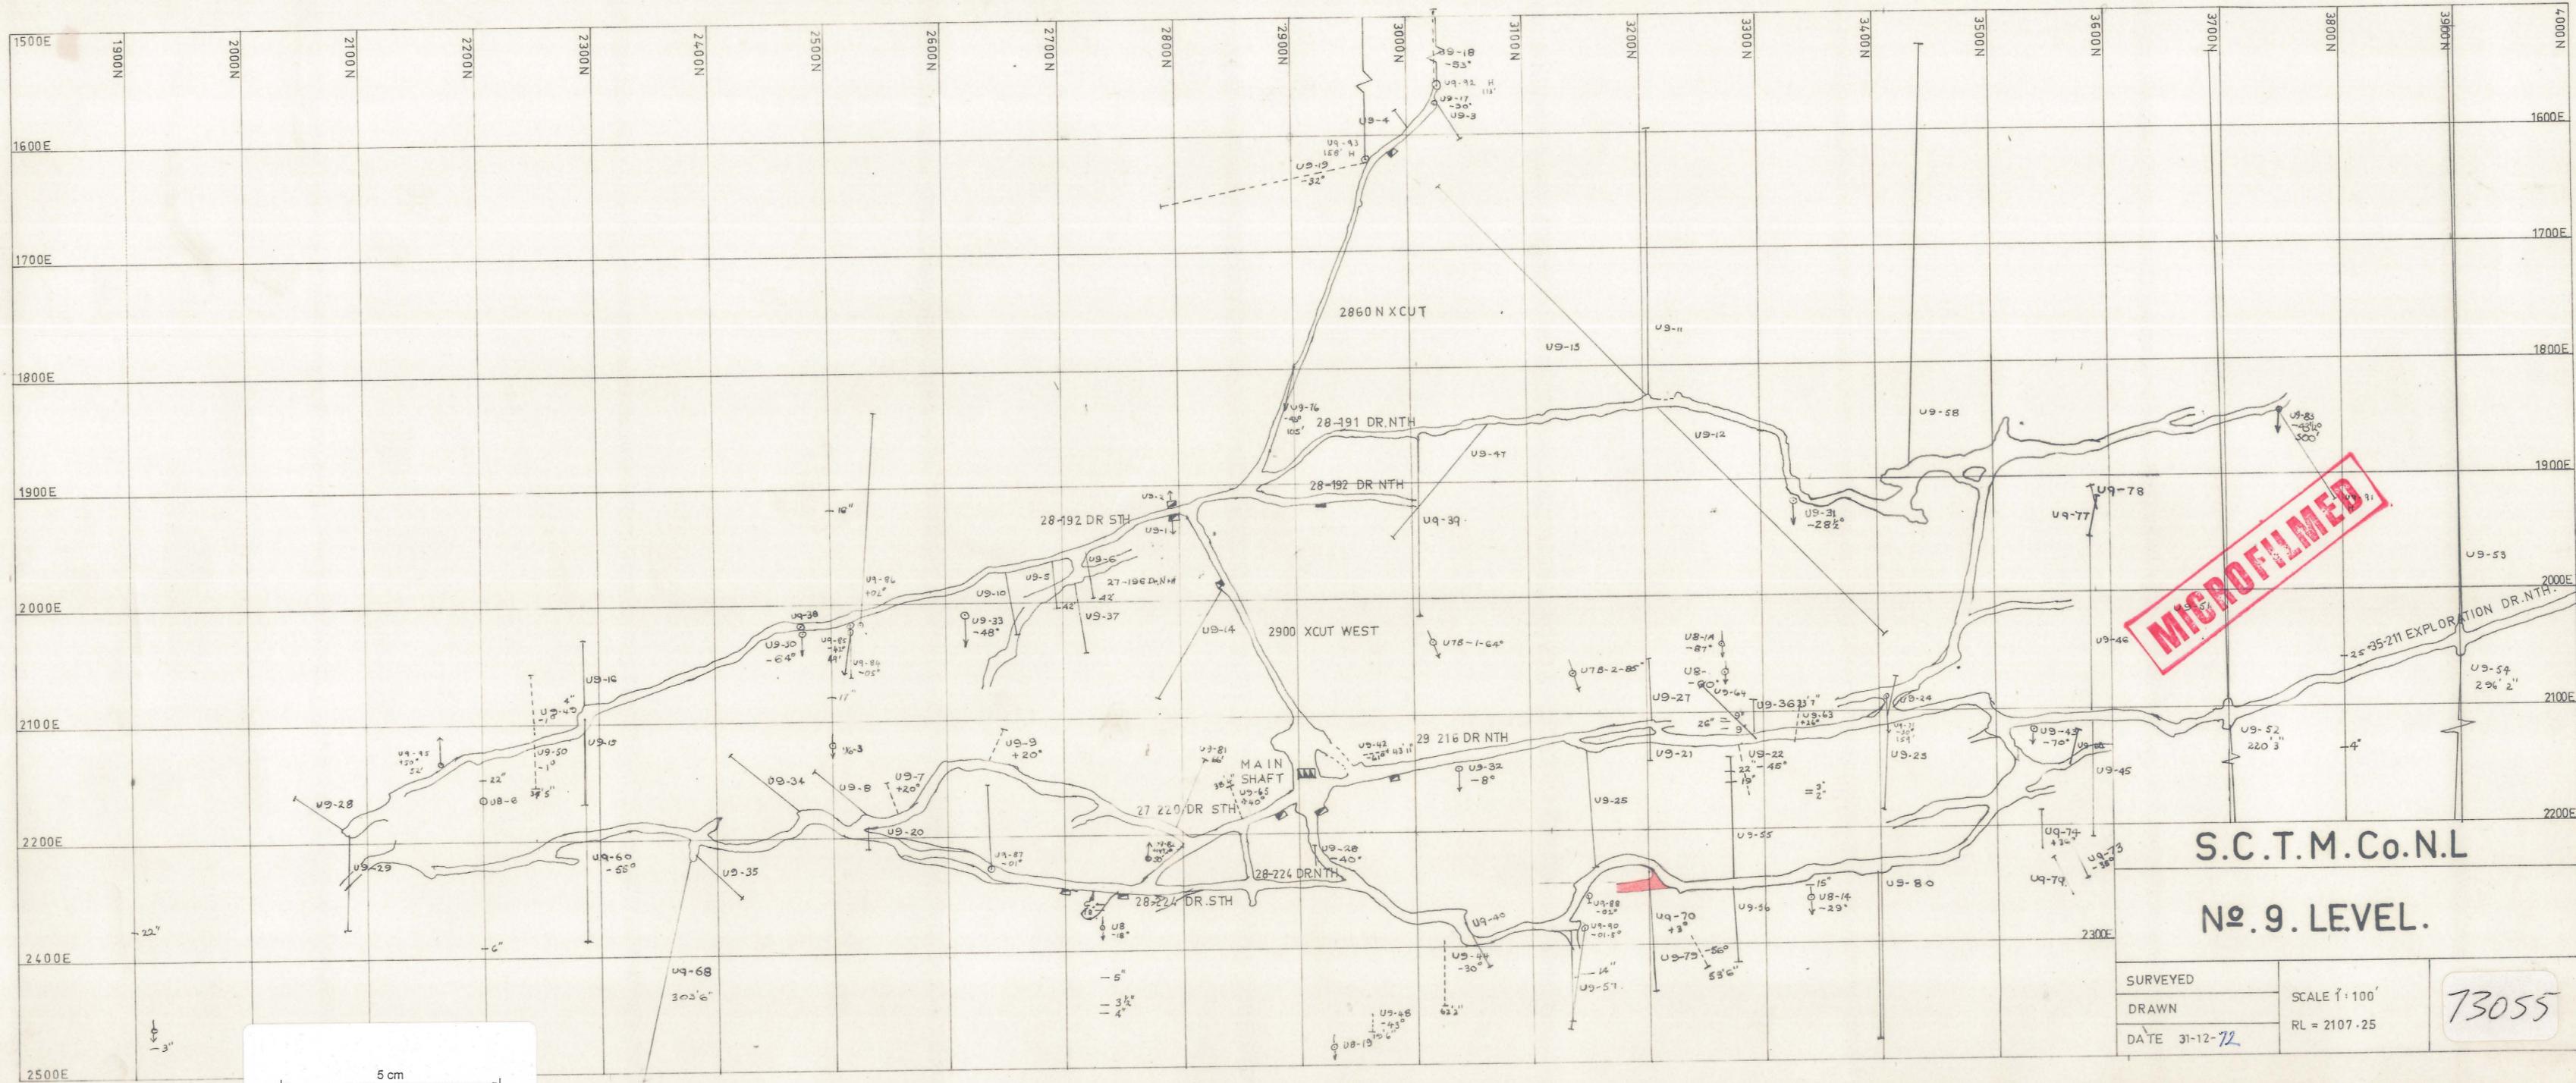

MICROFILMED

S.C.T.M. Co. N.L.
No. 9. LEVEL.

SURVEYED	SCALE 1" = 100' RL = 2107.25	73055
DRAWN		
DATE 31-12-72		

