



ABERF-720

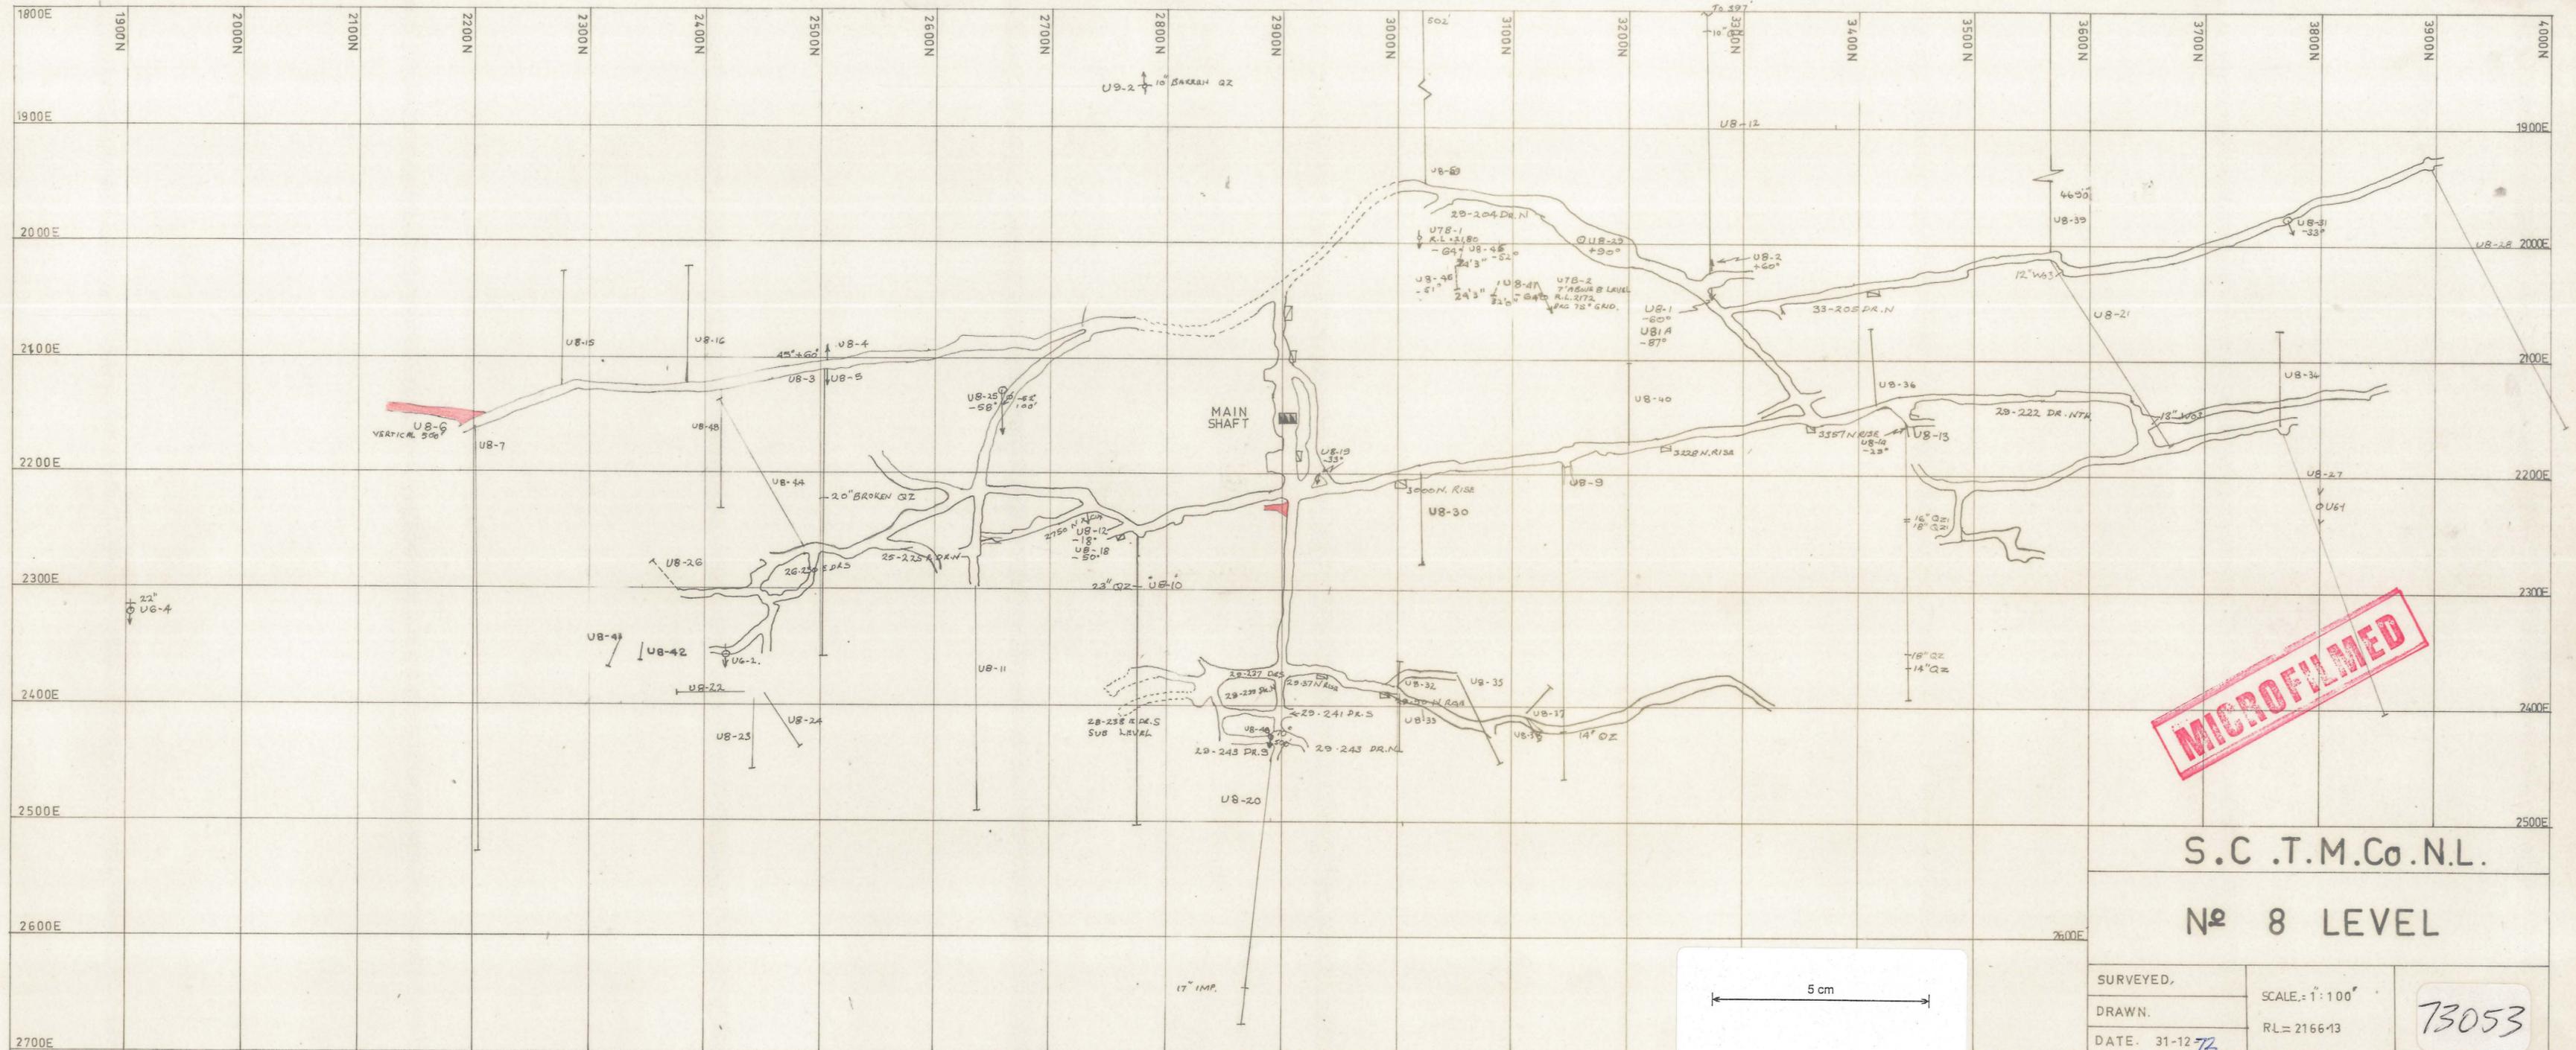

MICROFILMED

S.C.T.M.Co.N.L.

No 8 LEVEL

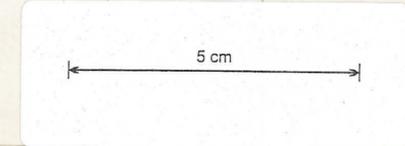

SURVEYED,	SCALE: 1" = 100' RL = 2166.13	73053
DRAWN,		
DATE: 31-12-72		