


NBENF-721

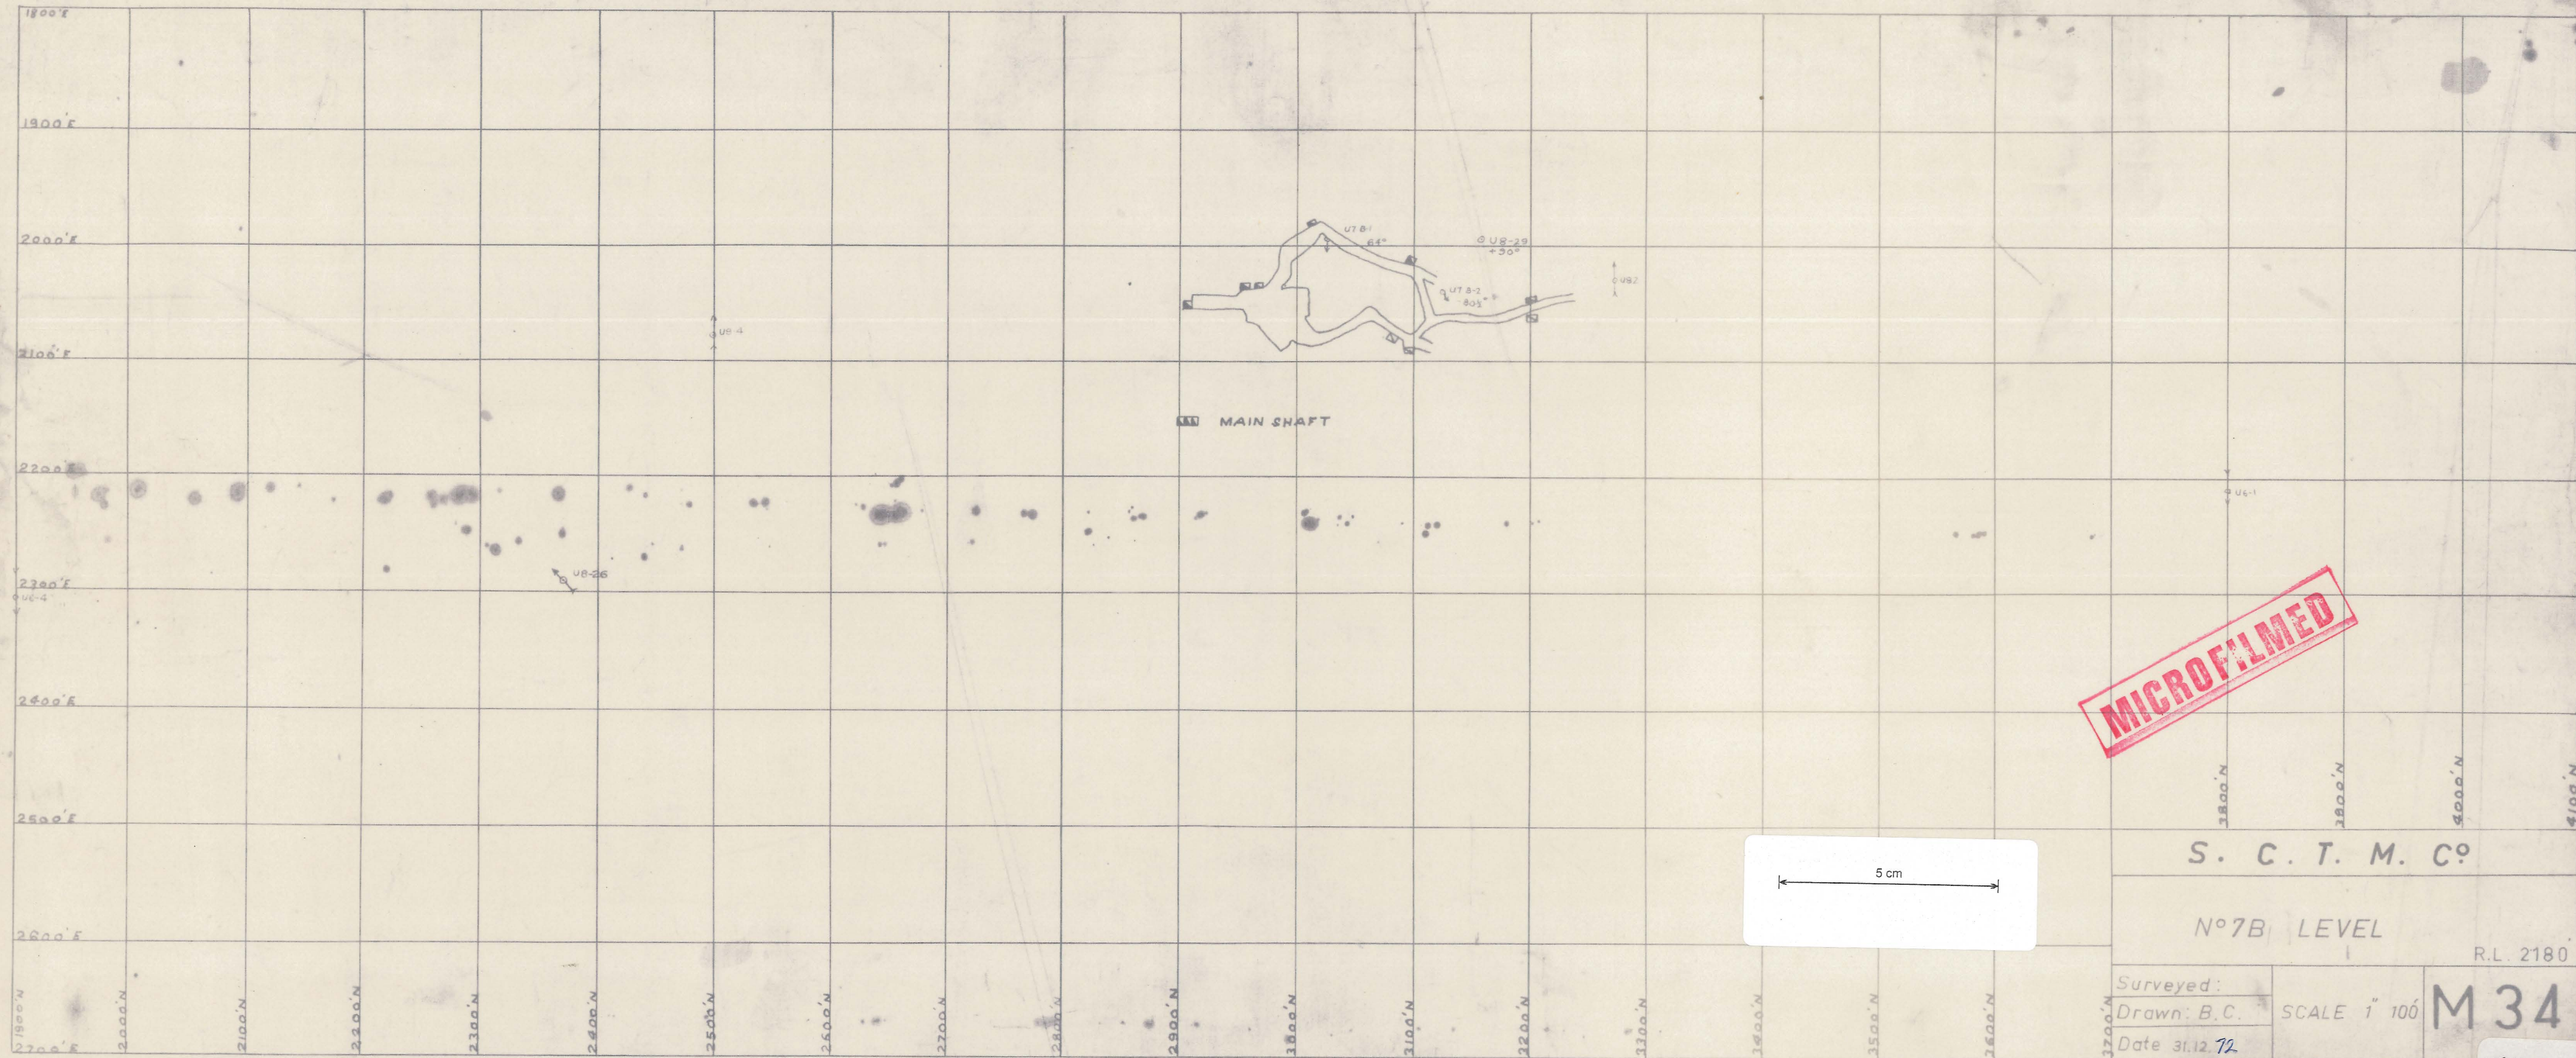

MICROFILMED

5 cm

S. C. T. M. CO.

N°7B LEVEL

R.L. 2180

Surveyed:
Drawn: B.C.
Date 31.12.72

SCALE 1" 100'

M 34

73052