


ABERF-722

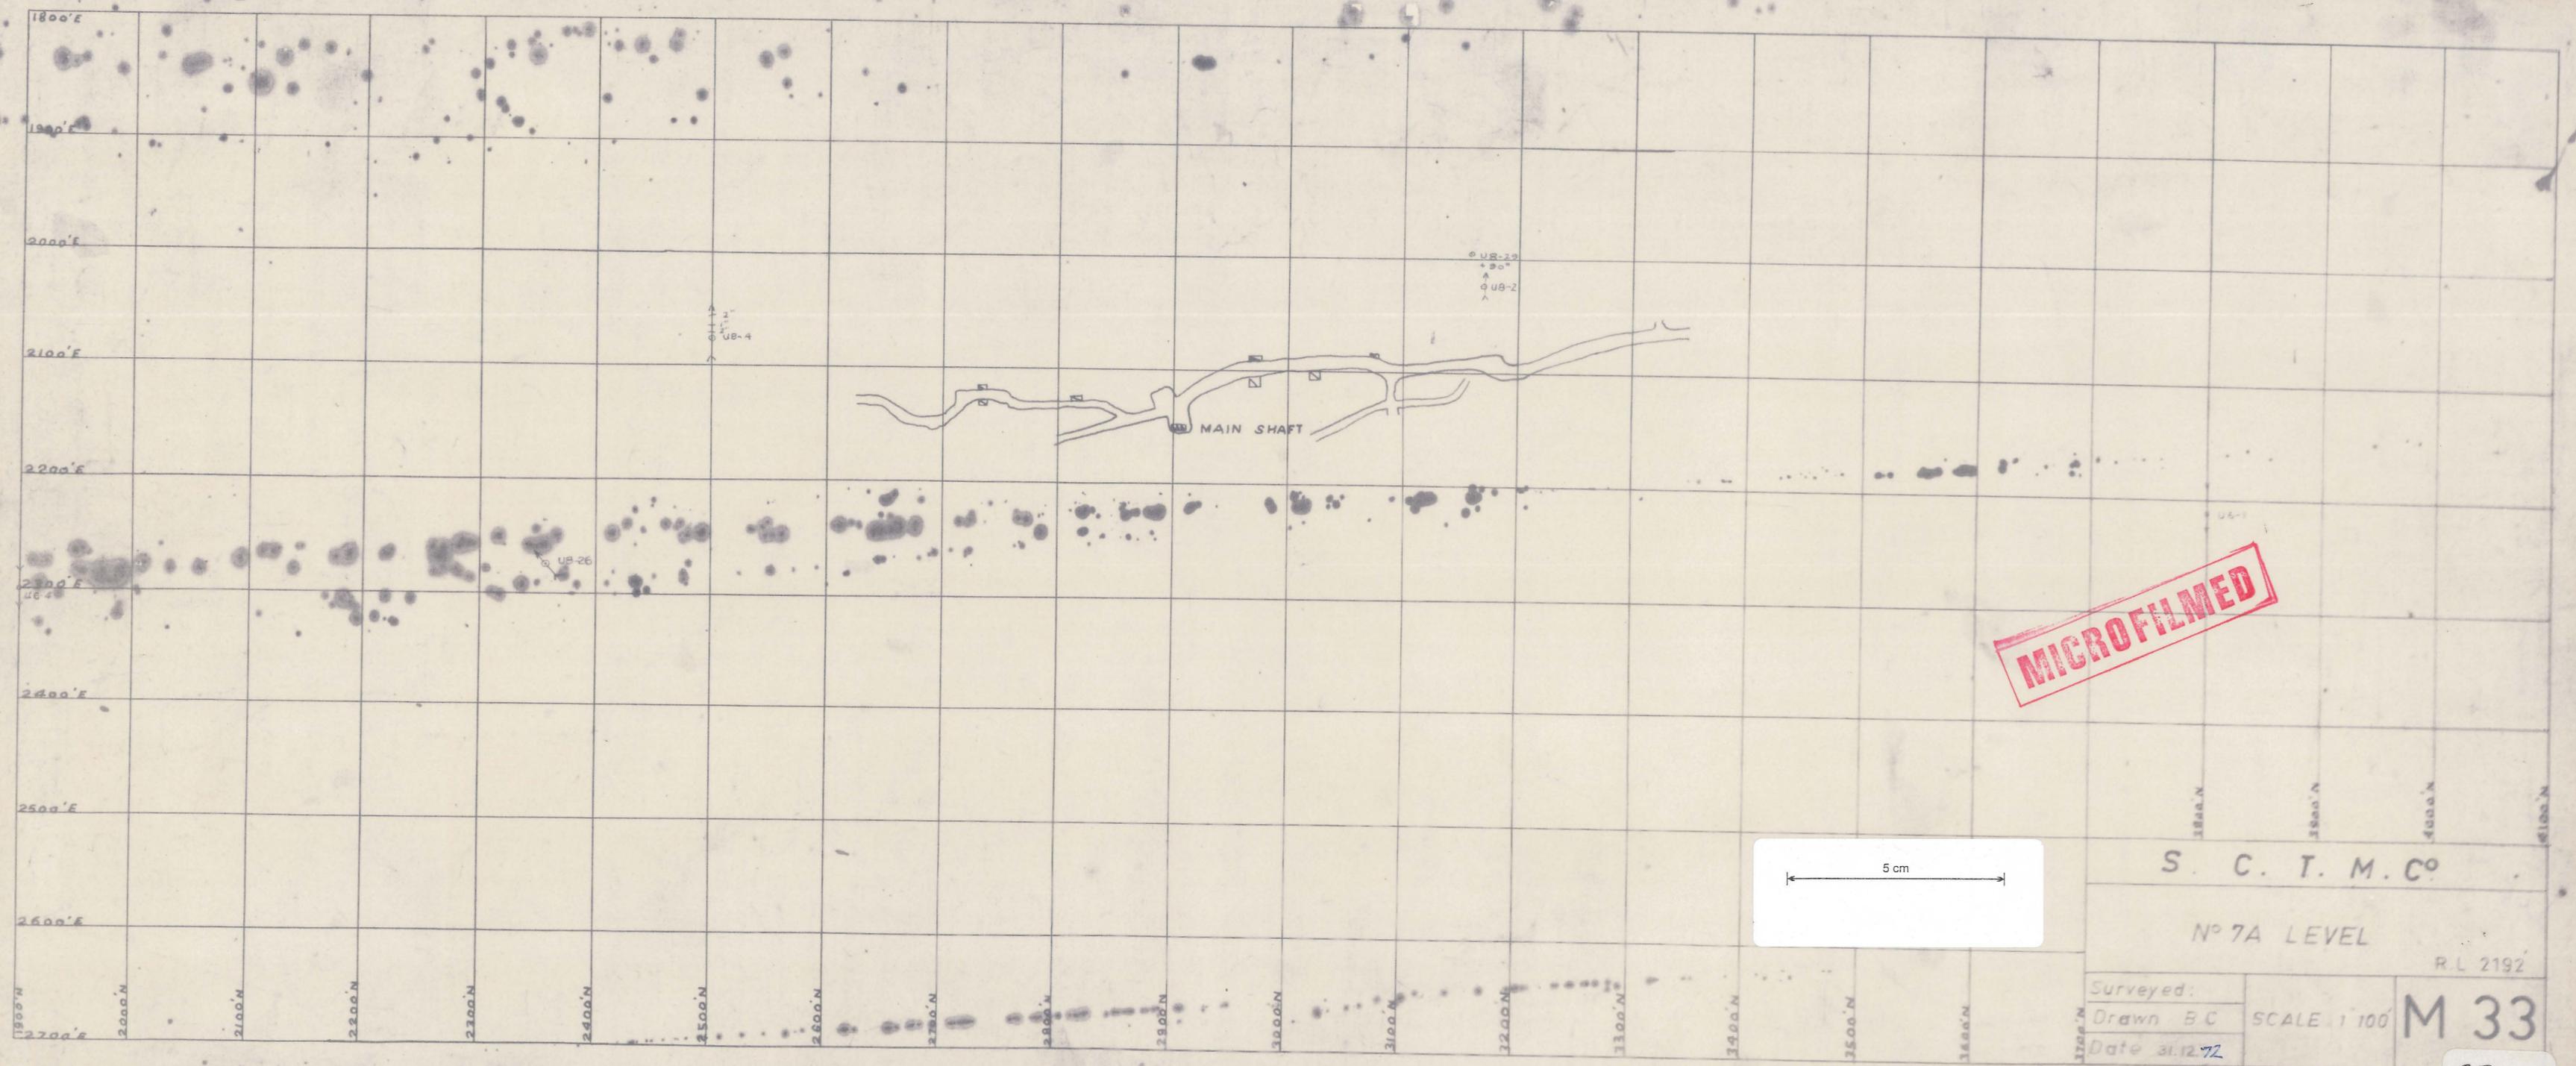

MICROFILMED

5 cm

S. C. T. M. C^o
 N° 7A LEVEL
 R.L. 2192
 Surveyed:
 Drawn B.C.
 Date 31.12.72
 SCALE 1"=100'
 M 33

73051