



ABERF-723

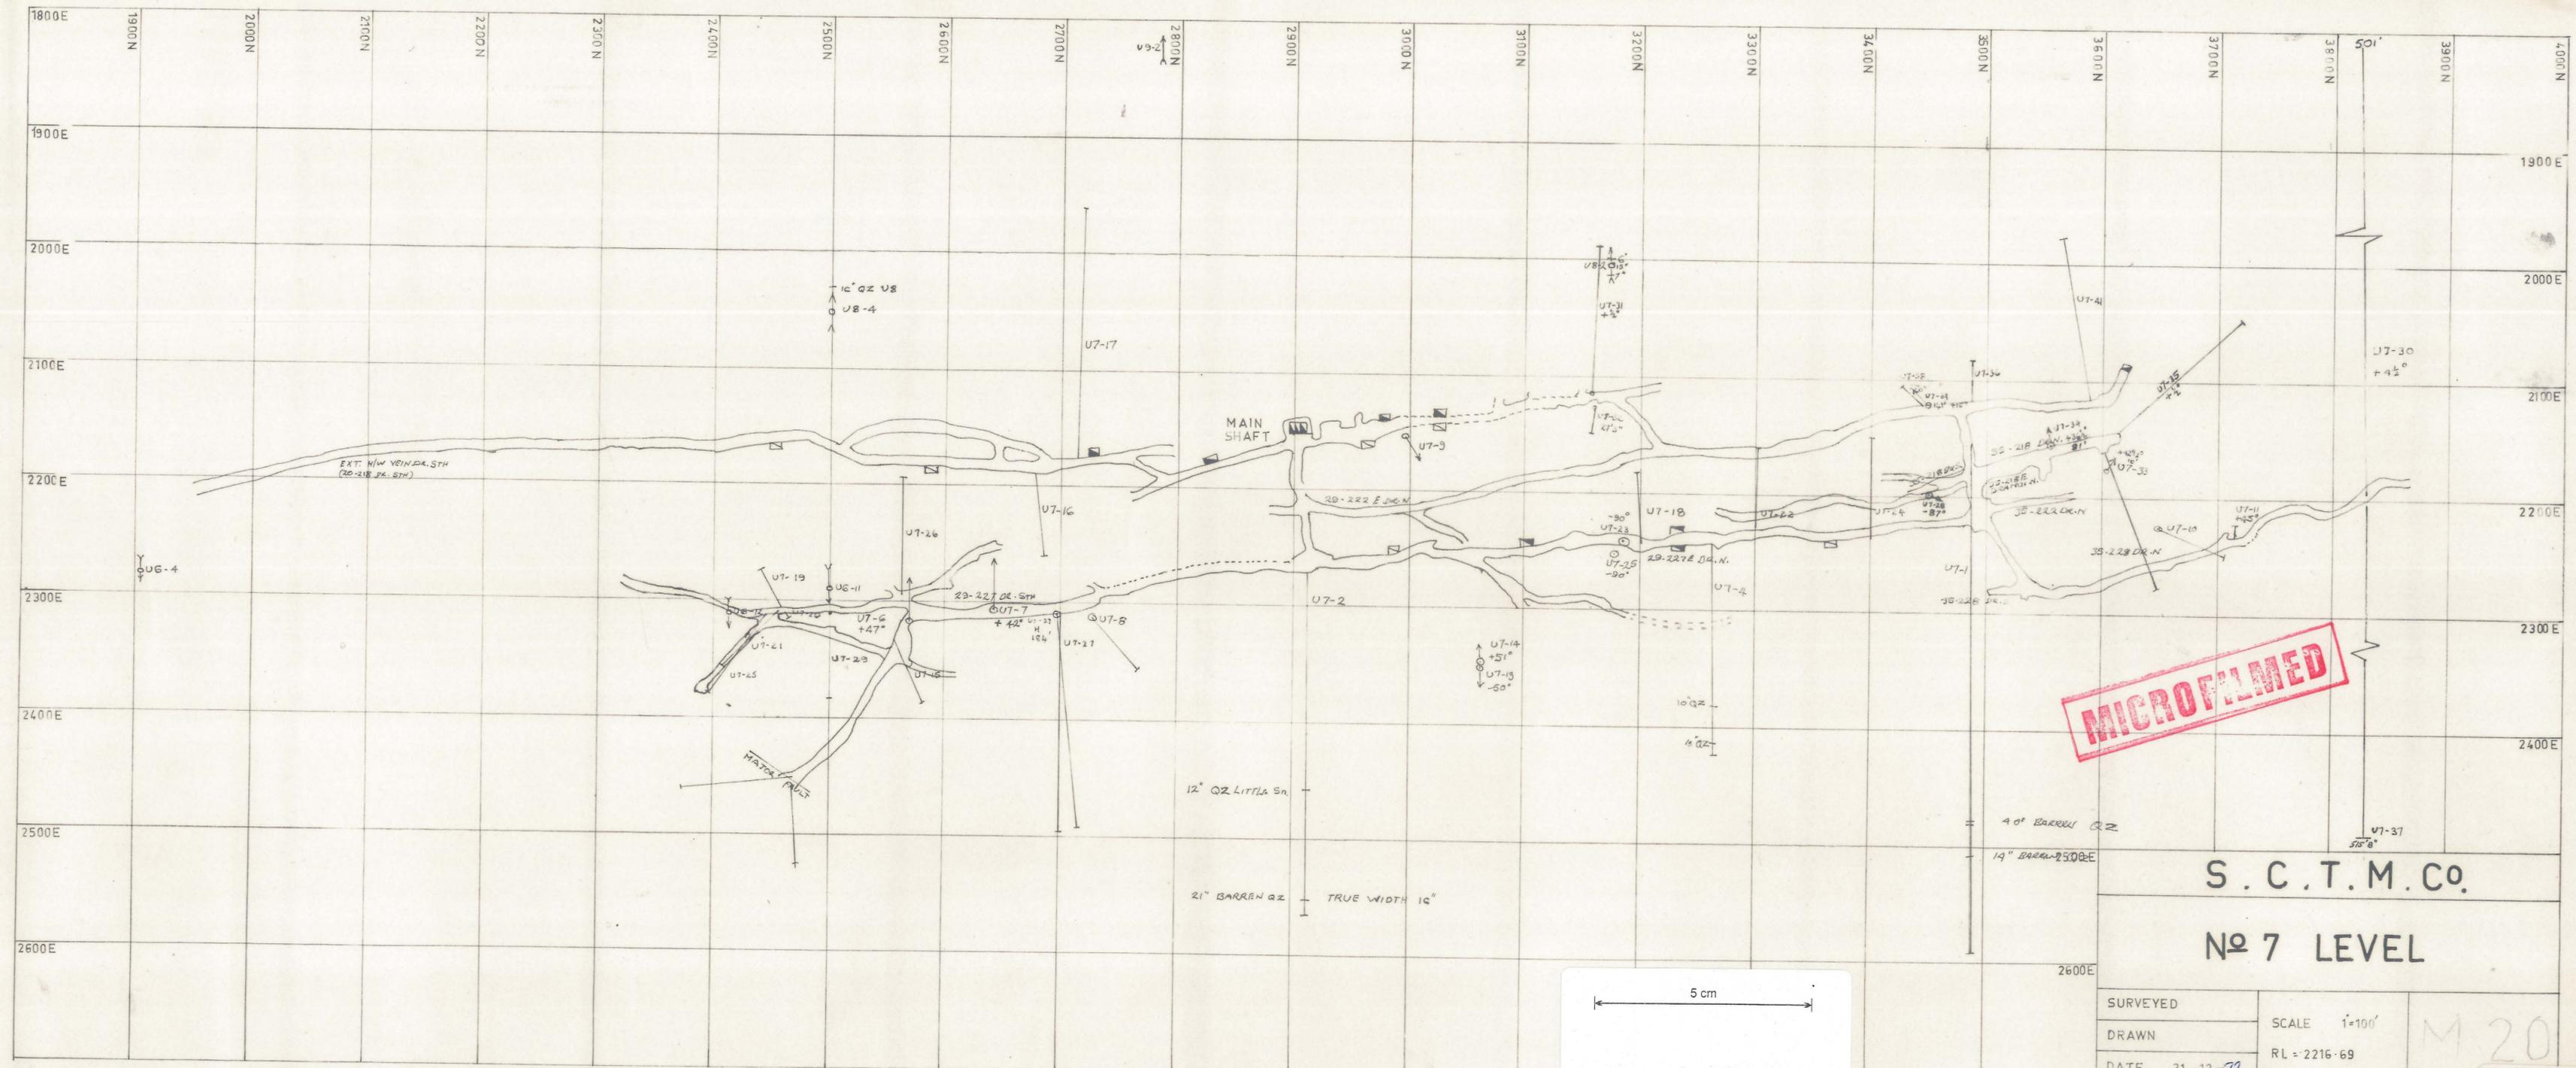

MICROFILMED

S. C. T. M. CO.
No 7 LEVEL

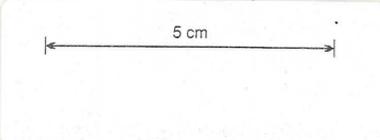

SURVEYED	SCALE 1"=100'
DRAWN	RL = 2216.69
DATE 31-12-72	

M 20
73050