


ABEAR-224

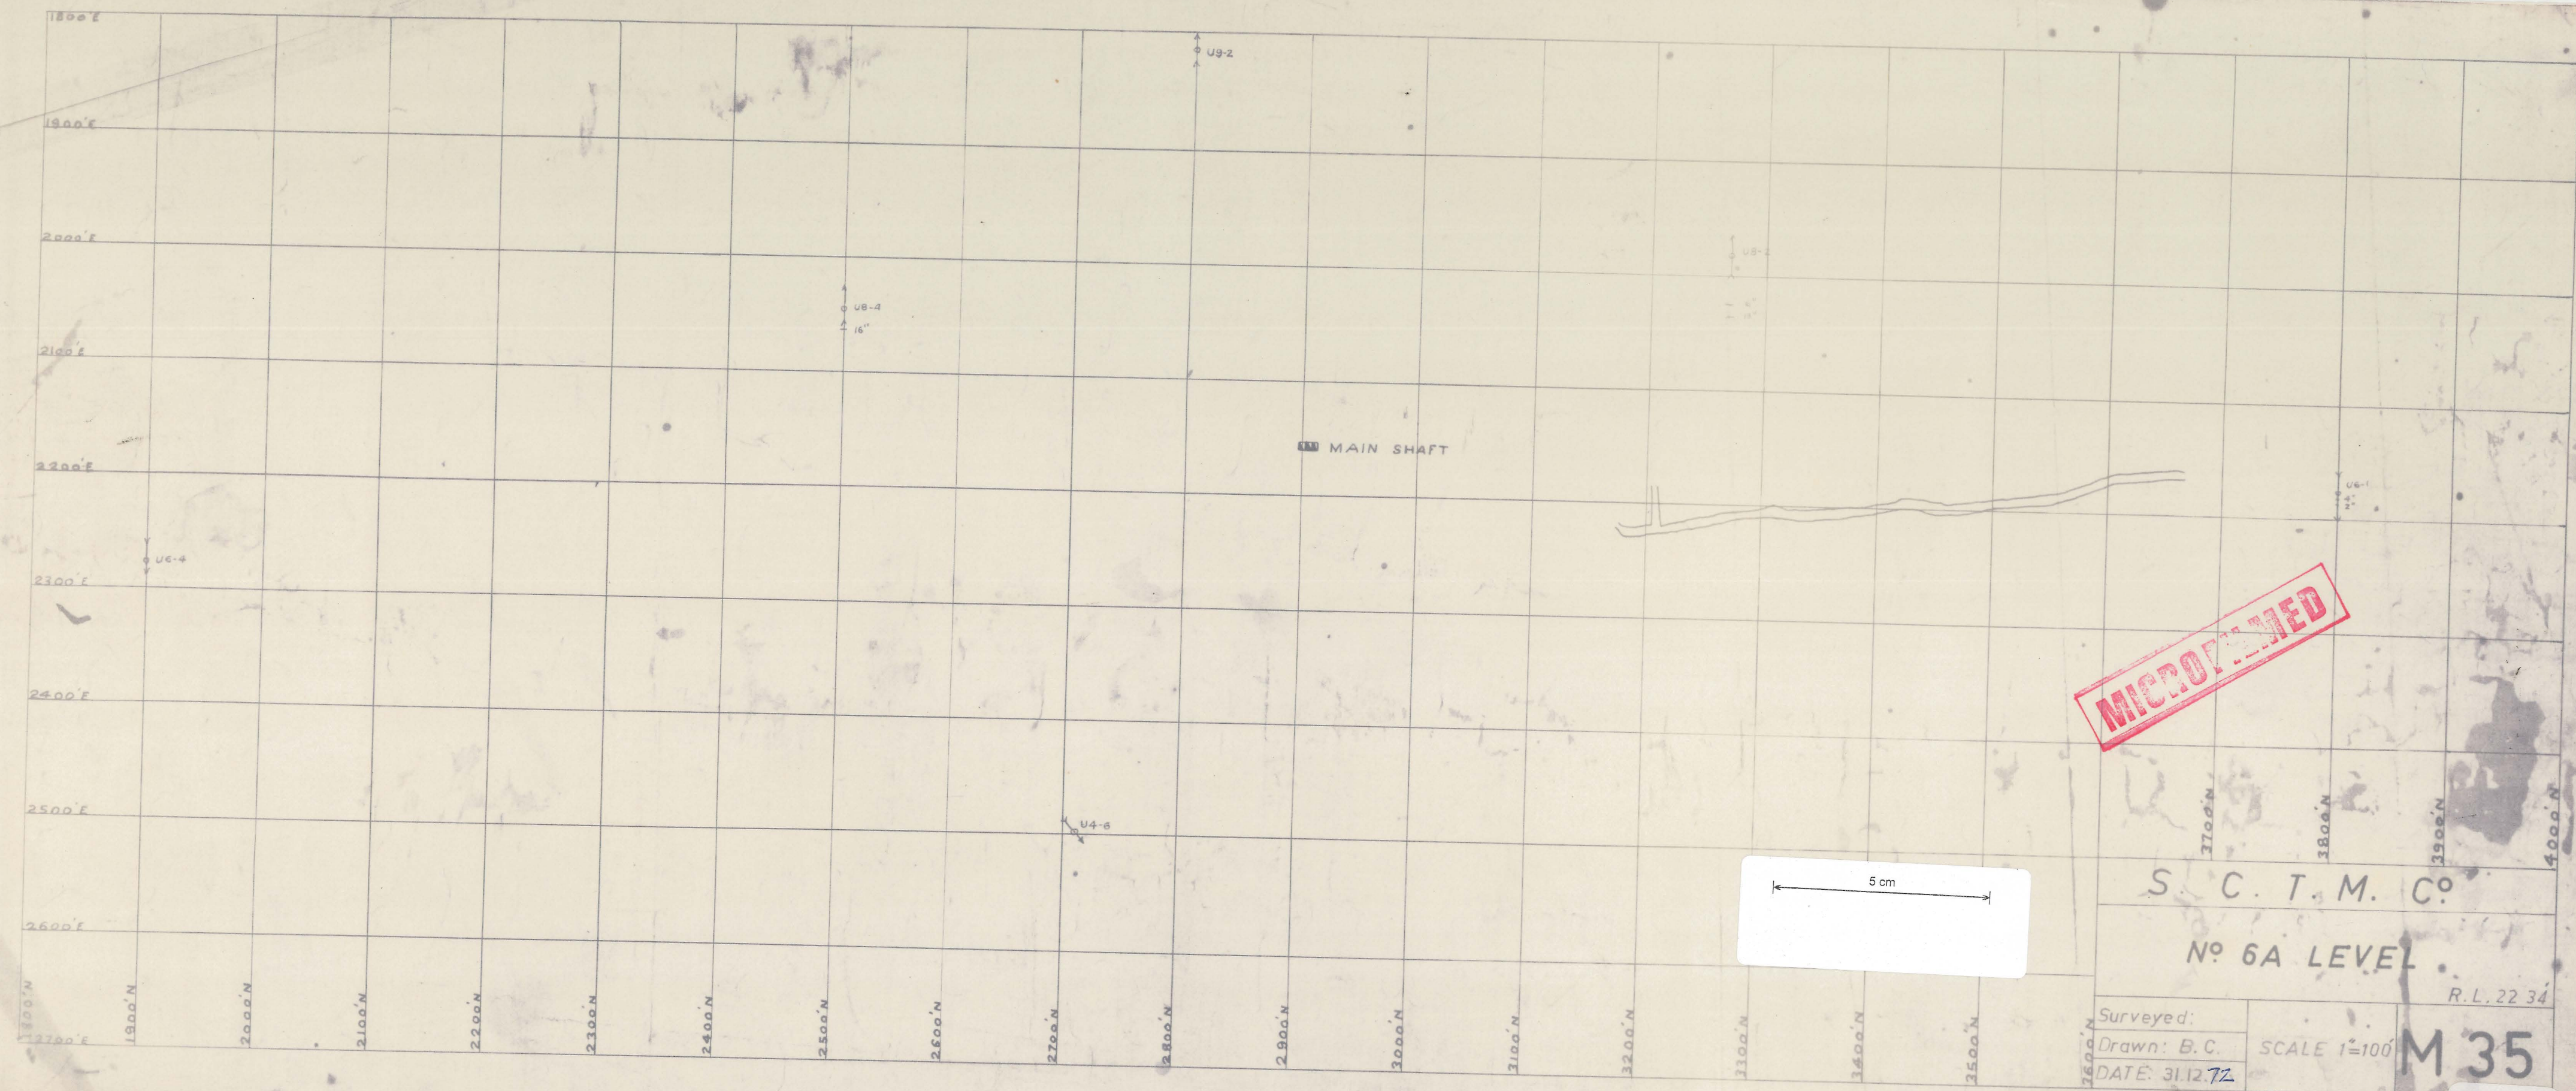

MICROFILMED

5 cm

S. C. T. M. CO.
No 6A LEVEL
R.L. 22 34
Surveyed:
Drawn: B.C.
DATE: 31.12.72
SCALE 1"=100'
M 35

73049