



ABERF-725

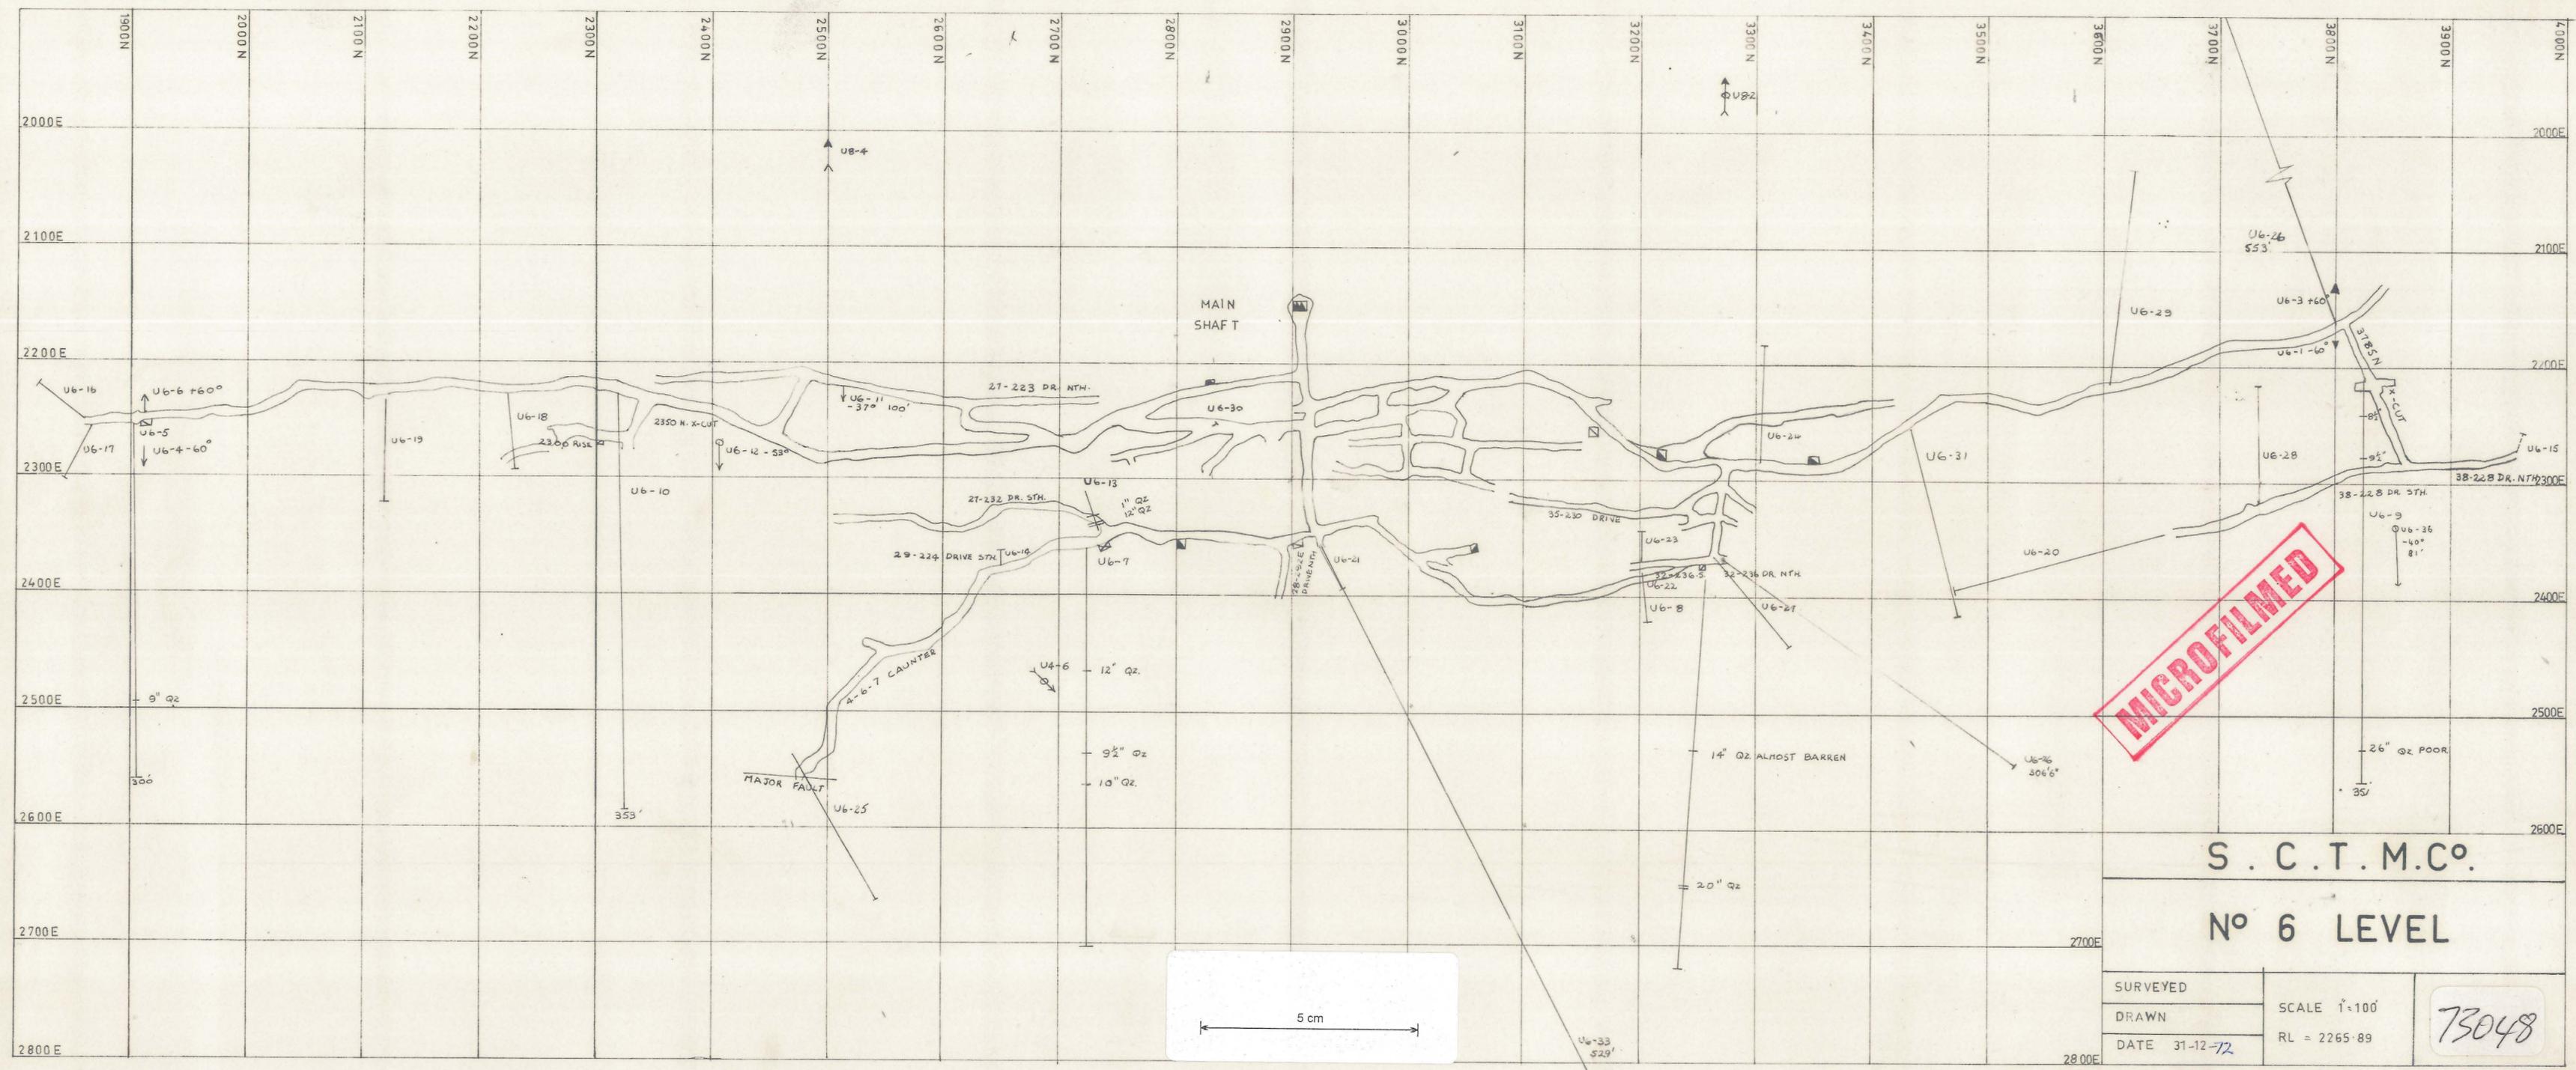

MICROFILMED

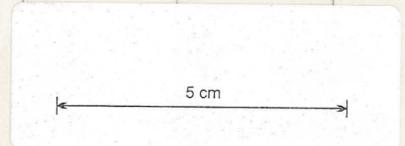

S. C. T. M. C. O.

No 6 LEVEL

SURVEYED	SCALE 1"=100' RL = 2265.89	73048
DRAWN		
DATE 31-12-72		