


ABERF\_732

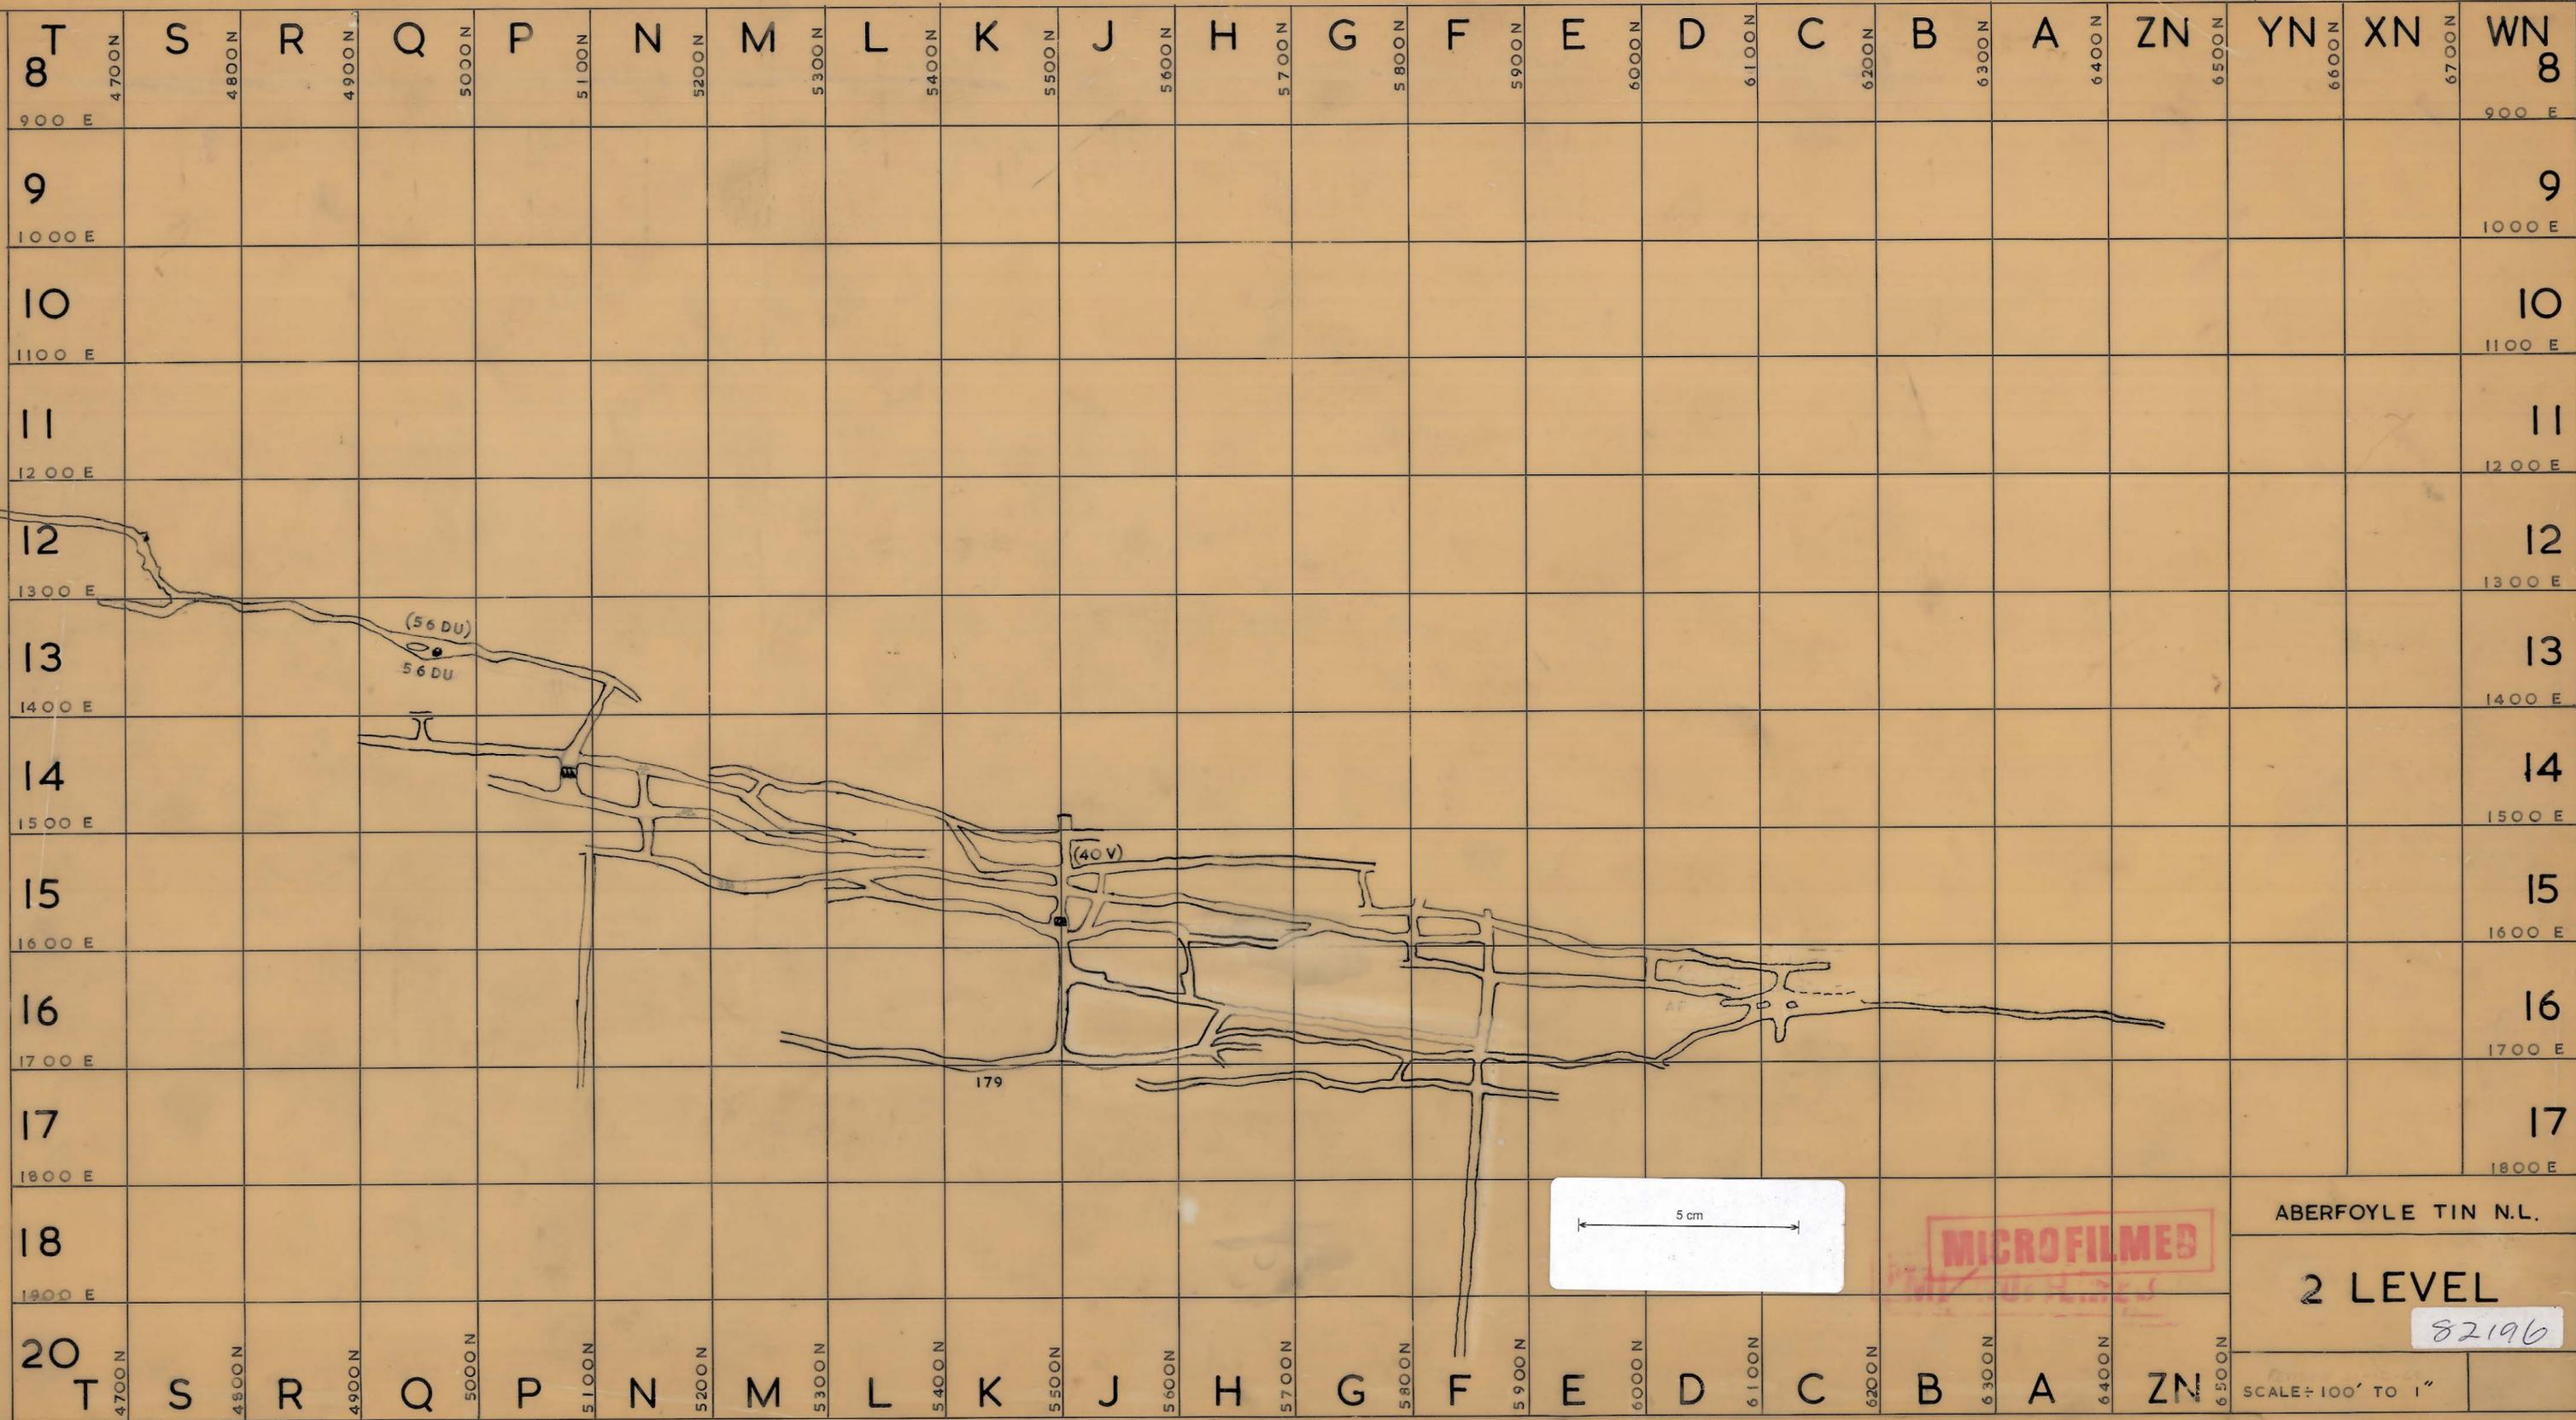

ABERFOYLE TIN N.L.

2 LEVEL

82196

SCALE: 100' TO 1"